

RETRACEMENT SURVEY

MONROE TOWNSHIP
2ND. QTR., LOT 20
T-9 N; R-8 W
HOLMES COUNTY, OHIO



SURVEYED FOR: BEN HIPPI

REFERENCES

DEED VOL. 138 PAGE 313
DEED VOL. 219 PAGE 873
O.R. VOL. 46 PAGE 596
O.R. VOL. 58 PAGE 236
O.R. VOL. 214 PAGE 2258

PLAT VOL. 10 PAGE 110
PLAT VOL. 17 PAGE 108

BEARINGS ASSUMED

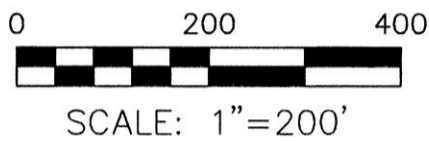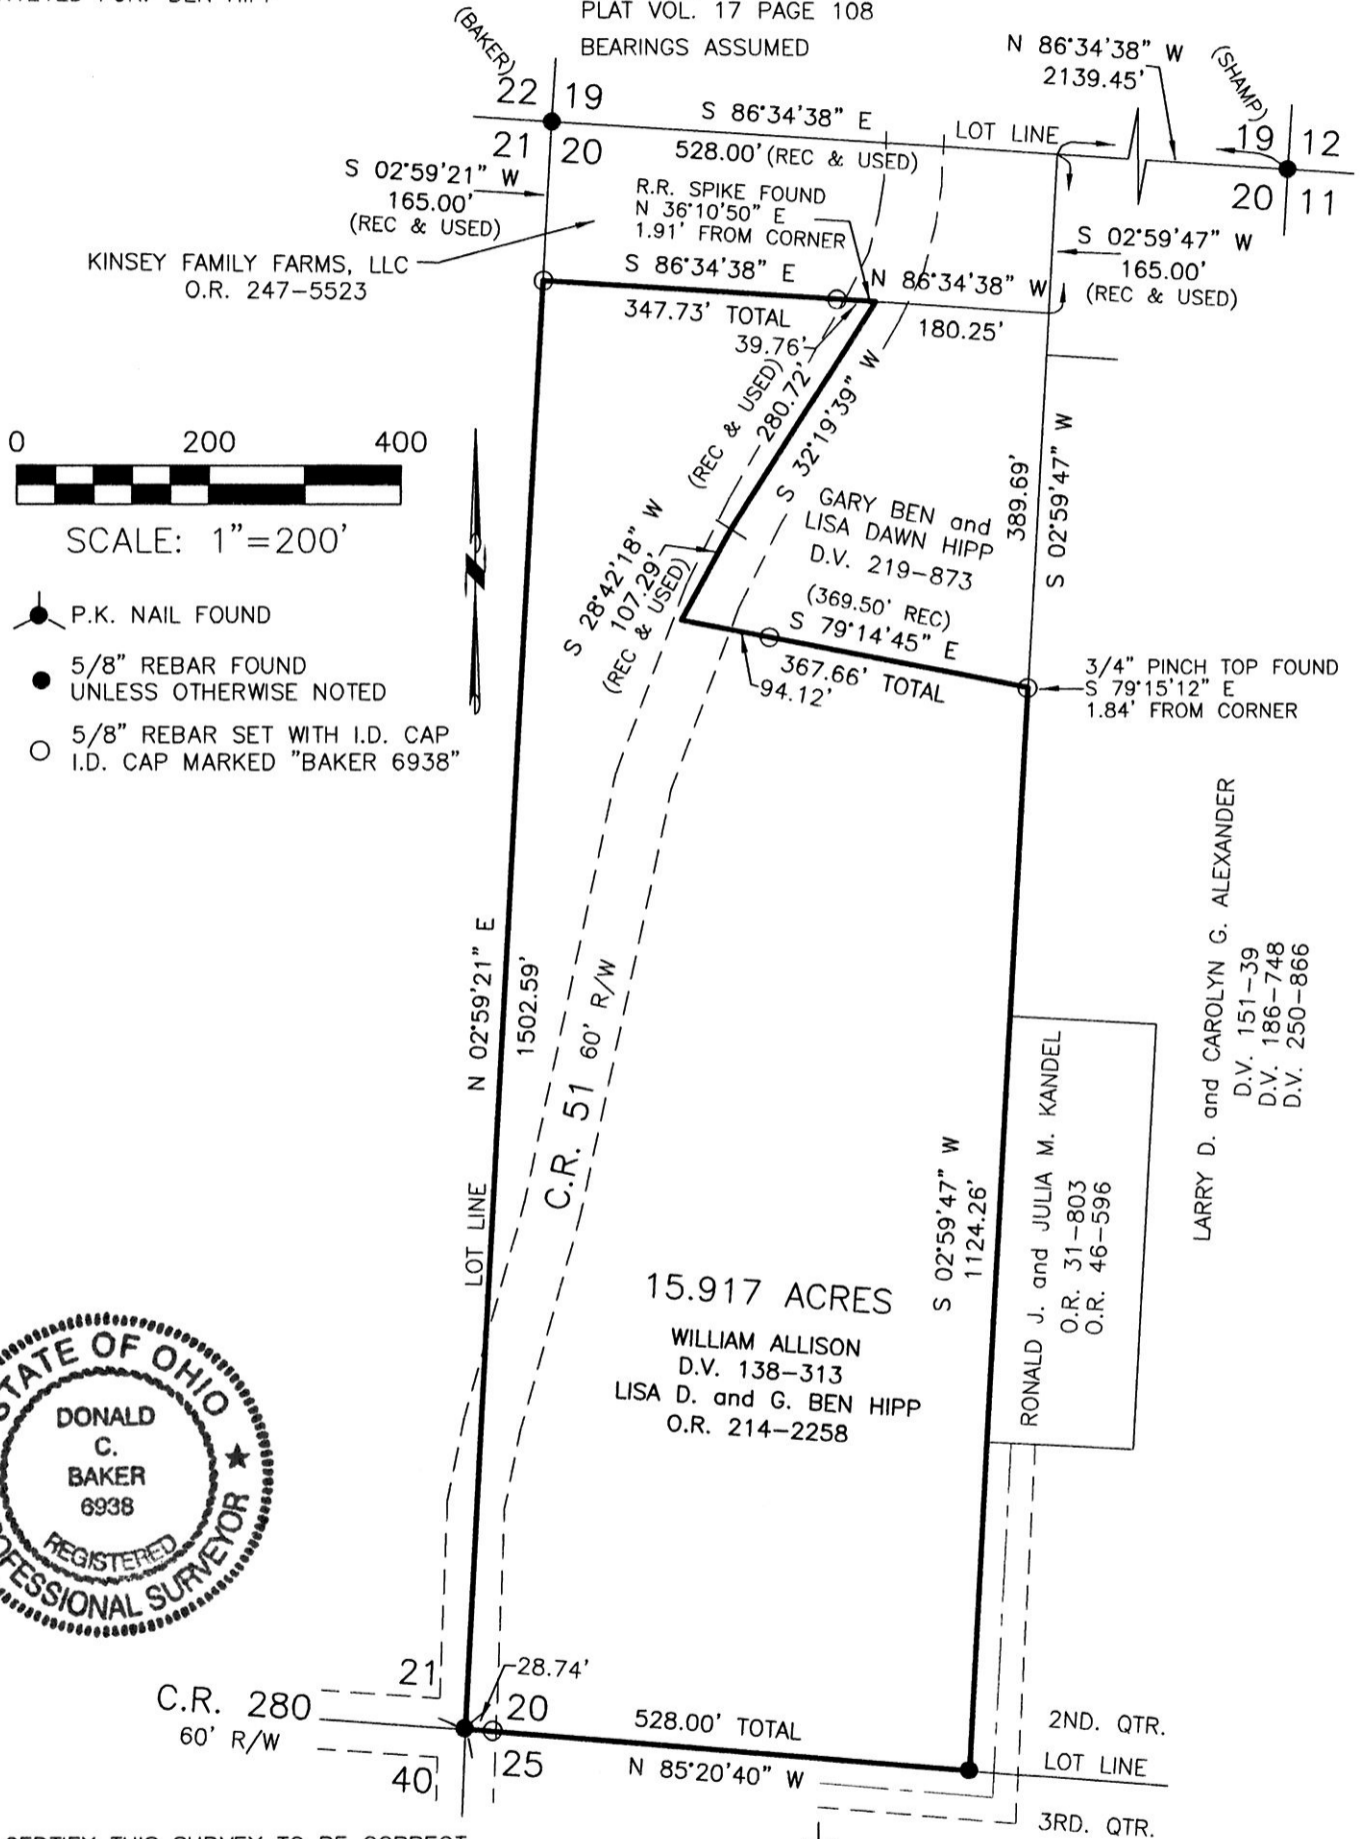

- P.K. NAIL FOUND
- 5/8" REBAR FOUND UNLESS OTHERWISE NOTED
- 5/8" REBAR SET WITH I.D. CAP I.D. CAP MARKED "BAKER 6938"



I CERTIFY THIS SURVEY TO BE CORRECT TO THE BEST OF MY KNOWLEDGE.

Donald C. Baker
DONALD C. BAKER P.S. 6938
DATE: DEC. 15, 2009
JDD\KES
FILE NAME: WORK3\S-587-09\ERZ

REVISED: DEC 3, 2014



DONALD C. BAKER SURVEYING
138 N. CLAY STREET
MILLERSBURG, OHIO 44654
PH. 330-674-4788
FAX 330-674-6027

APPROVED FOR TRANSFER ONLY
NO SUBDIVISION PLAT REQUIRED

(O.R.C. 711.001 & 711.131)
Lot(s) not for building unless approved by Board of Health.

HOLMES CO. PLANNING COMMISSION

By: *[Signature]* Date: 12-11-14

PLAT APPROVED

12/10/2014