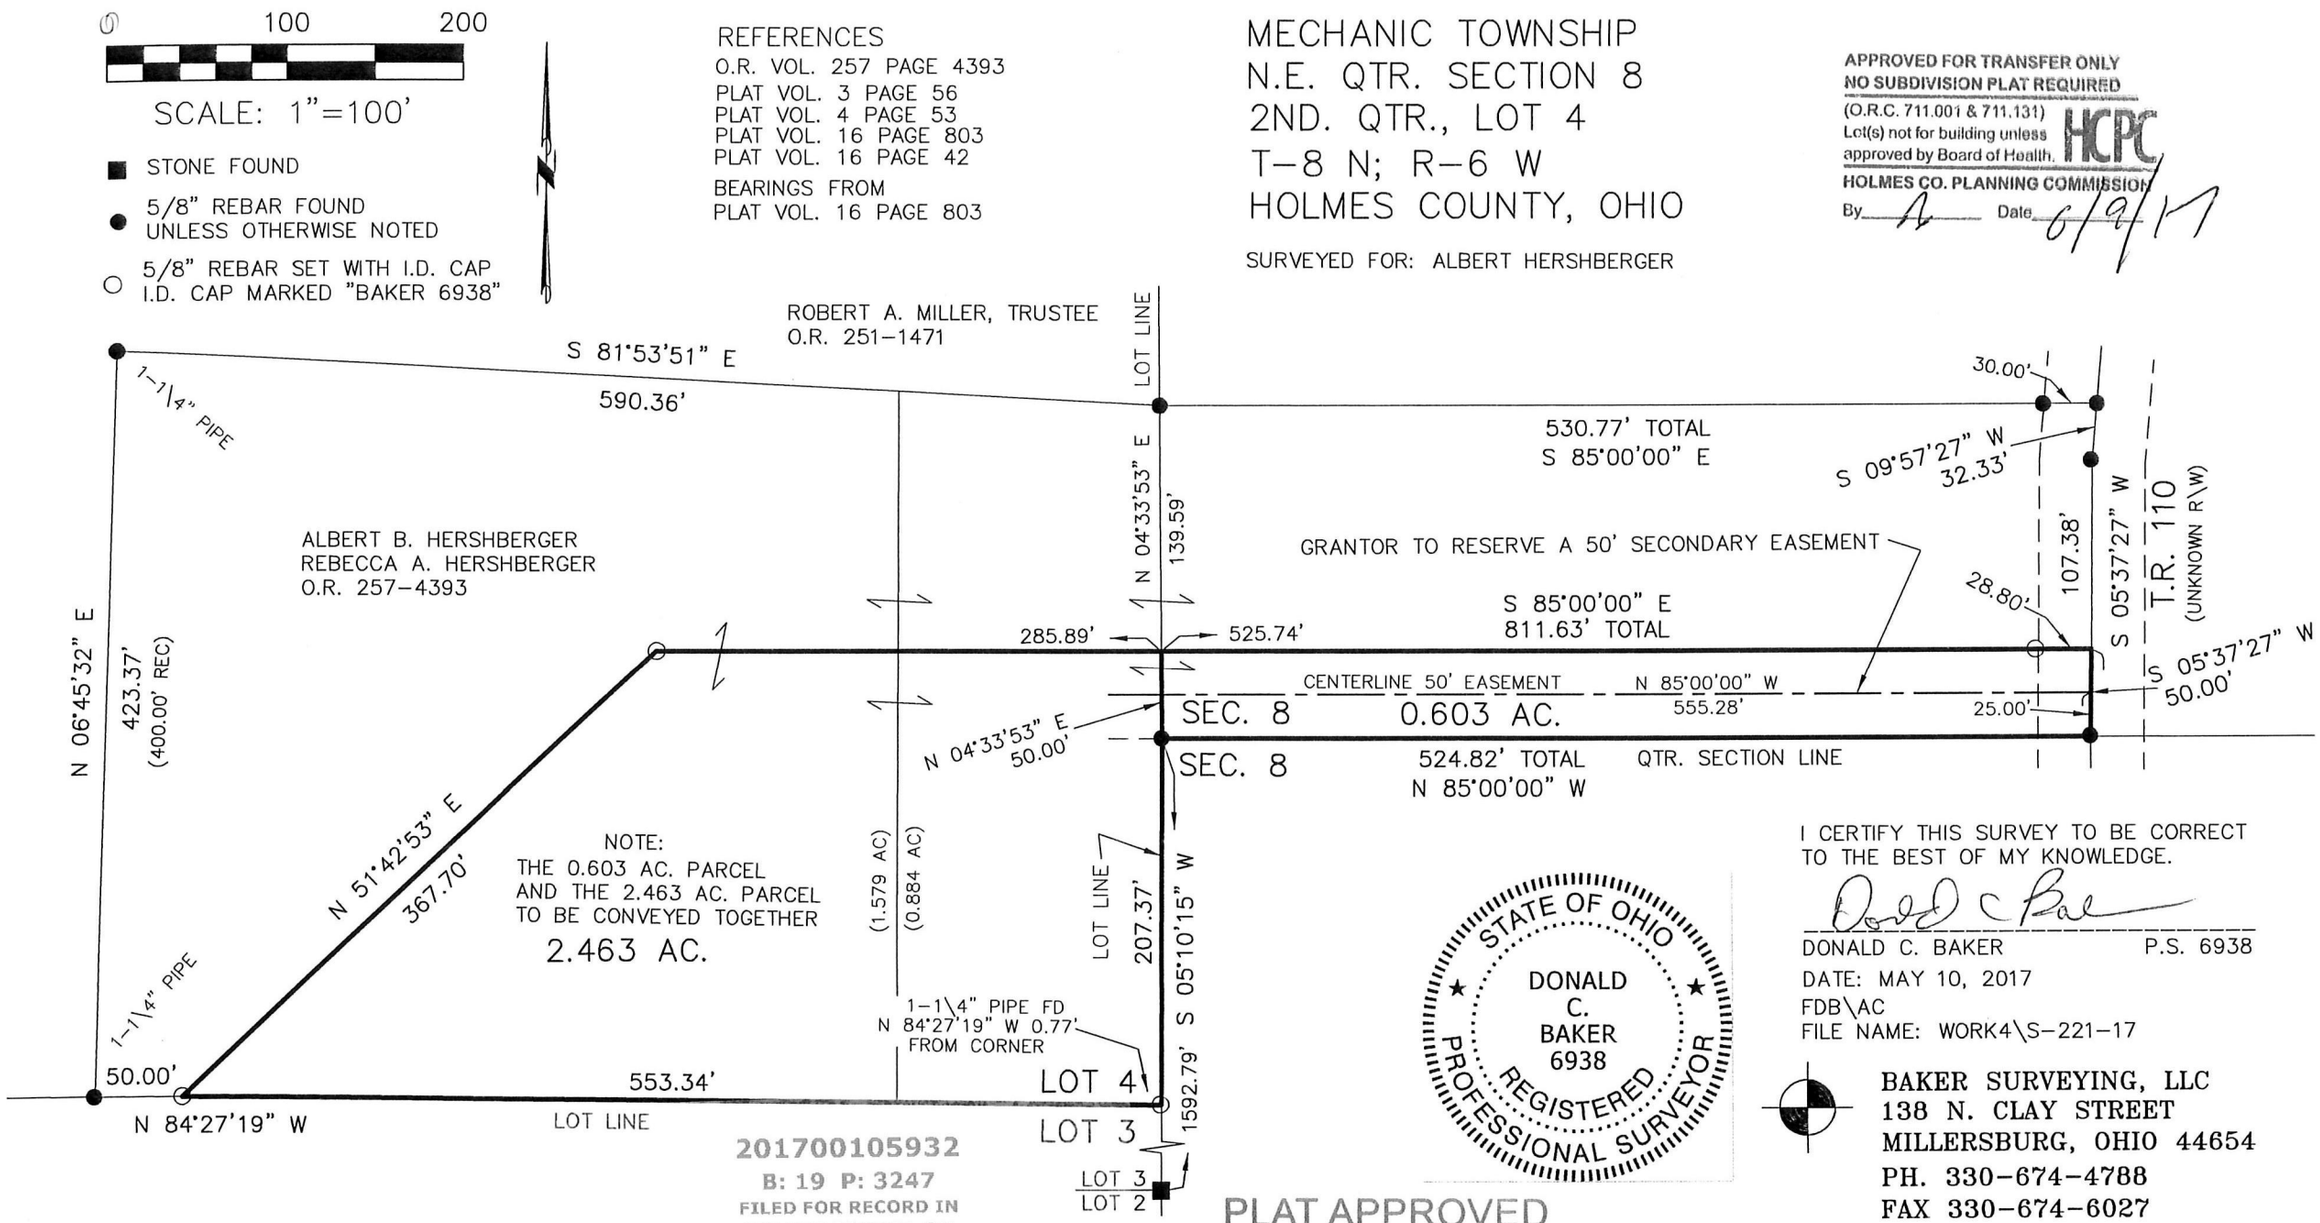

201700105932
B: 19 P: 3247
FILED FOR RECORD IN
HOLMES COUNTY, OH
ANITA HALL, COUNTY RECORDER
07/06/2017 11:33 AM
SMALL PLAT . 40.00
PAGES: 1
ORV 260 PG 5560

8038264 TX:4020848

PLAT APPROVED
5/26/2017

STATE OF OHIO
DONALD C. BAKER 6938
REGISTERED PROFESSIONAL SURVEYOR

I CERTIFY THIS SURVEY TO BE CORRECT TO THE BEST OF MY KNOWLEDGE.

DONALD C. BAKER P.S. 6938
DATE: MAY 10, 2017
FDB\AC
FILE NAME: WORK4\S-221-17

BAKER SURVEYING, LLC
138 N. CLAY STREET
MILLERSBURG, OHIO 44654
PH. 330-674-4788
FAX 330-674-6027