


ORV 264 PG 5990

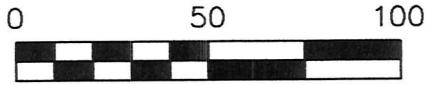

SCALE: 1"=50'

- ▲ R.R. SPIKE FOUND
- 5/8" REBAR FOUND UNLESS OTHERWISE NOTED


VILLAGE OF LAKEVILLE  
LOT 31  
WASHINGTON TOWNSHIP  
S.W. QTR. SECTION 25  
T-20 N; R-15 W  
HOLMES COUNTY, OHIO

SURVEYED FOR: LARRY MYERS

REFERENCES

- DEED VOL. 203 PAGE 456
- O.R. VOL. 189 PAGE 2680
- O.R. VOL. 240 PAGE 2302
- O.R. VOL. 201 PAGE 2824
- PLAT VOL. 12 PAGE 461
- PLAT VOL. 12 PAGE 425
- PLAT VOL. 19 PAGE 1220

BEARINGS FROM  
PLAT VOL. 12 PAGE 461

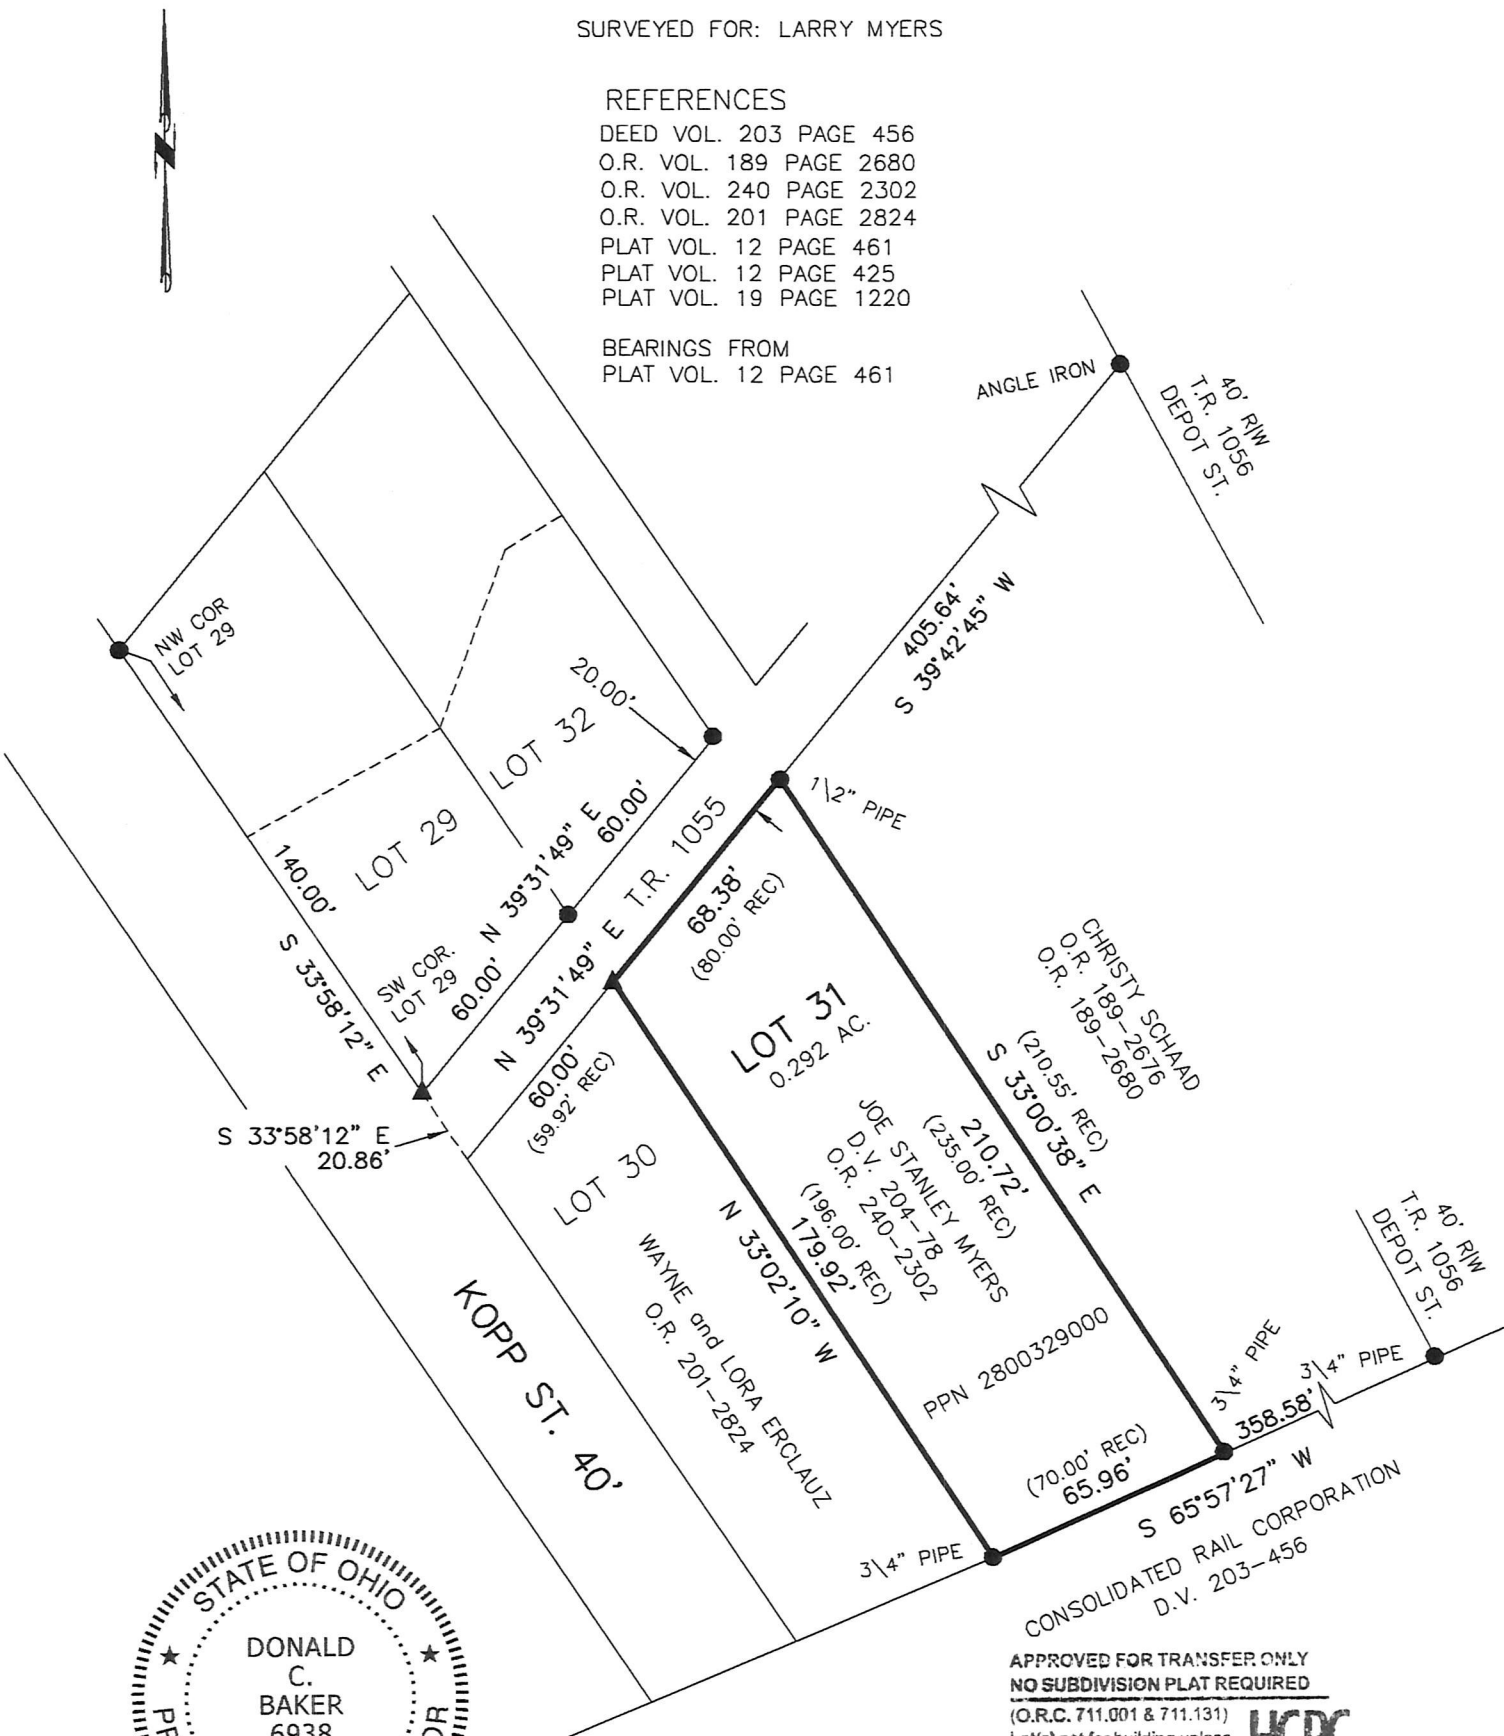

I CERTIFY THIS SURVEY TO BE CORRECT TO THE BEST OF MY KNOWLEDGE.

*Donald C. Baker*  
DONALD C. BAKER P.S. 6938

DATE: MAY 22, 2018  
KES\ADC  
FILE NAME: WORK4\S-160-18



APPROVED FOR TRANSFER ONLY  
NO SUBDIVISION PLAT REQUIRED

(O.R.C. 711.001 & 711.131)  
Lot(s) not for building unless approved by Board of Health.



HOLMES CO. PLANNING COMMISSION  
By: *[Signature]* Date: *8/2/18*



BAKER SURVEYING, LLC  
138 N. CLAY STREET  
MILLERSBURG, OHIO 44654  
PH. 330-674-4788  
FAX 330-674-6027

PLAT APPROVED

*7/31/2018*