


PRAIRIE TOWNSHIP  
 S.W. QTR. SECTION 1  
 N.W. QTR. SECTION 12  
 T-13 N; R-13 W  
 HOLMES COUNTY, OHIO

SURVEYED FOR: ELI ALLEN MILLER

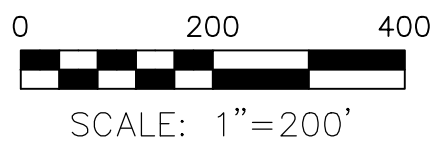


- STONE FOUND
- MAG NAIL FOUND
- 5/8" REBAR FOUND UNLESS OTHERWISE NOTED
- P.K. NAIL SET
- 5/8" REBAR SET WITH I.D. CAP I.D. CAP MARKED "BAKER 6938"

REFERENCES

DEED VOL. 233 PAGE 551  
 O.R. VOL. 265 PAGE 1995  
 O.R. VOL. 175 PAGE 34  
 O.R. VOL. 251 PAGE 1016  
 O.R. VOL. 269 PAGE 3617  
 PLAT VOL. 19 PAGE 177  
 PLAT VOL. 19 PAGE 3568  
 PLAT VOL. 18 PAGE 720  
 BASIS OF BEARINGS ASSUMED

202100015843  
 B: 19 P: 4420  
 FILED FOR RECORD IN  
 HOLMES COUNTY, OH  
 ANITA HALL, COUNTY RECORDER  
 06/14/2021 11:24 AM  
 SMALL PLAT . 40.00  
 PAGES: 1  
 ORV 277 P 3079

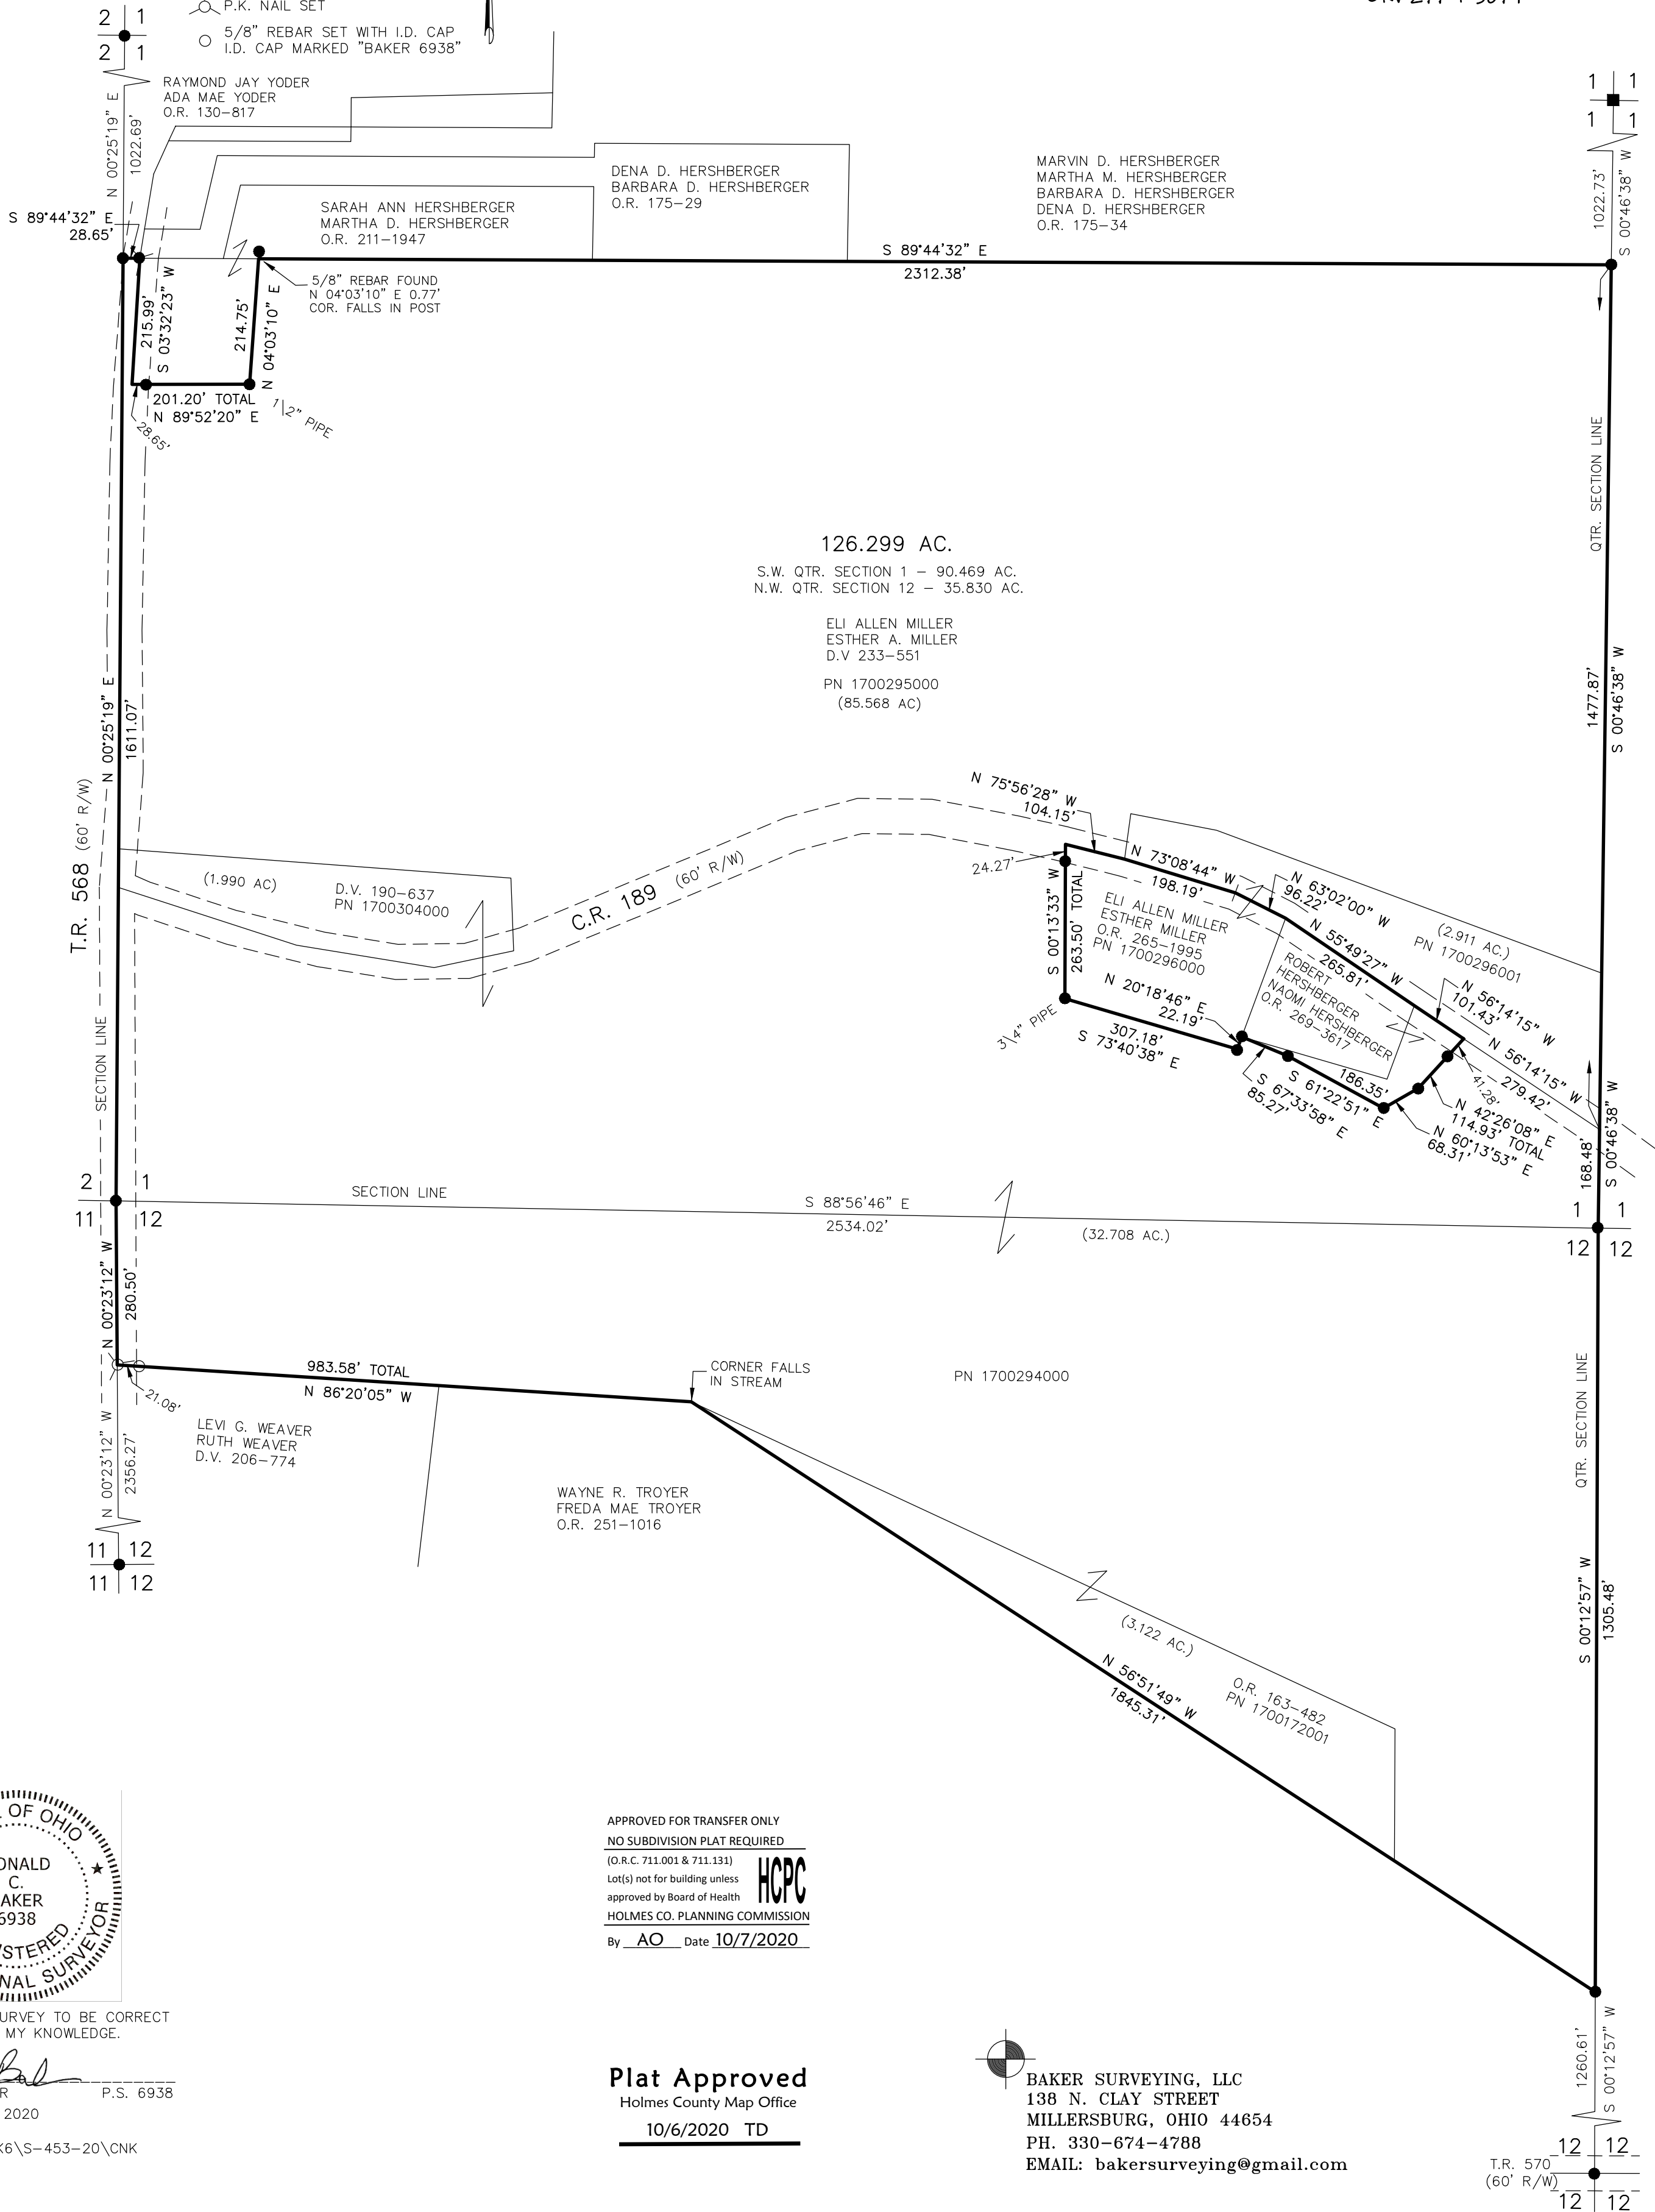

I CERTIFY THIS SURVEY TO BE CORRECT TO THE BEST OF MY KNOWLEDGE.  
*Donald C. Baker*  
 DONALD C. BAKER P.S. 6938  
 DATE: SEPT. 18, 2020  
 FDB/TAB  
 FILE NAME: WORK6\S-453-20\CNK

APPROVED FOR TRANSFER ONLY  
 NO SUBDIVISION PLAT REQUIRED  
 (O.R.C. 711.001 & 711.131)  
 Lot(s) not for building unless approved by Board of Health  
 HOLMES CO. PLANNING COMMISSION  
 By AO Date 10/7/2020

**Plat Approved**  
 Holmes County Map Office  
 10/6/2020 TD

BAKER SURVEYING, LLC  
 138 N. CLAY STREET  
 MILLERSBURG, OHIO 44654  
 PH. 330-674-4788  
 EMAIL: bakersurveying@gmail.com

T.R. 570  
 (60' R/W)  
 12 12