


PAINT TOWNSHIP
 3RD. QTR., LOT 27
 T-10 N; R-4 W
 HOLMES COUNTY, OHIO

SURVEYED FOR: KIM KORNHAUS

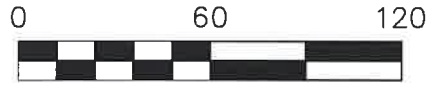

SCALE: 1"=60'

- STONE FOUND
- 5/8" REBAR FOUND
UNLESS OTHERWISE NOTED
- 5/8" REBAR SET WITH I.D. CAP
I.D. CAP MARKED "BAKER
SURVEYING LLC"

BASIS OF BEARINGS FROM
 OHIO STATE PLANE COORDINATE
 SYSTEM, NORTH ZONE, N.A.D. 83,
 2011 ADJUSTMENT



I CERTIFY THIS SURVEY TO BE CORRECT
 TO THE BEST OF MY KNOWLEDGE.

Donald C. Baker

DONALD C. BAKER P.S. 6938

DATE: JULY 26, 2023

KES
 FILE NAME: WORK6\S-400-23


RESURVEY
 OF O.R. 168 PG. 2168

REFERENCES

- O.R. VOL. 168 PAGE 2168
- PLAT VOL. 14 PAGE 285
- PLAT VOL. 16 PAGE 286
- PLAT VOL. 16 PAGE 316
- PLAT VOL. 19 PAGE 4275

202300004628
 B: 19 P: 5150
 FILED FOR RECORD IN
 HOLMES COUNTY, OH
 ANITA HALL, COUNTY RECORDER
 11/17/2023 02:09 PM
 SMALL PLAT . 40.00
 PAGES: 1

ORV 287 Pg 2191

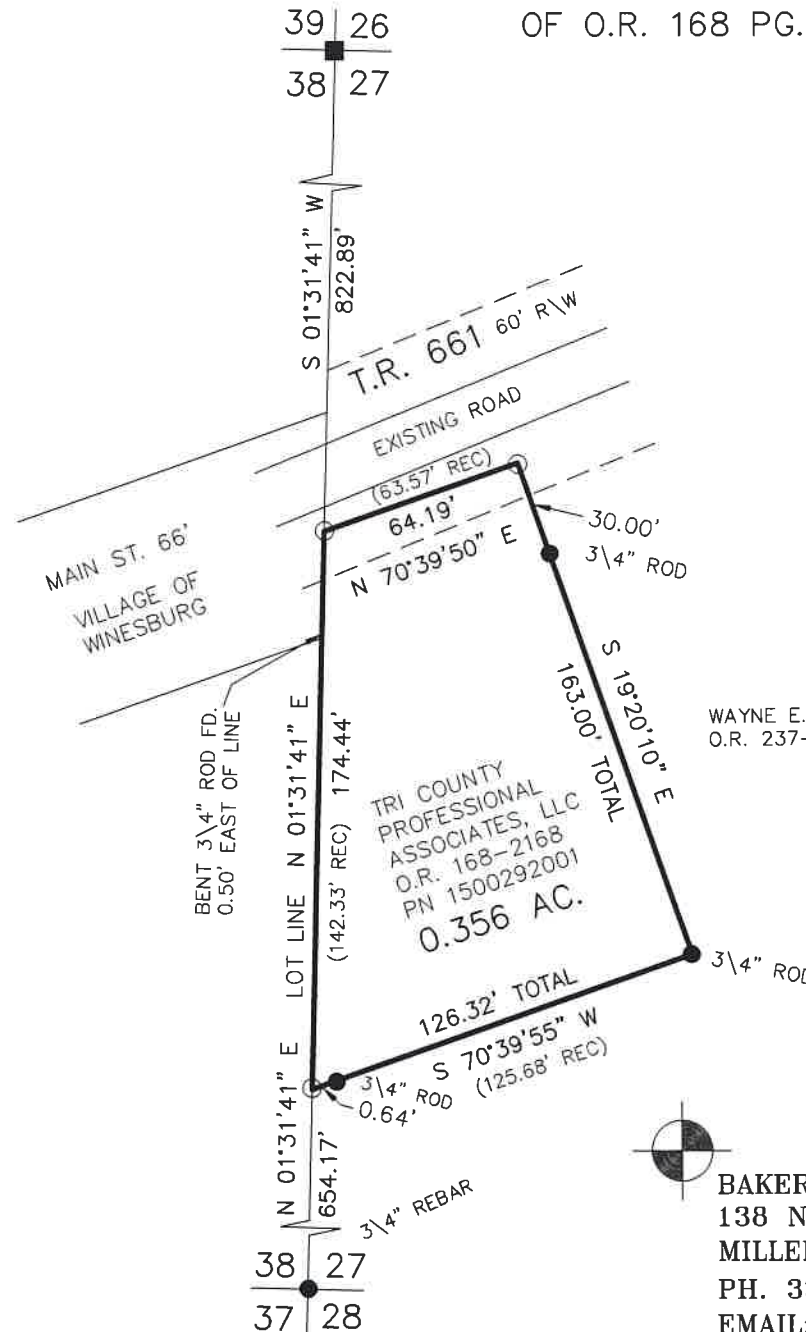

BAKER SURVEYING, LLC
 138 N. CLAY STREET
 MILLERSBURG, OHIO 44654
 PH. 330-674-4788
 EMAIL: bakersurveying@gmail.com

APPROVED FOR TRANSFER ONLY
 NO SUBDIVISION PLAT REQUIRED
 (O.R.C. 711.001 & 711.131)
 Lot(s) not for building unless
 approved by Board of Health
 HOLMES CO. PLANNING COMMISSION
 By TS Date 11/13/2023



Plat Approved
 Holmes County Map Office

11/8/2023 MM