

- ▲ R.R. SPIKE FOUND
- 5/8" REBAR FOUND
UNLESS OTHERWISE NOTED
- 5/8" REBAR SET WITH I.D. CAP
I.D. CAP MARKED "BAKER 6938"

REFERENCES

O.R. VOL. 62 PAGE 304

O.R. VOL. 286 PAGE 901

PLAT VOL. 16 PAGE 711

PLAT VOL. 17 PAGE 694

PLAT VOL. 19 PAGE 1812

BASIS OF BEARINGS FROM OHIO STATE PLANE
COORDINATE SYSTEM, NORTH ZONE,
N.A.D. 83, 2011 ADJUSTMENT



I CERTIFY THIS SURVEY TO BE CORRECT
TO THE BEST OF MY KNOWLEDGE.

Donald C. Baker
DONALD C. BAKER P.S. 6938


DATE: FEB. 25, 2025

TAB\GRB

FILE NAME: WORK7\S-86-25\CNK

SALT CREEK TOWNSHIP
S.W. QTR. SECTION 25
T-15 N; R-12 W
HOLMES COUNTY, OHIO

SURVEYED FOR: MARLIN WEAVER

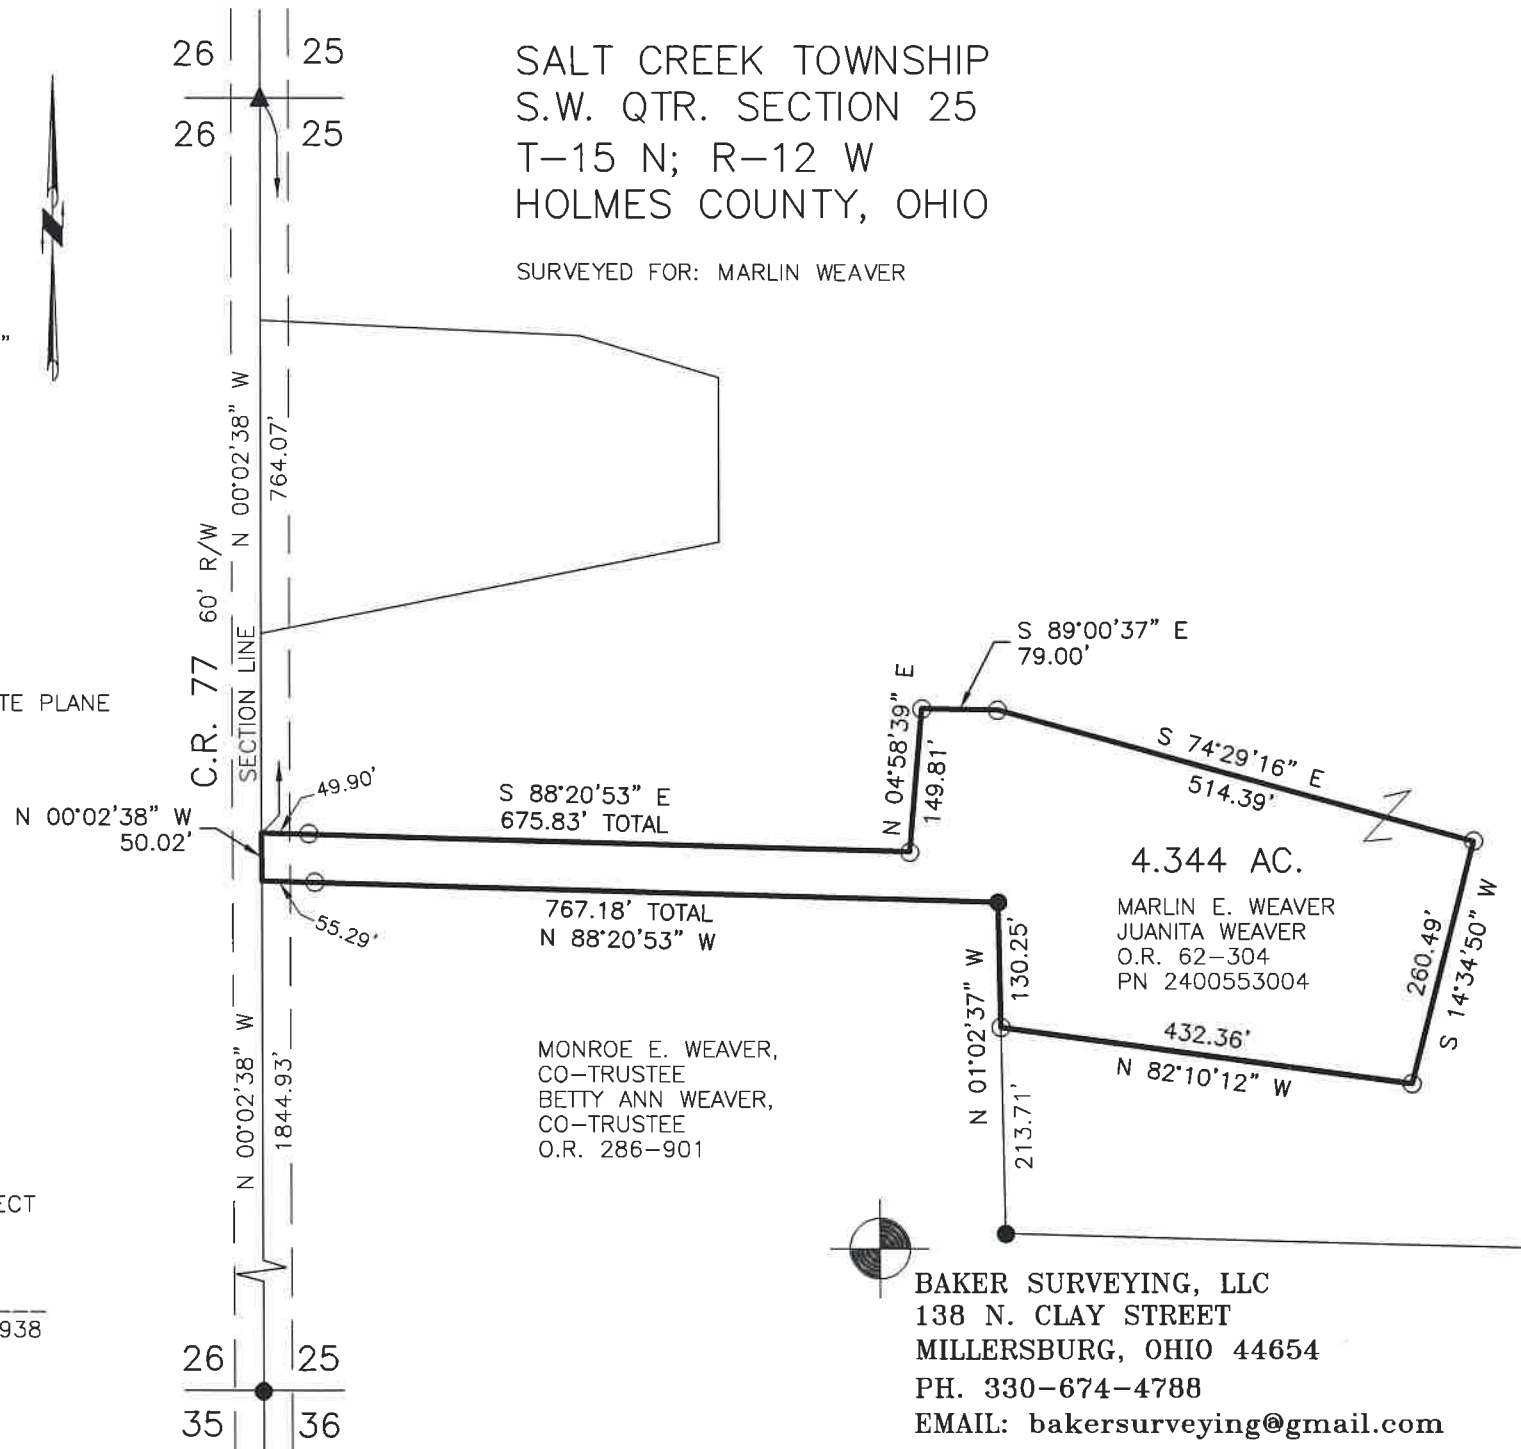

202500001436

B: 19 P: 5531

FILED FOR RECORD IN

HOLMES COUNTY, OH

ANITA HALL, COUNTY RECORDER

04/17/2025 01:32 PM

SMALL PLAT . 40.00

PAGES: 1

ORV 291 Pg 6515

APPROVED FOR TRANSFER ONLY

NO SUBDIVISION PLAT REQUIRED

(O.R.C. 711.001 & 711.131)

Lot(s) not for building unless

approved by Board of Health

HOLMES CO. PLANNING COMMISSION

By AO Date 3/31/2025

Plat Approved

Holmes County Map Office

3/19/2025 Rg