


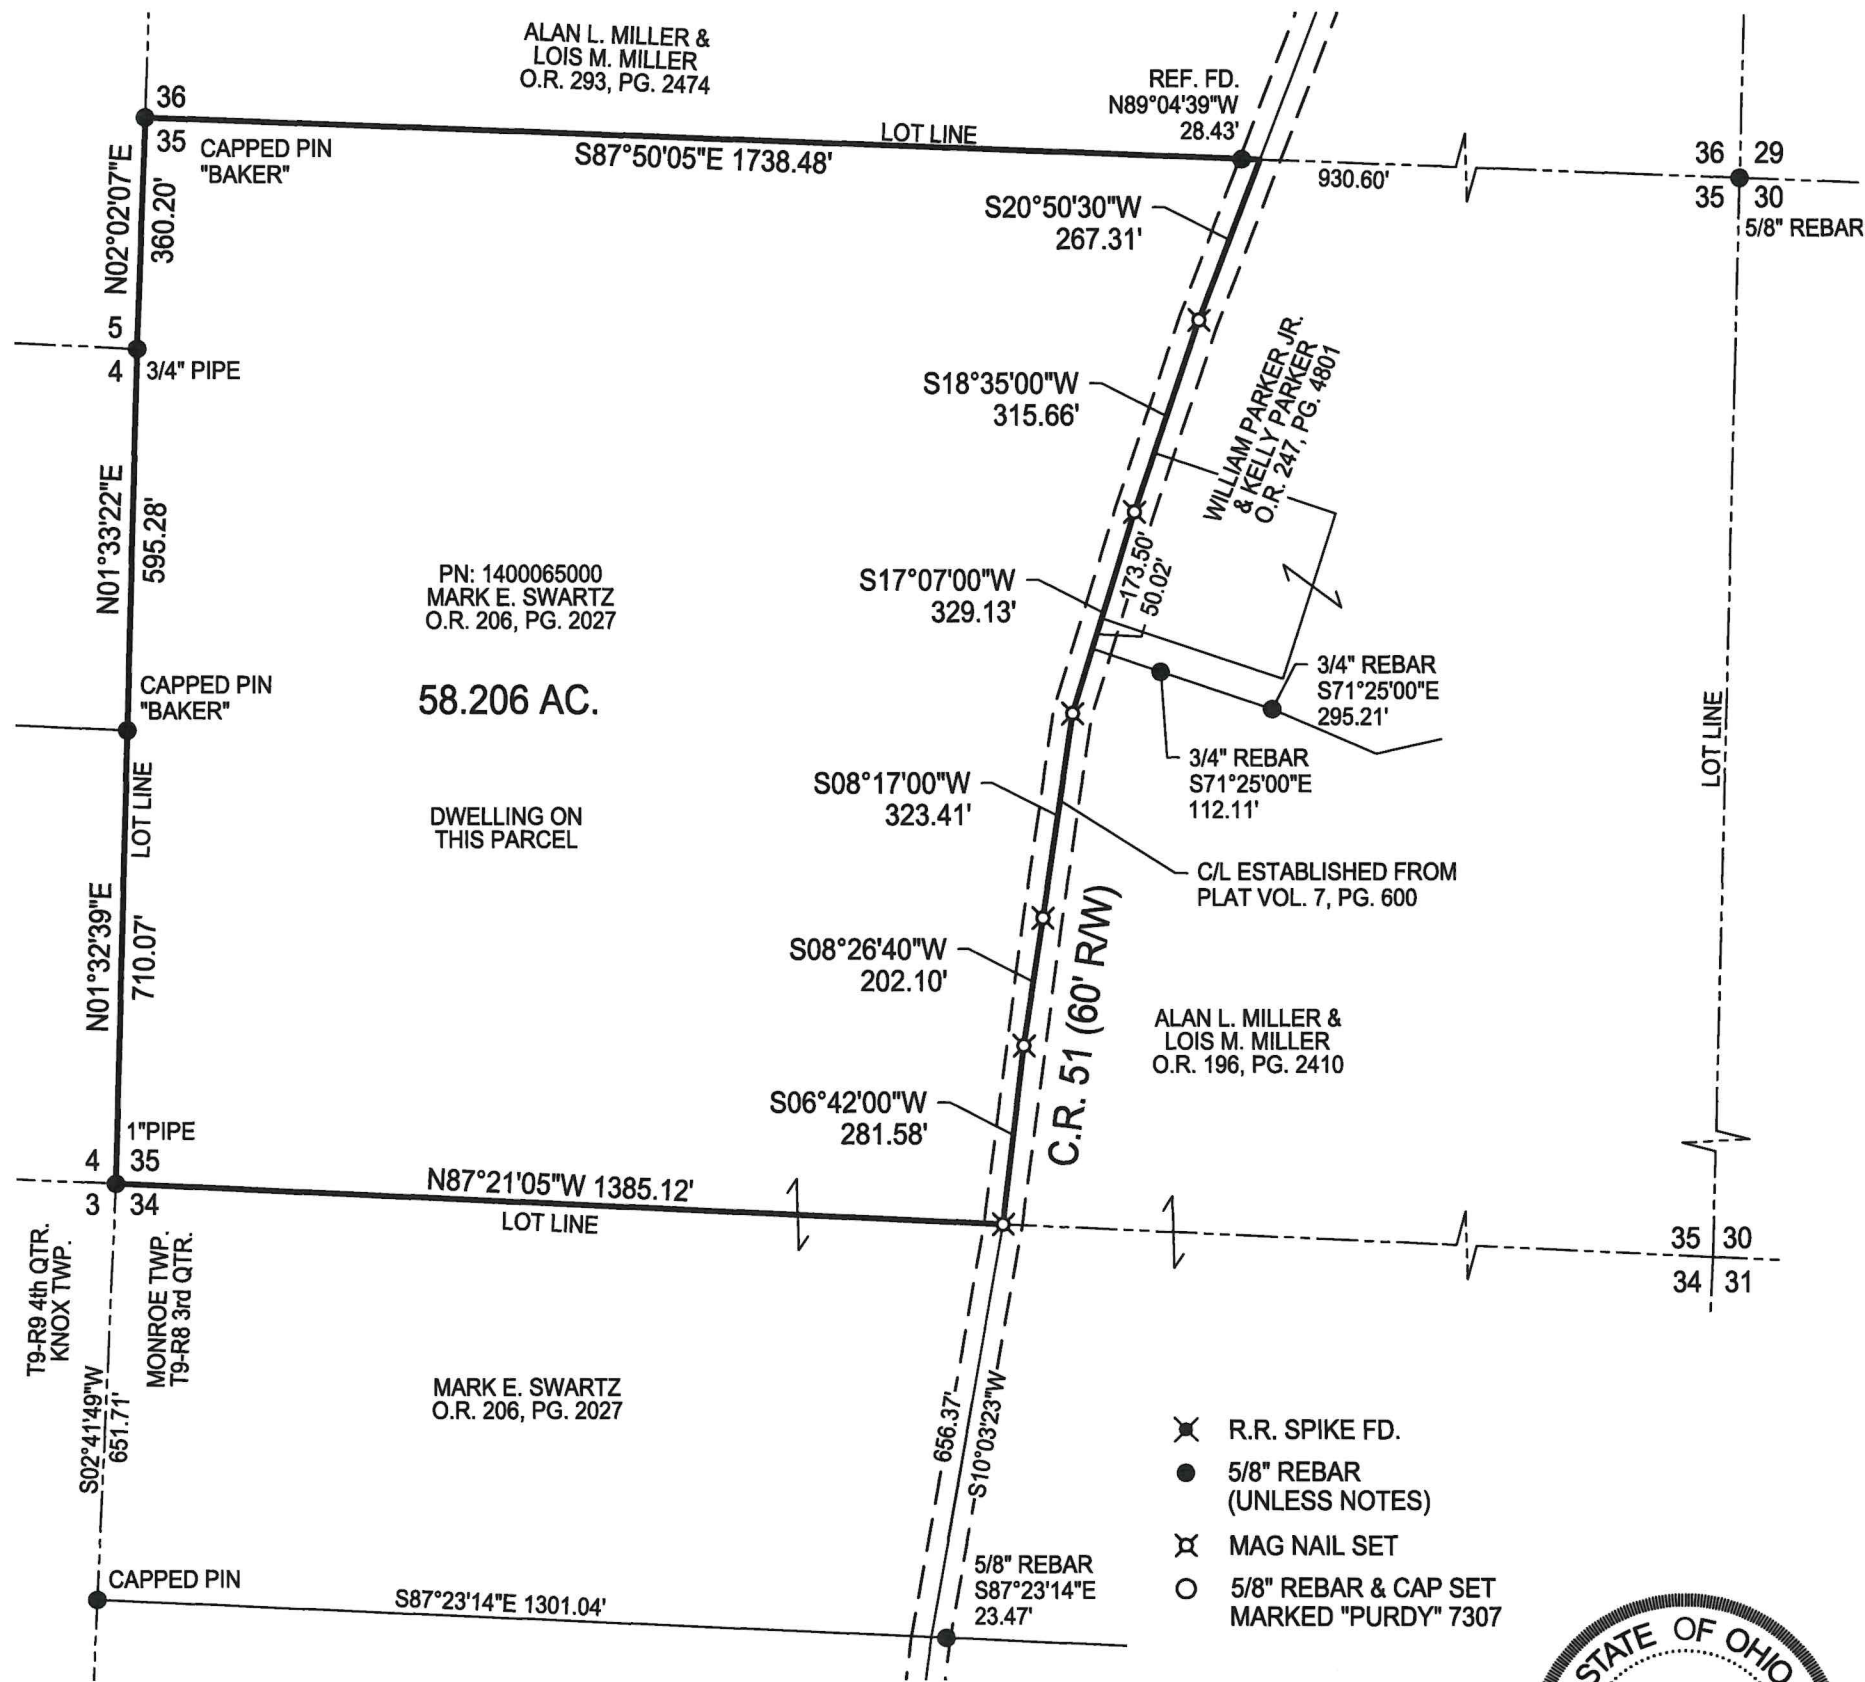

--- SECTION LINE
--- CENTERLINE
--- R/W LINE
--- EX. PROPERTY LINE
--- PROP. PROPERTY LINE

- ✕ R.R. SPIKE FD.
- 5/8" REBAR (UNLESS NOTES)
- ✕ MAG NAIL SET
- 5/8" REBAR & CAP SET MARKED "PURDY" 7307




I CERTIFY THIS SURVEY AND PLAT TO BE CORRECT TO THE BEST OF MY KNOWLEDGE.

MARK E. PURDY, P.S. #7307

DATE

RETRACEMENT SURVEY
TOWNSHIP OF MONROE
3RD QTR., LOT 35
T-9N ; R-8W
COUNTY OF HOLMES
STATE OF OHIO

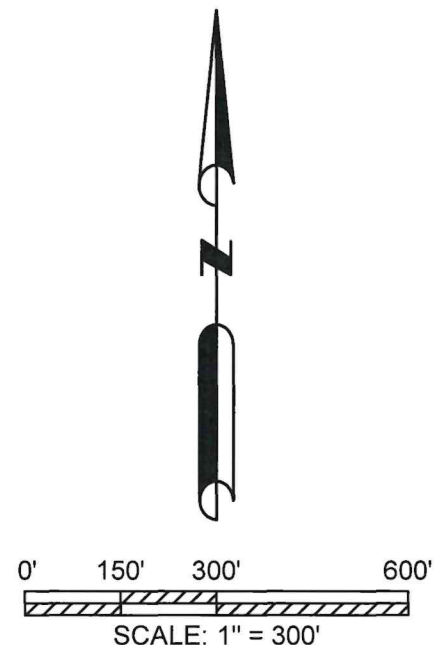

REFERENCE SURVEY:
VOL. 6, PG. 94; VOL. 7, PG. 128;
VOL. 7, PG. 600; VOL. 7, PG. 451;
VOL. 9, PG. 15; VOL. 10, PG. 508;
VOL. 10, PG. 848; VOL. 19, PG. 143;
BK. 19, PG. 1973; O.R. 10, PG. 848;
BK. 19, 1381; BK. 19, PG. 4659; BK.
19, PG. 5232; BK. 19, PG. 5636

BASIS OF BEARING:
The bearings as shown hereon are
relative to GRID NORTH of the OHIO
STATE PLANE COORDINATE
SYSTEM, NAD 83 DATUM

202600000182
B: 19 P: 5740
FILED FOR RECORD IN
HOLMES COUNTY, OH
ANITA HALL, COUNTY RECORDER
01/13/2026 02:09 PM
SMALL PLAT . 40.00
PAGES: 1
ORV 294 Pg 4531

APPROVED FOR TRANSFER ONLY
NO SUBDIVISION PLAT REQUIRED
(O.R.C. 711.001 & 711.131)
Lot(s) not for building unless
approved by Board of Health
HOLMES CO. PLANNING COMMISSION
By AO Date 12/3/2025



Plat Approved
Holmes County Map Office
12/2/2025 MM