BEING PART OF: LOT 14, 15, 18, 19
SEC. ~
QUAR. 3RD
T 9 N. R 5 W
TOWNSHIP BERLIN
COUNTY HOLMES, OHIO, U.S.A.

THE COSHOCTON LAND SURVEYING SERVICE, INC.

233 S. FOURTH ST. COSHOCTON, OHIO 43812

SURVEY FOR: RALPH RING
HOLMES CORE STONE
DATE: 11-21-80
SCALE: .1" = 500

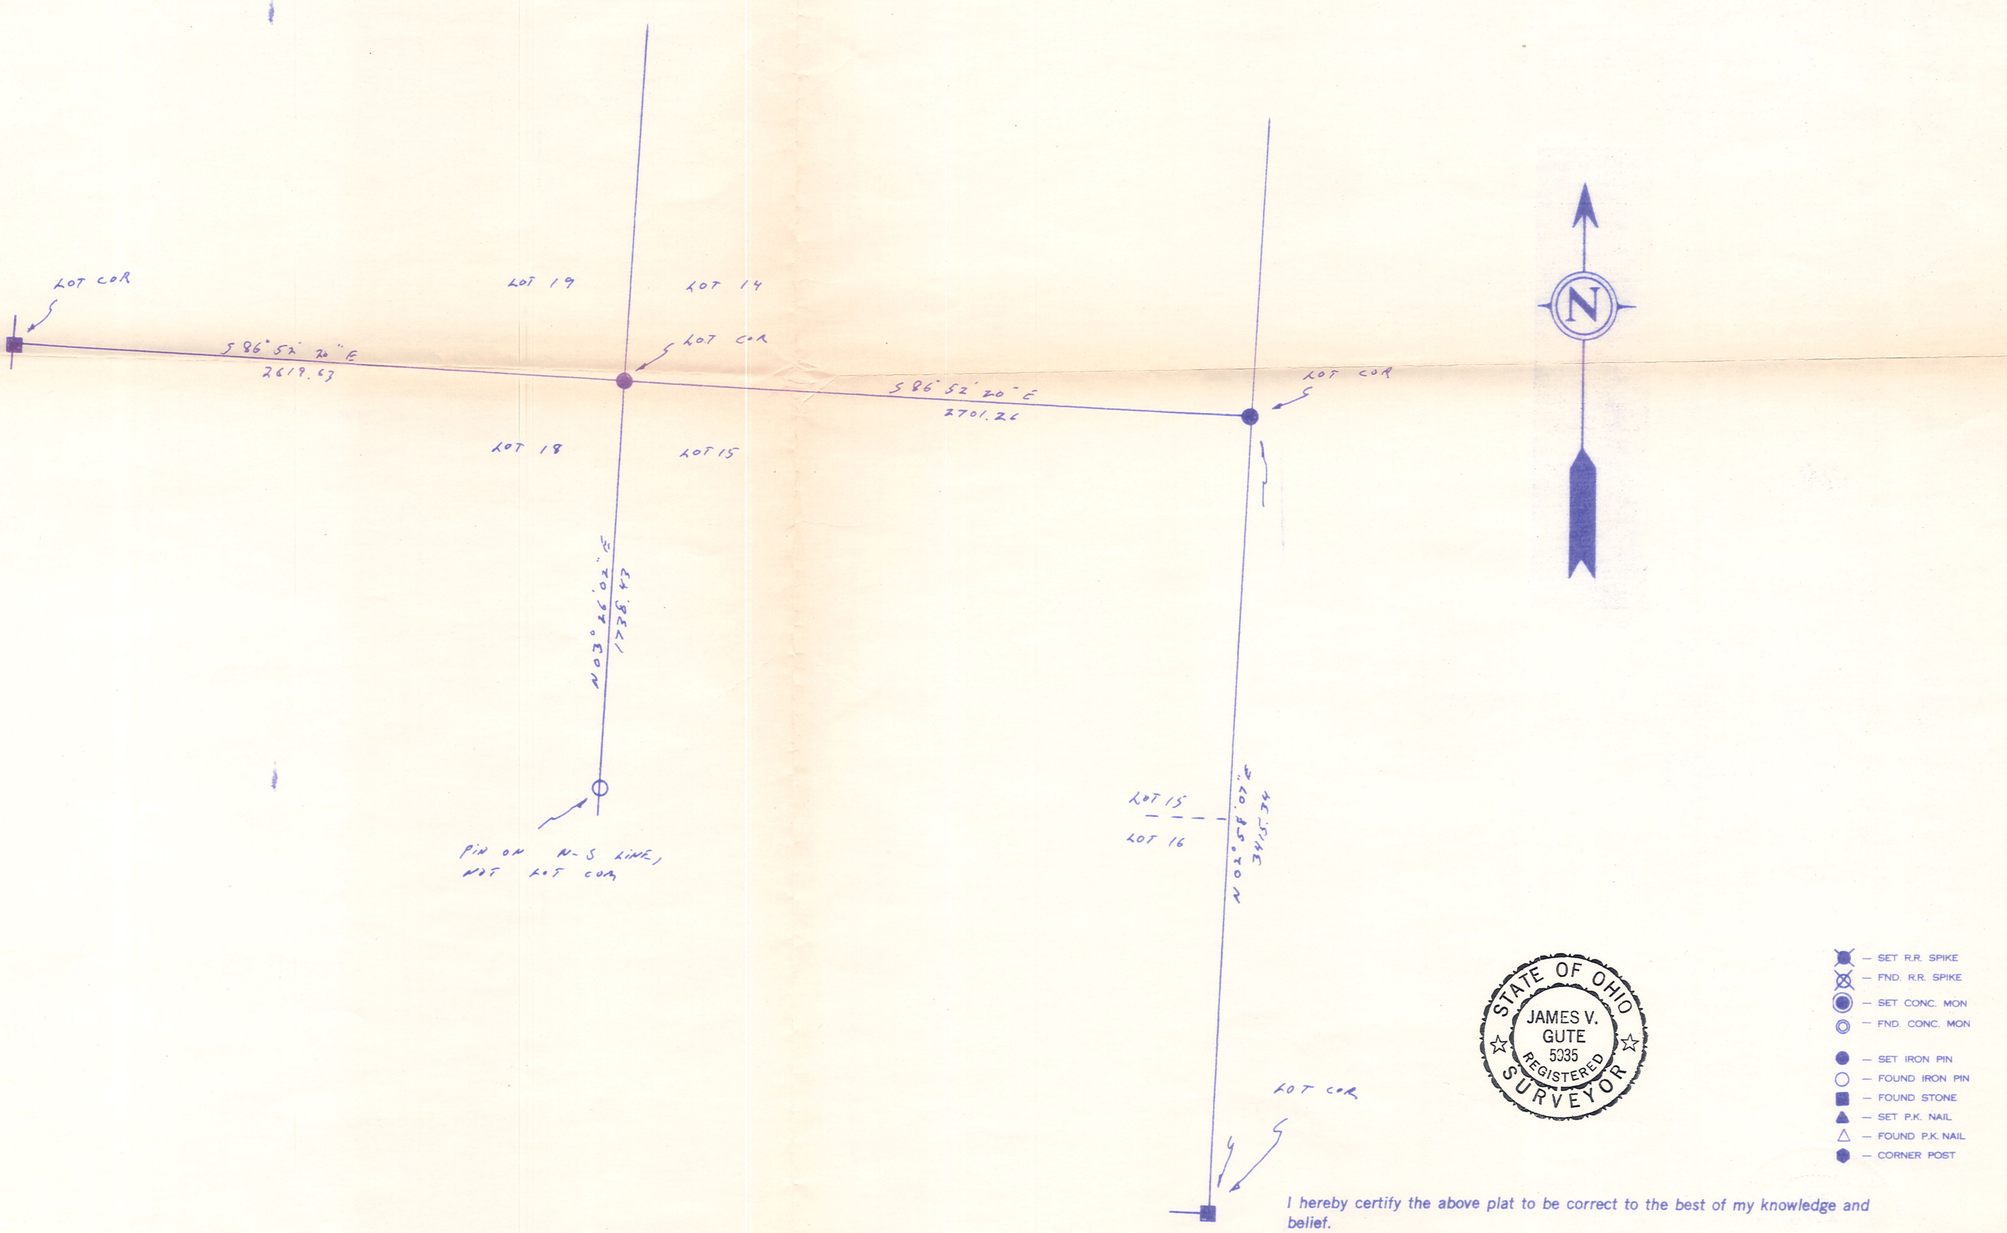

STATE OF OHIO
JAMES V. GUTE
5035
REGISTERED
SURVEYOR

- SET R.R. SPIKE
- FND. R.R. SPIKE
- SET CONC. MON
- FND. CONC. MON
- SET IRON PIN
- FOUND IRON PIN
- FOUND STONE
- SET P.K. NAIL
- FOUND P.K. NAIL
- CORNER POST

I hereby certify the above plat to be correct to the best of my knowledge and belief.

THE COSHOCTON LAND SURVEYING SERVICE

REGISTERED SURVEYOR 5-8-81
REGISTERED ENGINEER 37405

MAP OFFICE COPY

UNING 40-21 38975