

SCALE: 1"=100'

- 5/8" REBAR FOUND UNLESS OTHERWISE NOTED
- 5/8" REBAR SET WITH I.D. CAP I.D. CAP MARKED "BAKER 6938"




BERLIN TOWNSHIP
 3RD. QTR., LOT 16
 T-9 N; R-5 W
 HOLMES COUNTY, OHIO

SURVEYED FOR: PAUL A. MILLER

REFERENCES

- DEED VOL. 210 PAGE 29
- DEED VOL. 270 PAGE 47
- PLAT VOL. 8 PAGE 625
- PLAT VOL. 14 PAGE 903
- BEARINGS FROM PLAT VOL. 14 PAGE 903

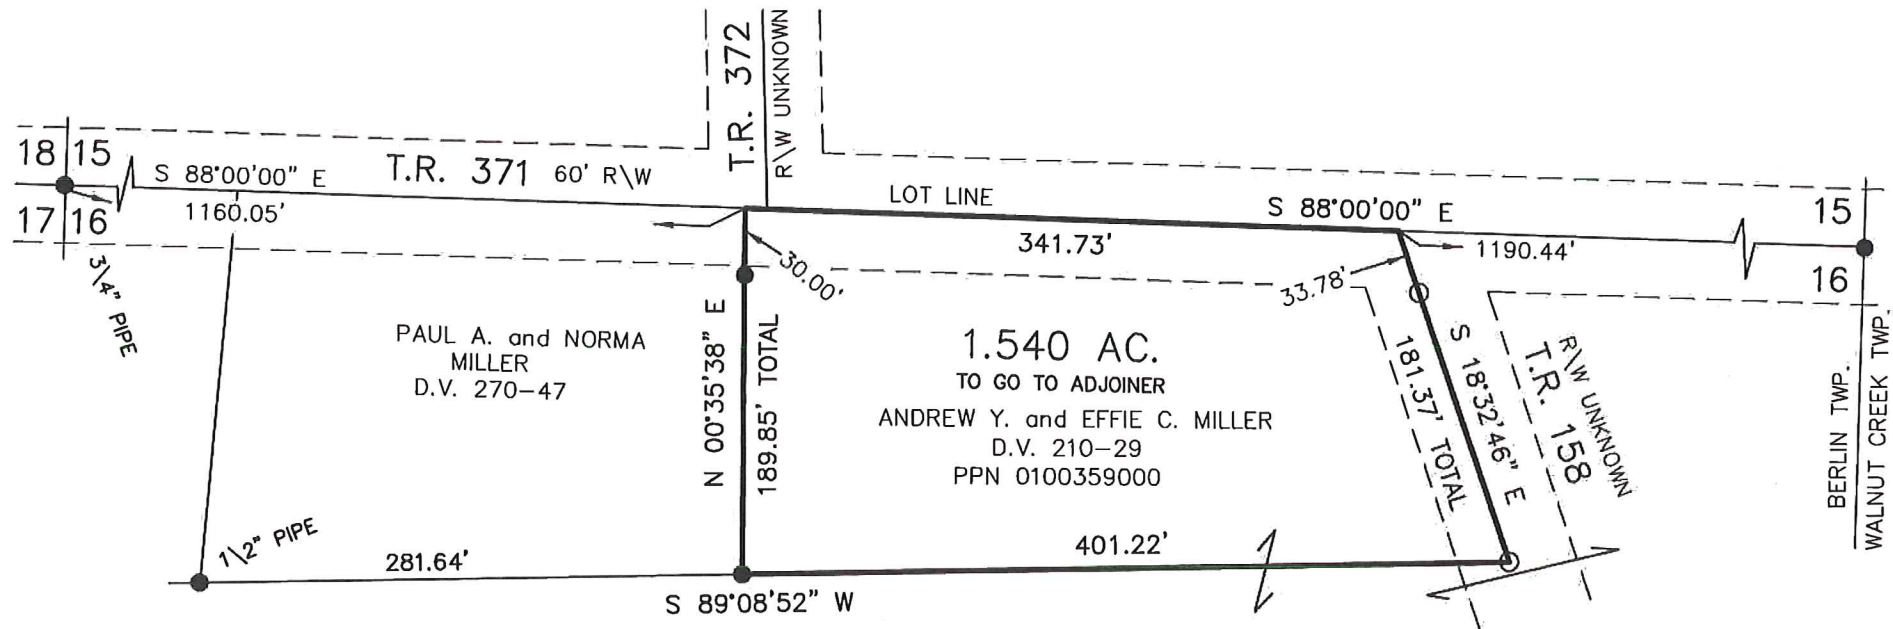

I CERTIFY THIS SURVEY TO BE CORRECT TO THE BEST OF MY KNOWLEDGE.

Donald C. Baker
 DONALD C. BAKER P.S. 6938

DATE: MARCH 8, 2018
 KES
 FILE NAME: WORK4\S-71-18

FOR REVIEW ONLY



BAKER SURVEYING, LLC
 138 N. CLAY STREET
 MILLERSBURG, OHIO 44654
 PH. 330-674-4788
 FAX 330-674-6027