

BERLIN TOWNSHIP
 3RD. QTR., LOTS 36 & 37
 T-9 N, R-5 W
 HOLMES COUNTY, OHIO

SURVEYED FOR: ROY A. YODER


REFERENCES

DEED VOL. 179 PAGE 884
 DEED VOL. 188 PAGE 905
 DEED VOL. 242 PAGE 154

O.R. VOL. 26 PAGE 416
 O.R. VOL. 215 PAGE 2799
 O.R. VOL. 216 PAGE 1216

PLAT VOL. 5 PAGE 118
 PLAT VOL. 12 PAGE 142
 PLAT VOL. 19 PAGE 416, 1622 & 1639

BEARINGS FROM PLAT VOL. 19 PAGE 1639

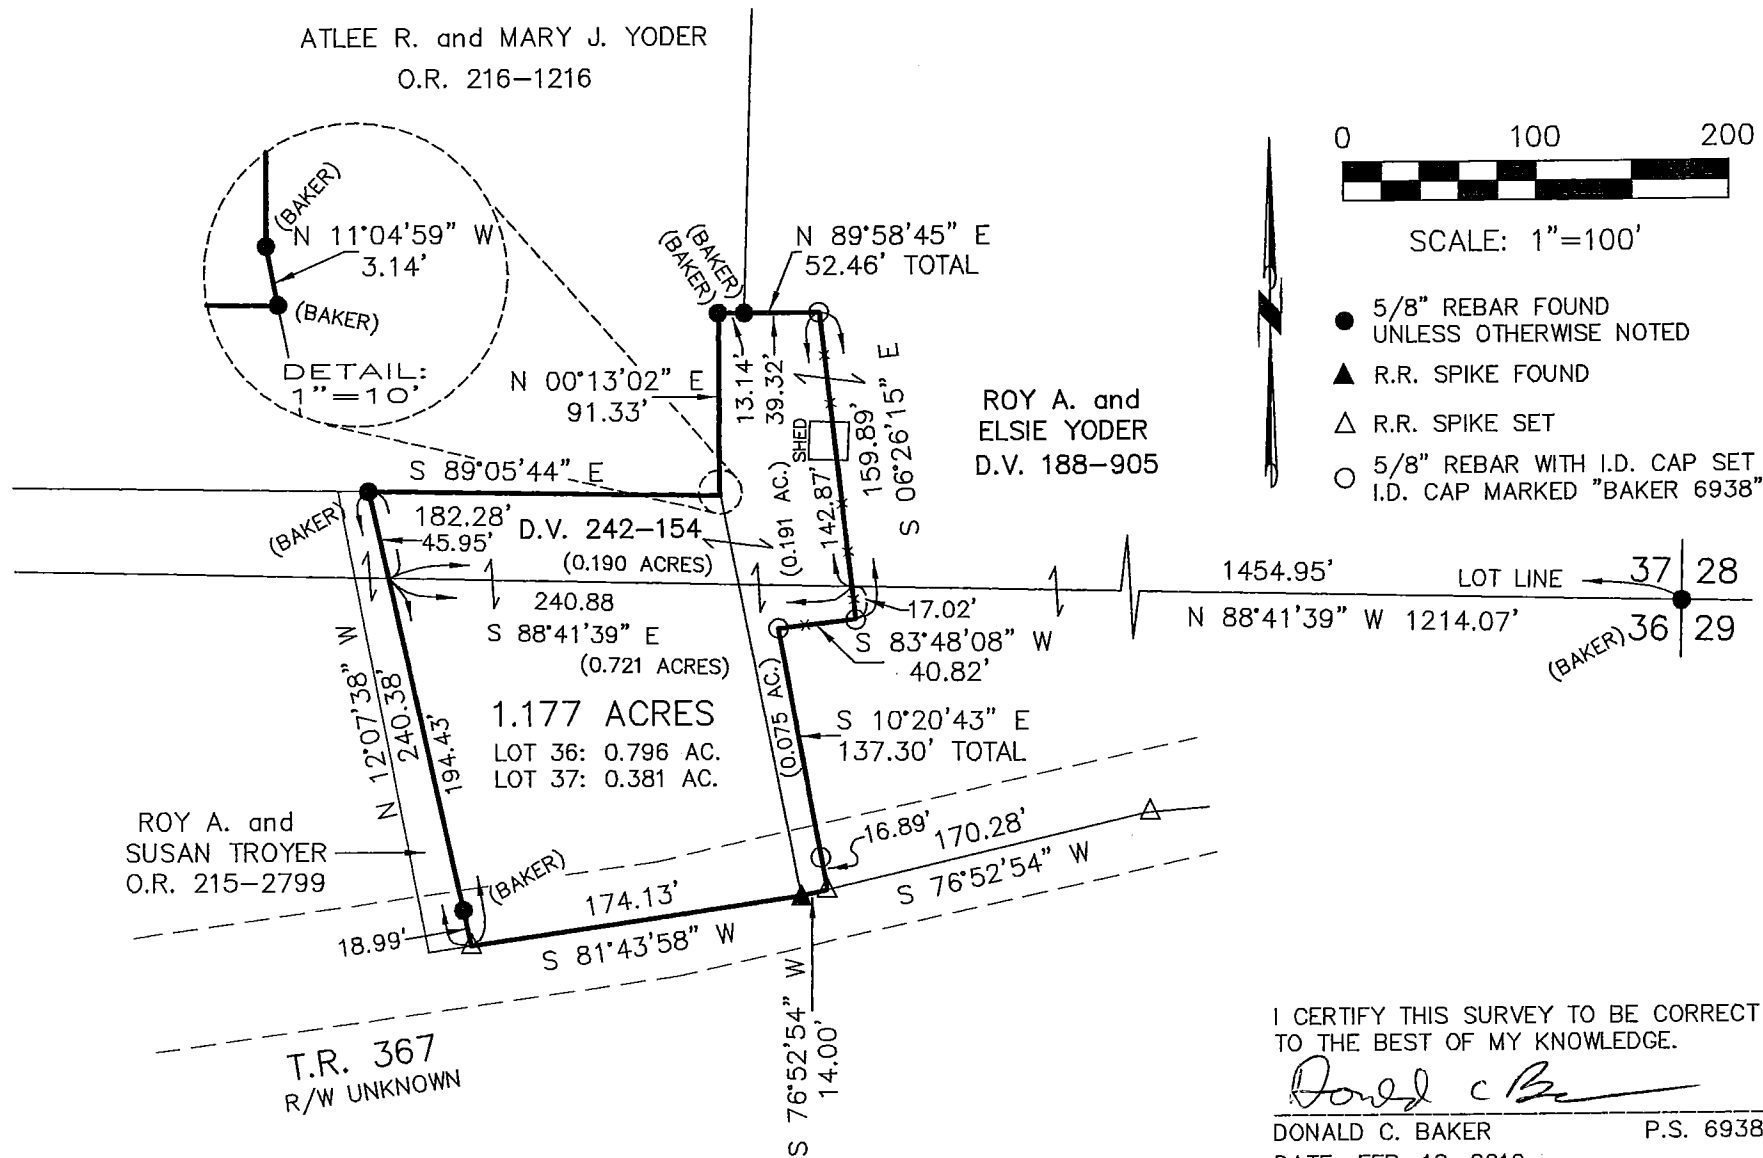

DONALD C. BAKER SURVEYING
 138 N. CLAY ST.
 MILLERSBURG, OHIO, 44654
 PH. 330-674-4788
 FAX. 330-674-6027

I CERTIFY THIS SURVEY TO BE CORRECT
 TO THE BEST OF MY KNOWLEDGE.

Donald C. Baker
 DONALD C. BAKER P.S. 6938
 DATE: FEB. 12, 2010

ALG\KES
 File Name: WORK2\S-325B-09\ERZ
 INV: S-405-09