
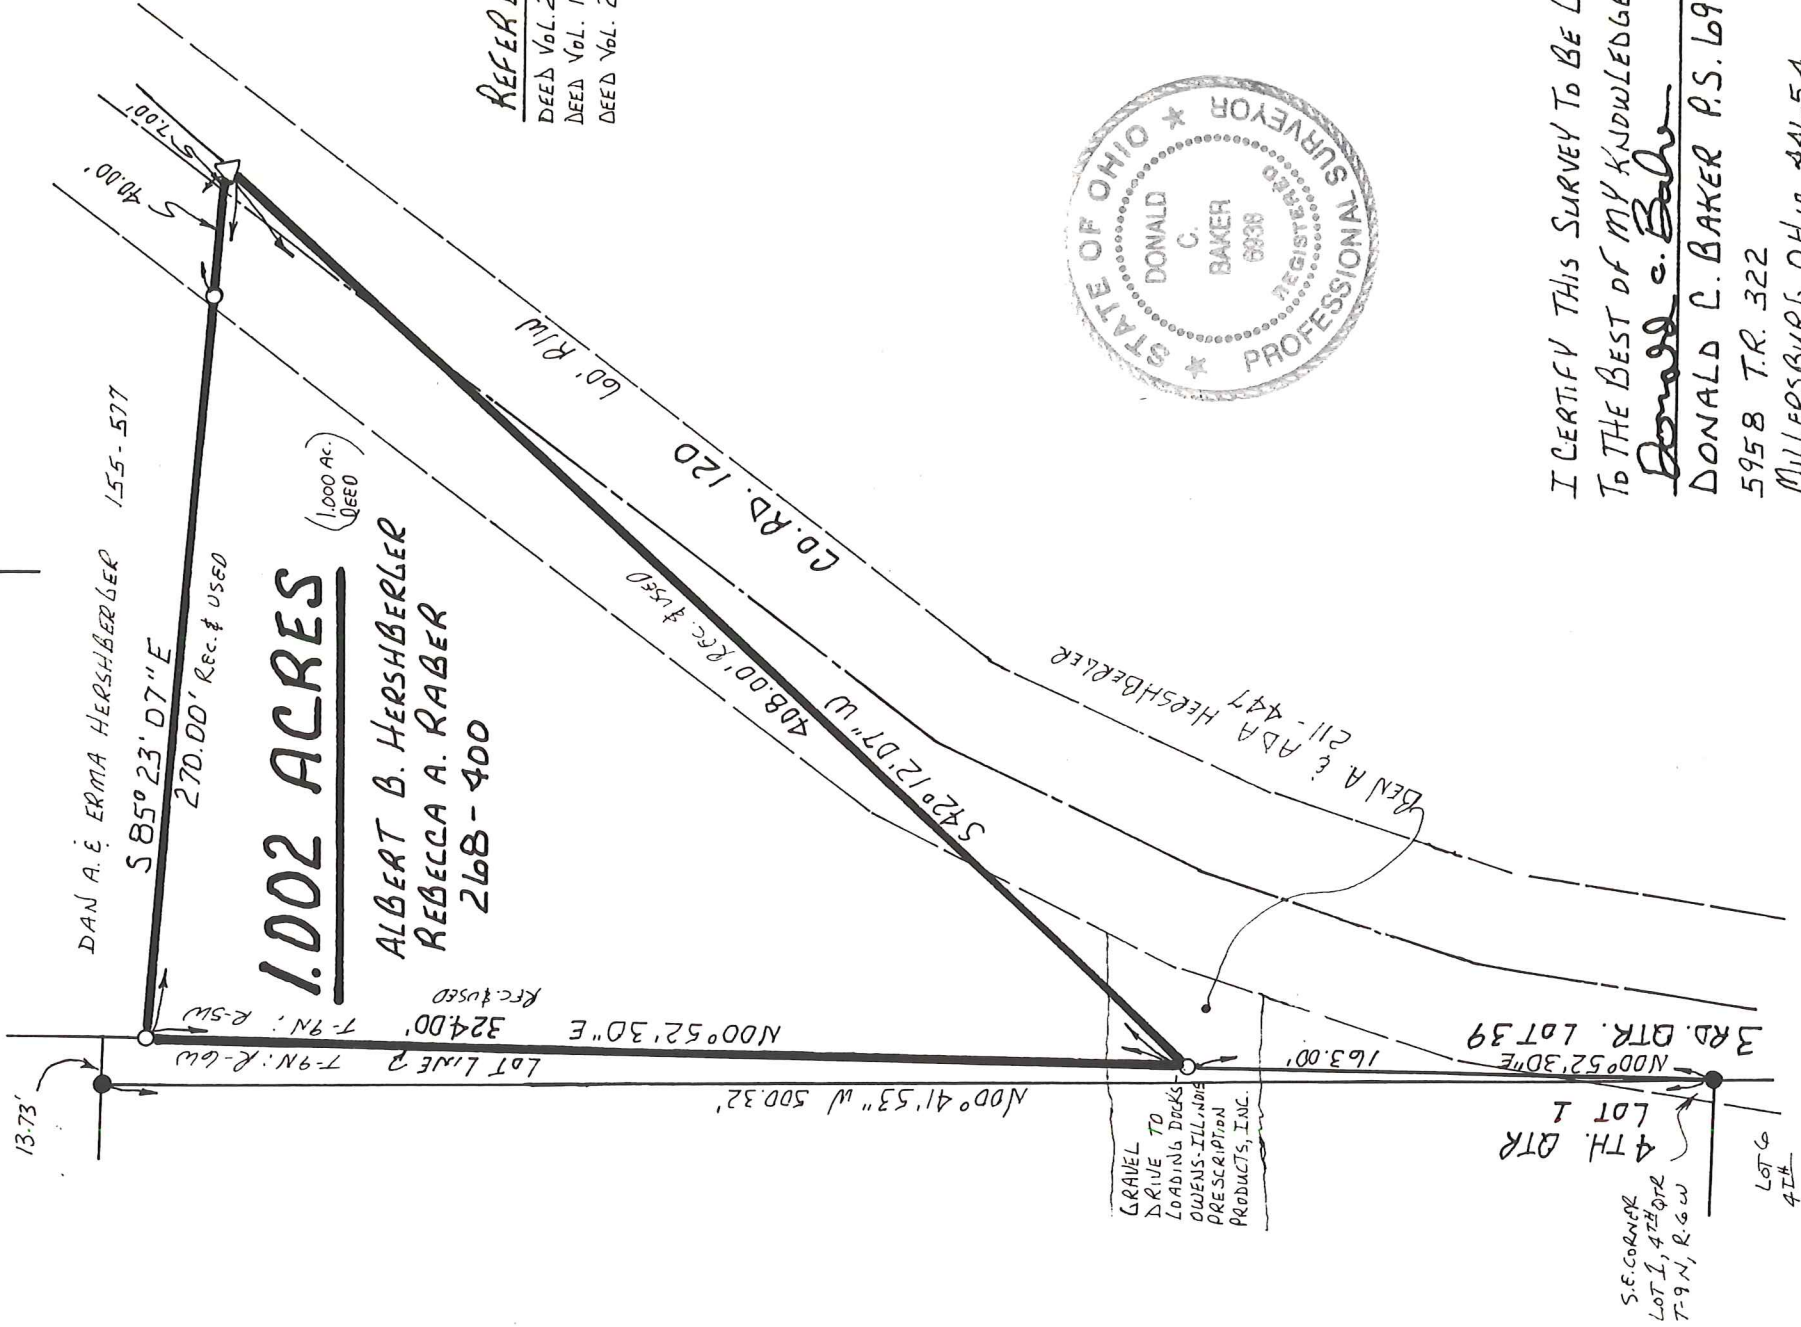


BERLIN TOWNSHIP  
 3RD. QTR. LOT 39  
 T-9N; R-5W  
 HOLMES COUNTY, OHIO

SURVEYED FOR ALBERT B. HERSHBERGER

RESURVEY OF DEED VOL. 268 PAGE 400

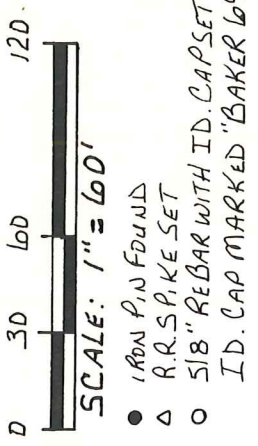

REFERENCES:

- DEED VOL. 268 PAGE 400
- DEED VOL. 155 PAGE 577
- DEED VOL. 211 PAGE 447



I CERTIFY THIS SURVEY TO BE CORRECT  
 TO THE BEST OF MY KNOWLEDGE.

*Donald C. Baker*  
 DONALD C. BAKER P.S. 6938

5958 T.R. 322  
 MILLERSBURG, OHIO 44654  
 PH. (330) 674-4788  
 JANUARY 7, 1997

1797-SRU  
 F.C.C. - D.C. BAKER