
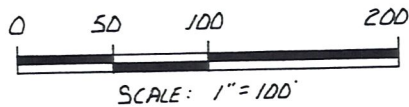



BERLIN TOWNSHIP
SECTION 5, T-9N;R-5W
HOLMES COUNTY, OHIO

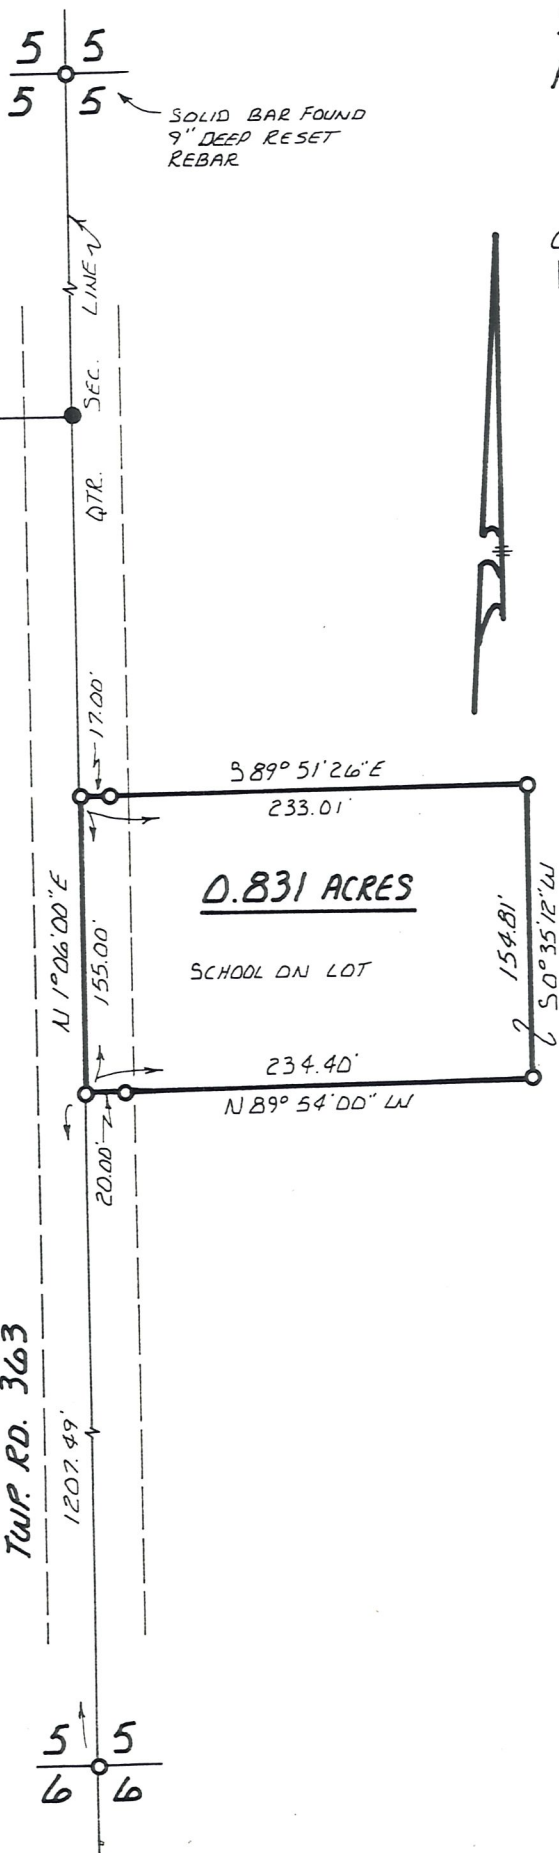

- IRON PIN FOUND
- 5/8" REBAR WITH I.D. CAP SET

REFERENCES:
SURVEY RECORD 4 PAGE 29
BEARINGS FROM PLAT VOL. 10
PAGE 382

LEVI J. & EFFIE TROYER
DEED VOL. 219 PAGE 176

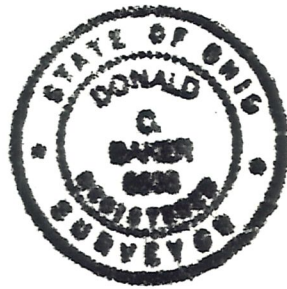

I CERTIFY THIS SURVEY TO BE CORRECT
TO THE BEST OF MY KNOWLEDGE.

Donald C. Baker
DONALD C. BAKER P.S. 6938
4321 T.R. 252
GLENMONT, OH. PH. 377-4177

OCT. 20, 1987