BERLIN TOWNSHIP
HOLMES COUNTY, OHIO
N.W. QTR., SEC. 7, T-9N, R-5W

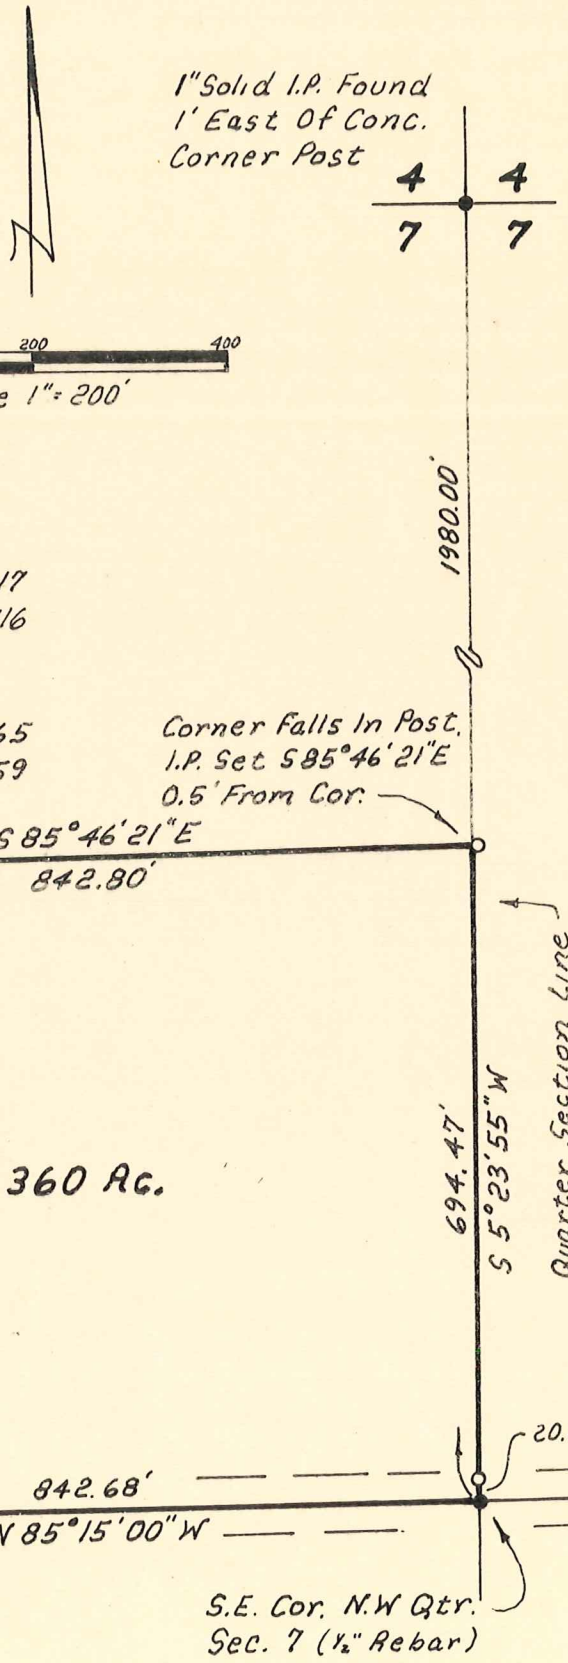

I Certify This Survey To Be Correct
To The Best Of My Knowledge.

Donald G. Long August 17, 1989

Donald G. Long P.S. 7115
LONG SURVEYING INC.
12524 Co. Rd. 6
Killbuck Ohio 44637

STATE OF OHIO
DONALD G. LONG
7115
REGISTERED PROFESSIONAL SURVEYOR