


SURVEY of In Lot 10
VILLAGE OF BERLIN

NW QUARTER SECTION 15

T-9-N, R-5-W

Berlin Township

HOLMES COUNTY, OHIO

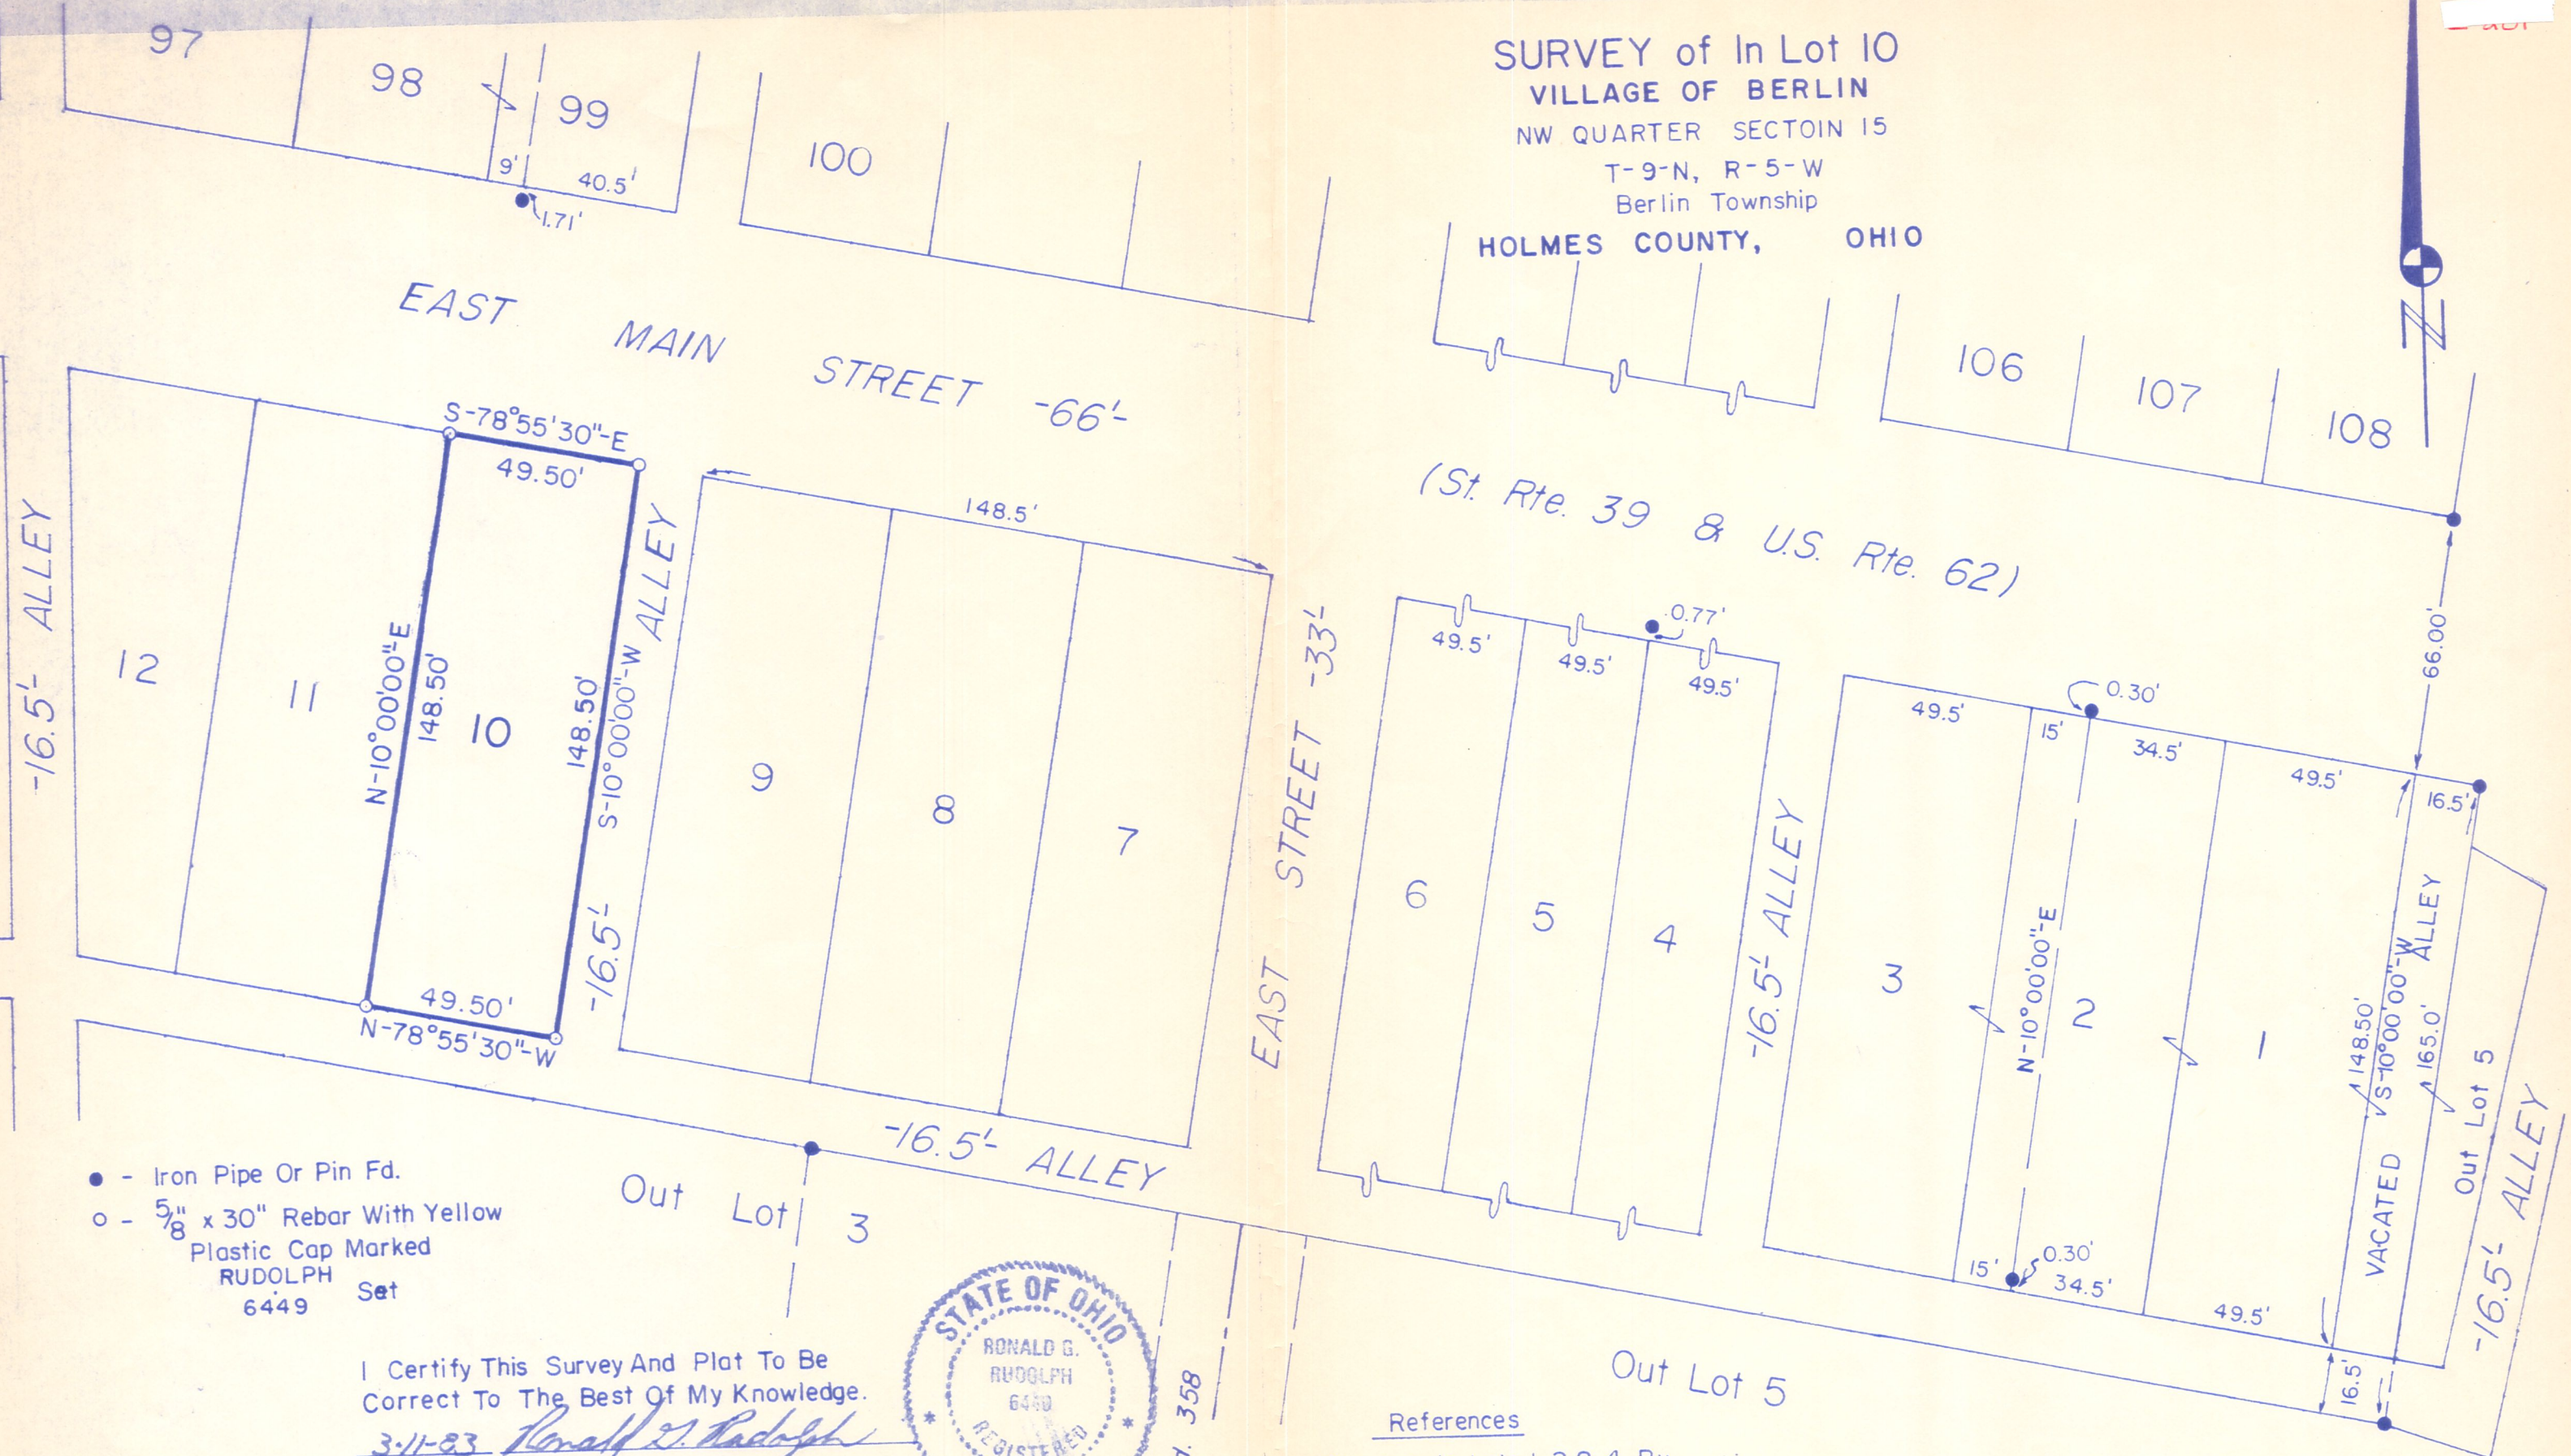

- - Iron Pipe Or Pin Fd.
 - - 5/8" x 30" Rebar With Yellow Plastic Cap Marked
- RUDOLPH
6449 Set

I Certify This Survey And Plat To Be Correct To The Best Of My Knowledge.

3-11-83 *Ronald G. Rudolph*

Date Ronald G. Rudolph - Reg. Surv. 6449
R.G. RUDOLPH SURVEYING, Inc.
405 W. Liberty St.
Wooster, Ohio 44691




Twp. Rd. 358

Job No. 1000

References

Surveys in Lots 1, 2 & 4 By
William Long Nov. 1981 and May 1982

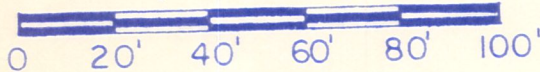

Scale: 1" = 40'