PLAT OF A SURVEY FOR THE BERLIN TOWNSHIP TRUSTEES

LOCATION OF OHIO POWER CO. POLE NO. 1097C36

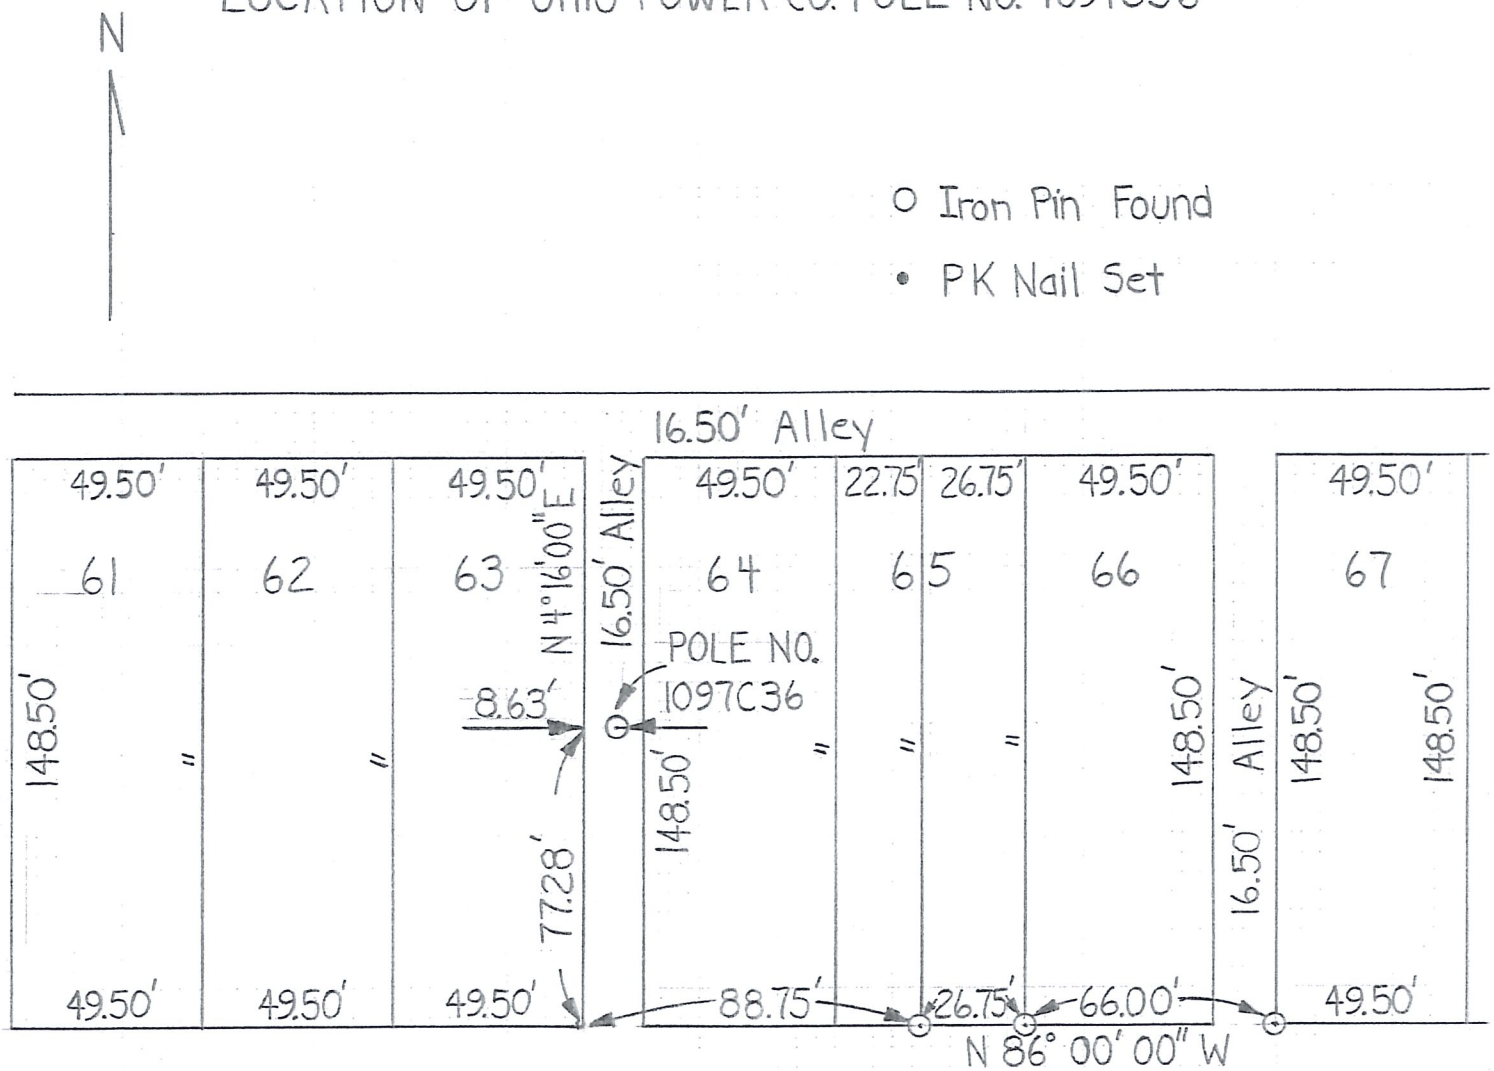

Scale : 1" = 20'

Robert L. Kasner P.S. 5193, P.E. 28820

HOLMES COUNTY ENGINEER

8/13/85