

- SCALE: 1" = 20'
- IRON PIN FOUND
 - PROPERTY LINE
 - ////// BUILDING LINE
 - ▨ COMMON AREA
 - ▨ LIMITED COMMON AREA
 - UNIT LINE

PREPARED FOR:
 DUTCH COUNTRY CONDOMINIUMS
 5474 S. MARKET ST.
 BERLIN, OH 44610


PREPARED BY:
 DONALD C. BAKER SURVEYING
 138 N. CLAY ST.
 MILLERSBURG, OHIO 44654
 PH. (330) 674-4788

OWNER:
 SUE MULLET
 DEED VOL. 221 PAGE 181


SITE PLAN

DUTCH COUNTRY CONDOMINIUMS

VILLAGE OF BERLIN
 LOT 25 & PART OF LOT 26
 HOLMES COUNTY, OHIO

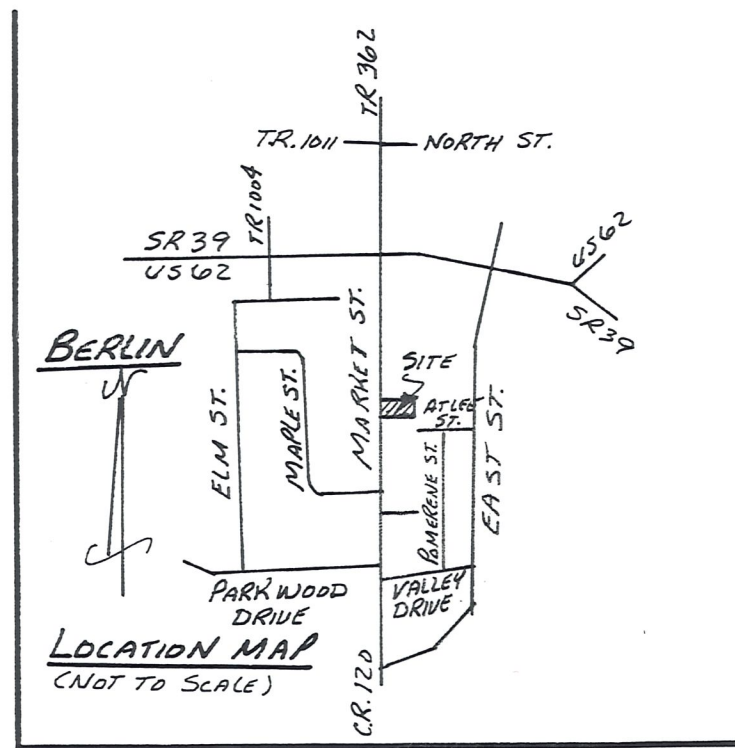

LOT 24

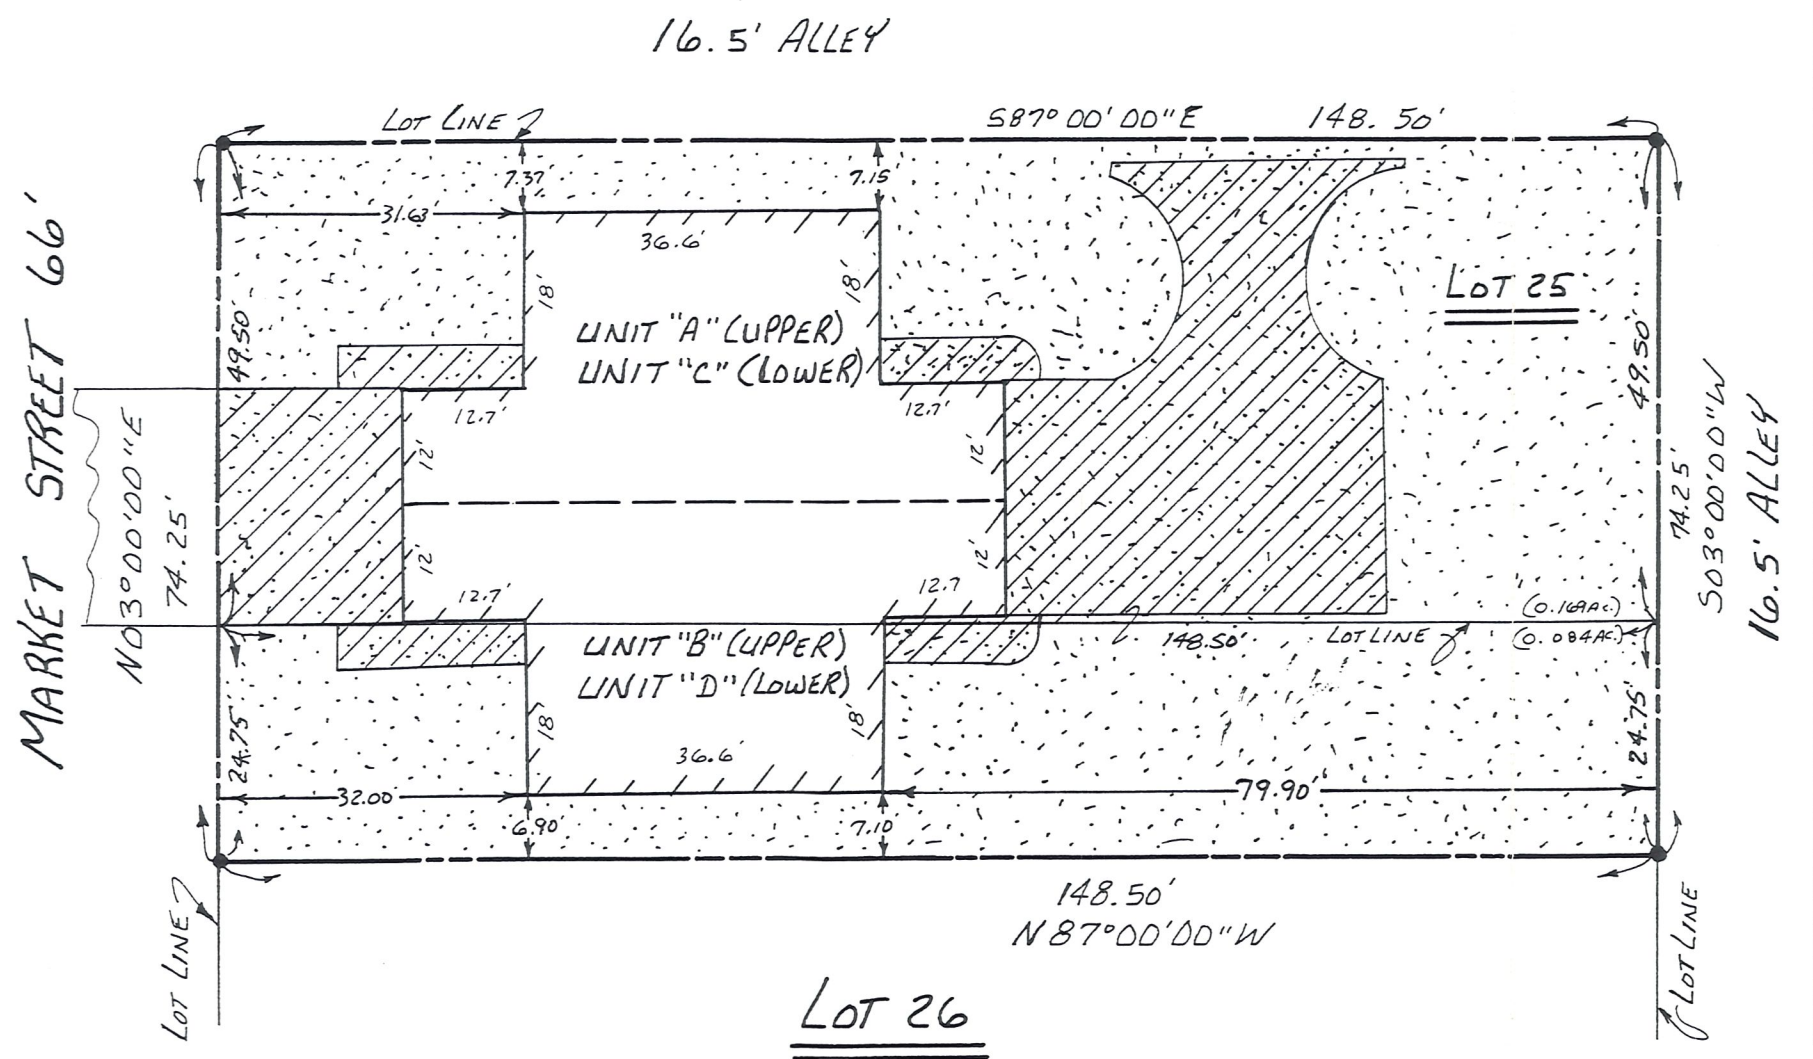

I CERTIFY THAT THE BUILDING IS LOCATED ON THE TRACT OF LAND AS INDICATED AND THE BUILDING IS CONSTRUCTED AS SHOWN ON THIS PLAN.

Donald C. Baker
 DONALD C. BAKER P.S. 6938
 138 N. CLAY ST.
 MILLERSBURG, OHIO 44654
 PH. 330/674-4788
 AUG. 8, 1997

RECEIVED
 AUG 11 1997
 Hol. Co. Tax Map Office