HEARTLAND SURVEYING, INC

Jim Shamp
5210 T.R. 257 MILLERSBURG, OH 44654
PH: 330-674-4698

SURVEY			STATE
DONALD R. & LINDA J. MERRIMAN			OHIO
COUNTY	TWP.	RNG.	TWP.
HOLMES	BERLIN	5 W	9 N
N.W. QUARTER OF SECTION 15 IN THE VILLAGE OF BERLIN (UNINCORPORATED)			PART OF OUTLOT 5

970812 5/98

NOTE: THIS IS A RETRACEMENT SURVEY AND IS FOR INFORMATION ONLY.

NORTH

BEARINGS EST. FROM D.V. 271/991 AND ARE TO DENOTE ANGULAR MEAS. ONLY.

LEGEND:
- □ = STONE FD.
- ● = 5/8" RE-BAR FD. UNLESS NOTED
- ○ = POINT-OF-DEPARTURE
- ○ = 5/8" X 30" RE-BAR W/PLASTIC I.D. CAP SET
- ⊠ = R/R SPIKE SET
- △ = R/R SPIKE FD.

REFERENCE DOCUMENTS:
TAX MAPS
DEEDS AS SHOWN
SURVEY PLATS: 3/44B

50 0 50 100 150
GRAPHIC SCALE - FEET 1" = 50'

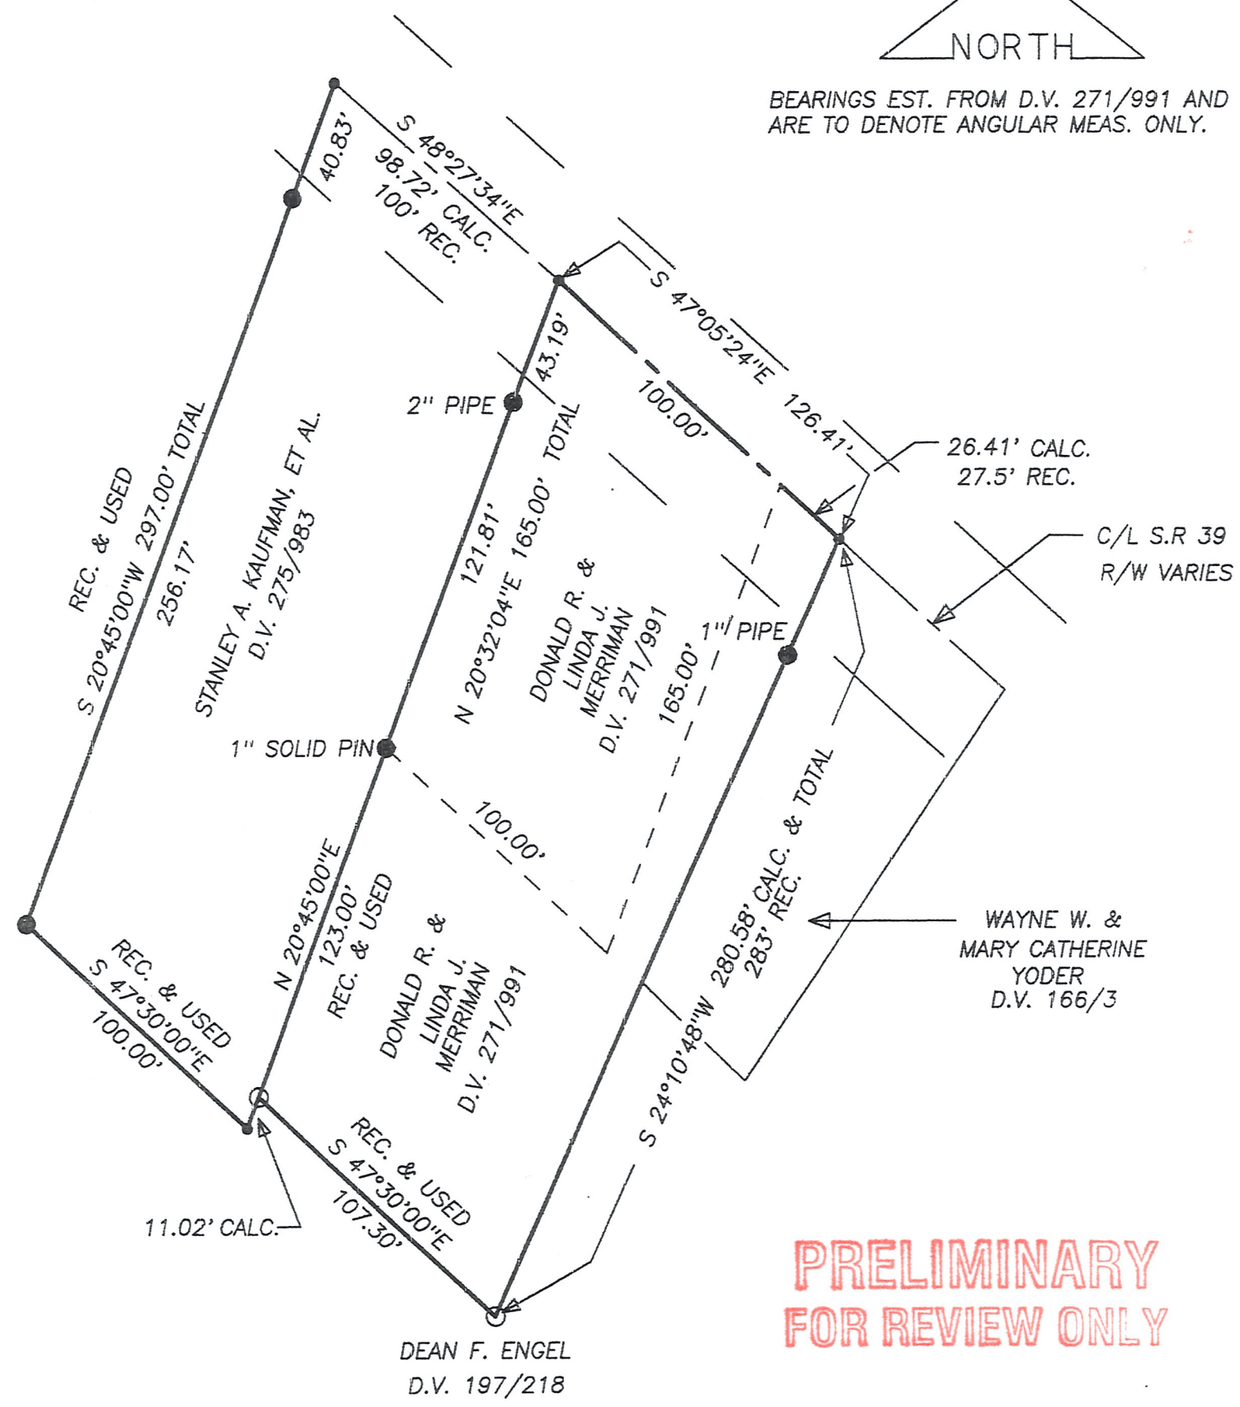

I CERTIFY THIS PLAT & SURVEY TO BE CORRECT TO THE BEST OF MY KNOWLEDGE:

JIM SHAMP, REG. SUR. NO. S-6088 — DATE: AUGUST 11, 1997

STATE OF OHIO
JIM SHAMP
6088
REGISTERED PROFESSIONAL SURVEYOR

PRELIMINARY
FOR REVIEW ONLY