


FEB 4 '13 AM 8:28

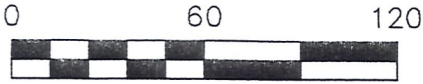

SCALE: 1"=60'


- DRILL HOLE FOUND
- 5/8" REBAR FOUND UNLESS OTHERWISE NOTED
- △ R.R. SPIKE SET
- 5/8" REBAR SET WITH I.D. CAP I.D. CAP MARKED "BAKER 6938"

VILLAGE OF BERLIN  
 LOT 105 &  
 PART OF LOT 104

BERLIN TOWNSHIP  
 N.W. QTR. SECTION 15  
 T-9 N; R-5 W  
 HOLMES COUNTY, OHIO


SURVEY SHOWING PROPERTY CORNERS SET  
 AND SHALL NOT BE USED FOR CONVEYANCE  
 /TRANSFER PURPOSES.

SURVEYED FOR: ROBERT MILLER

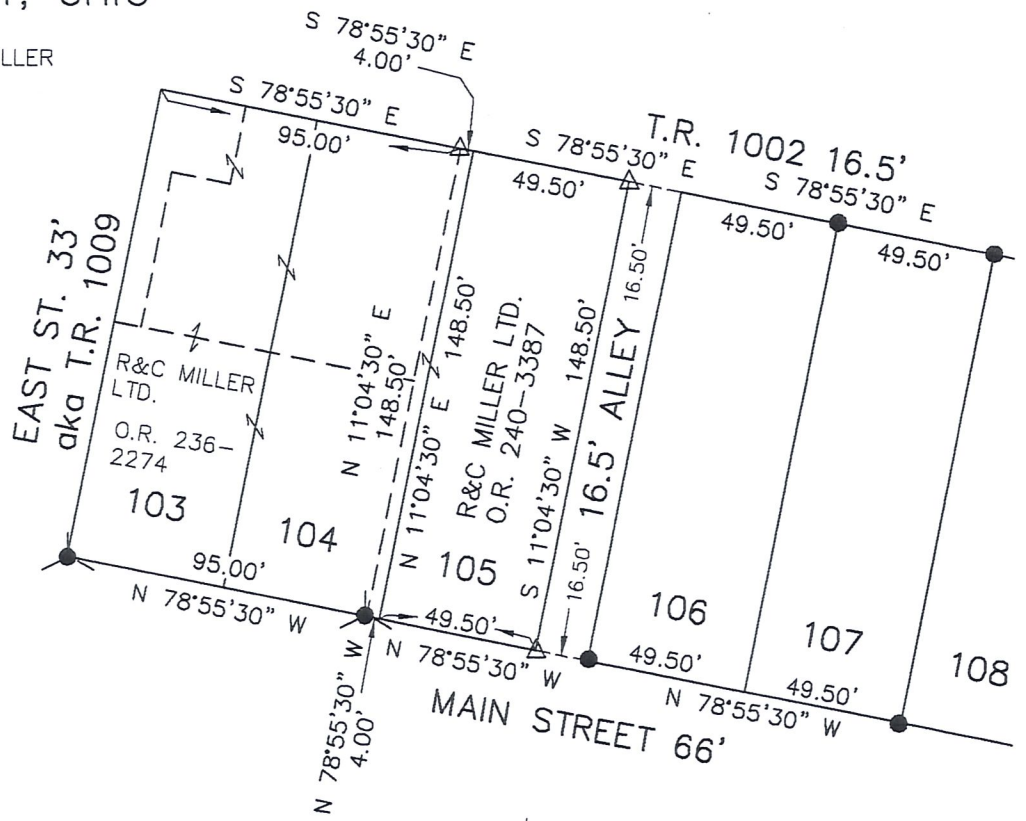

REFERENCES

- O.R. VOL. 235 PAGE 2274
- O.R. VOL. 240 PAGE 3387
- PLAT VOL. 12 PAGE 203
- BEARINGS FROM PLAT VOL. 12 PAGE 203

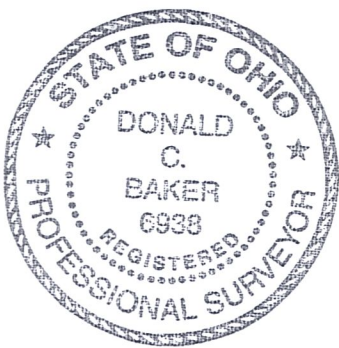

I CERTIFY THIS SURVEY TO BE CORRECT TO THE BEST OF MY KNOWLEDGE.

*Donald C. Baker*

DONALD C. BAKER P.S. 6938

DATE: JANUARY 28, 2013

KES\ACB

FILE NAME: WORK4\S-27-13\MLD

**PRELIMINARY  
FOR REVIEW ONLY**



DONALD C. BAKER SURVEYING  
 138 N. CLAY STREET  
 MILLERSBURG, OHIO 44654  
 PH. 330-674-4788  
 FAX 330-674-6027