

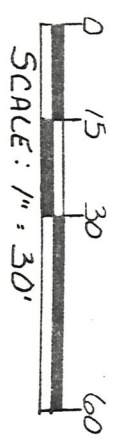


VILLAGE OF BERLIN  
 LOT 107  
 HOLMES COUNTY, OHIO

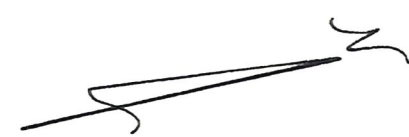

- 1/8" PIN FOUND
- 5/8" RE BAR WITH I.D. CAP SET
- I.D. CAP MARKED "BAKER 6938"

BEARINGS FROM PLAT 164.9  
 PAGE 219

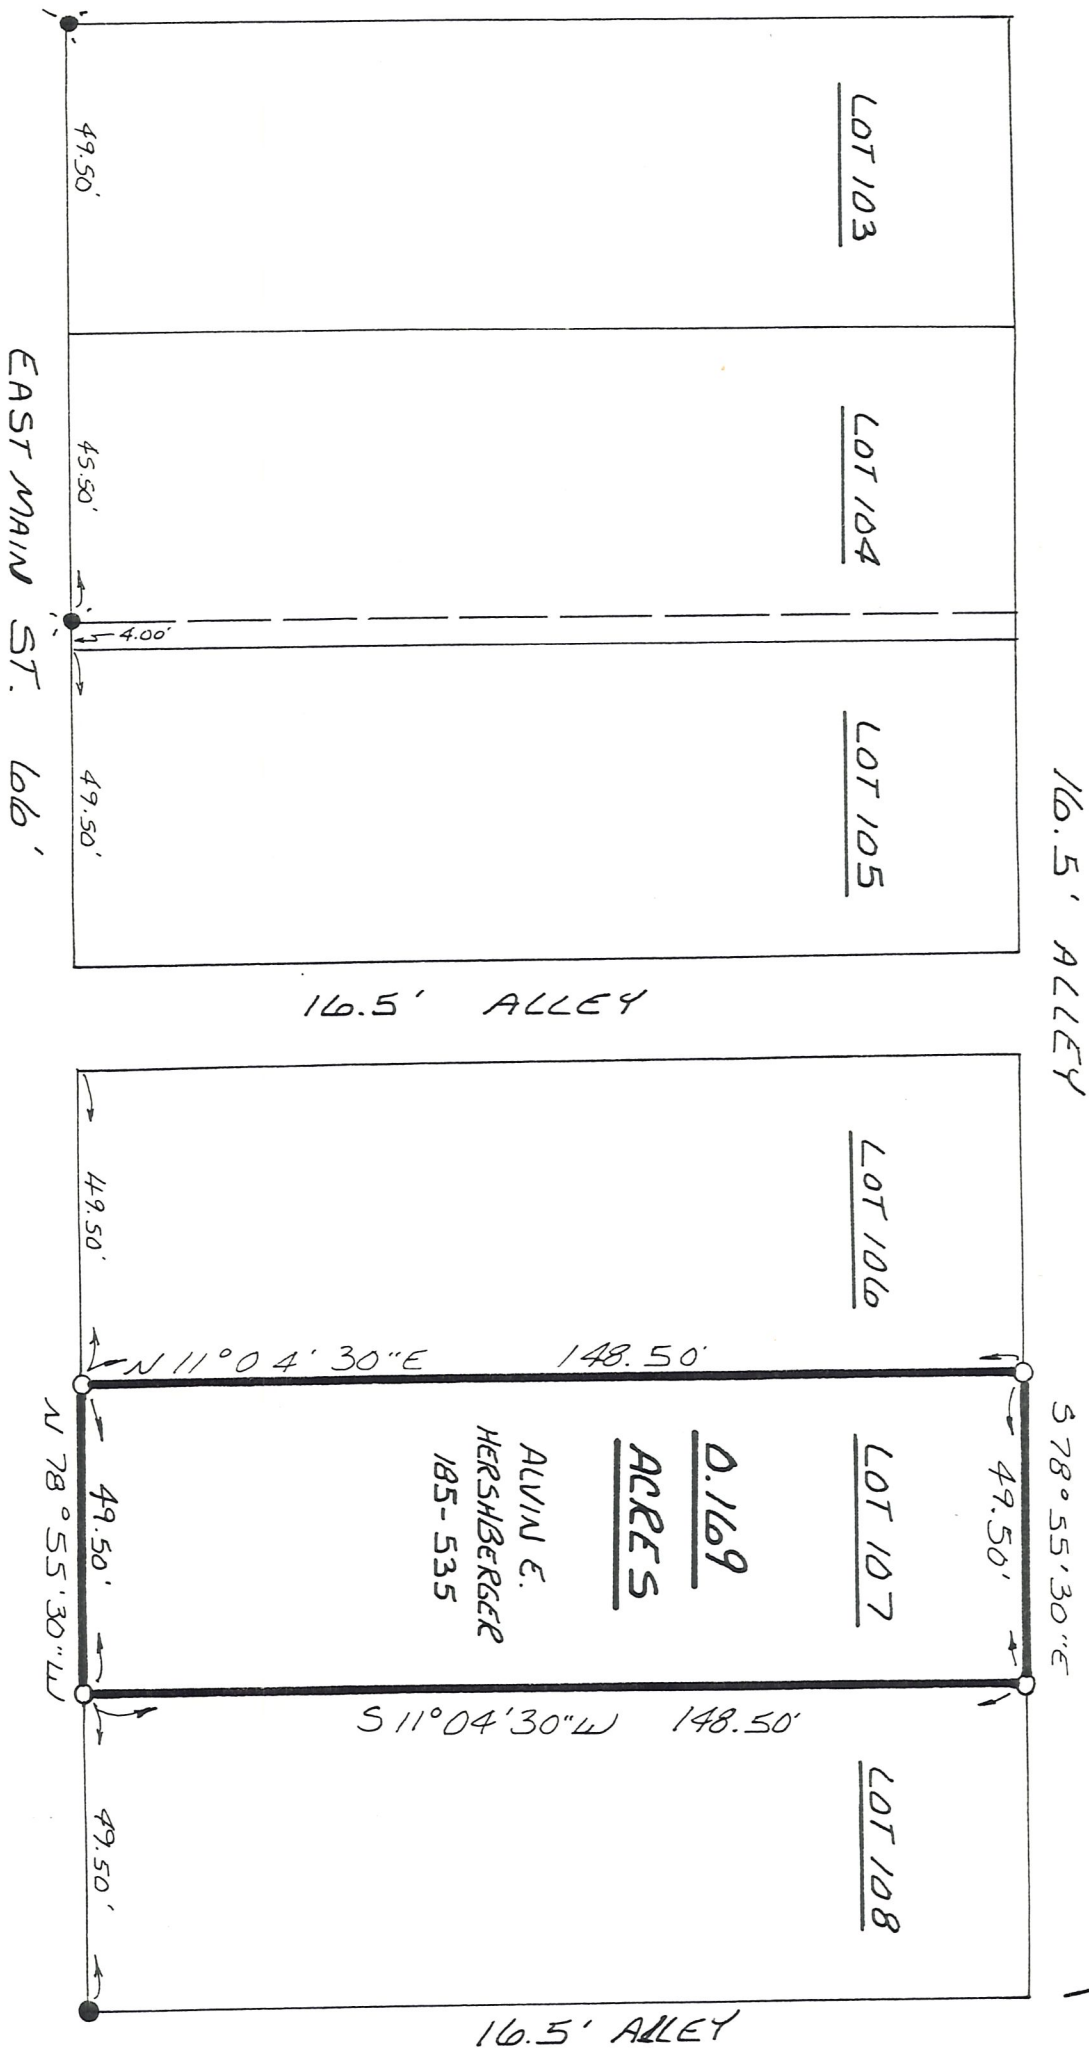

I CERTIFY THIS SURVEY TO  
 BE CORRECT TO THE BEST  
 OF MY KNOWLEDGE.  
Donald C. Baker  
 DONALD C. BAKER  
 P.S. 6938  
 4321 T.R. 252  
 GLENMOUNT, OHIO 44628

1892-MLS