BERLIN TOWNSHIP
1ST. QTR., LOT 2
T-9 N; R-6 W
HOLMES COUNTY, OHIO

SURVEYED FOR: RAY MILLER

REFERENCES

O.R. VOL. 128 PAGE 88
O.R. VOL. 190 PAGE 152

PLAT VOL. 17 PAGE 584

SURVEY RECORD 2 PAGE 406

BEARINGS FROM PLAT VOL. 17 PAGE 584

0 300 600

SCALE: 1"=300'

▲ R.R. SPIKE FOUND

● 5/8" REBAR FOUND UNLESS OTHERWISE NOTED

○ 5/8" REBAR SET WITH I.D. CAP I.D. CAP MARKED "BAKER 6938"

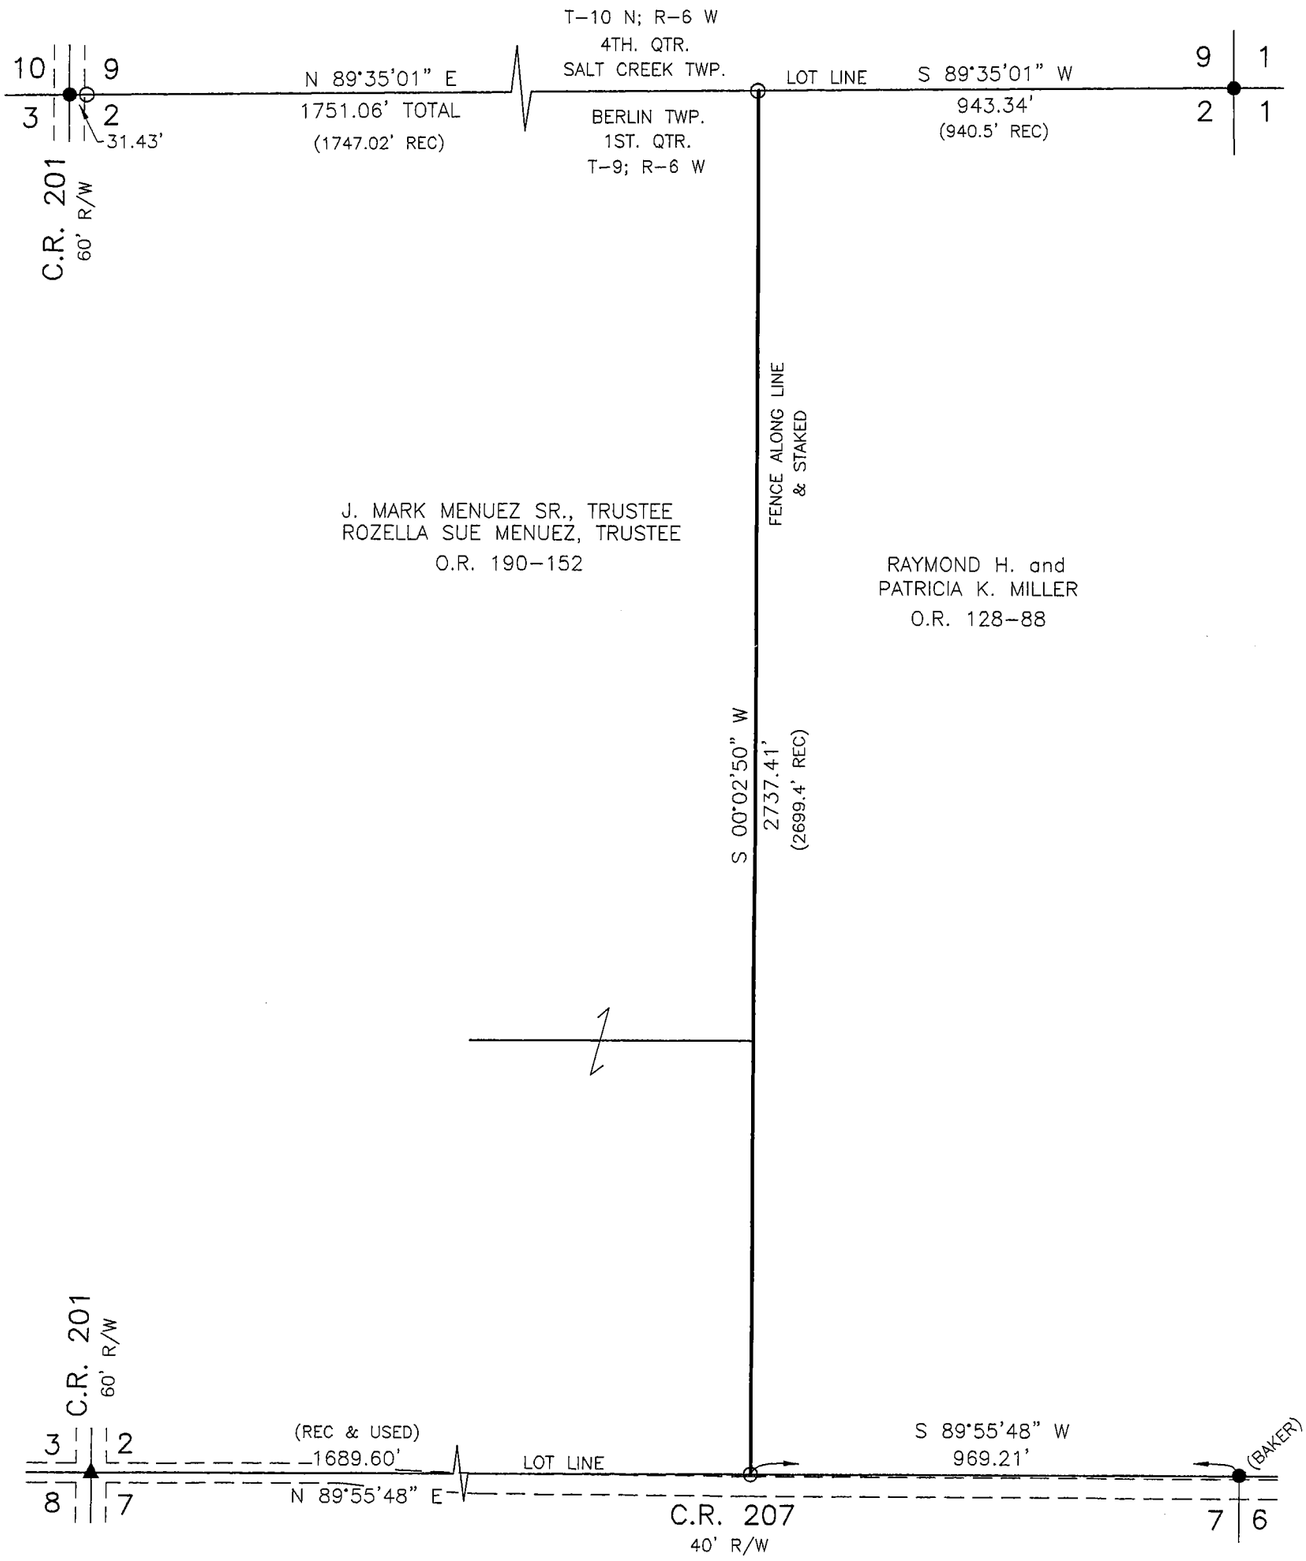

DONALD C. BAKER SURVEYING
138 N. CLAY STREET
MILLERSBURG, OHIO 44654
PH. 330-674-4788
FAX 330-674-6027

STATE OF OHIO
JAMIE D. DARR
7755
REGISTERED
PROFESSIONAL SURVEYOR

I CERTIFY THIS SURVEY TO BE CORRECT TO THE BEST OF MY KNOWLEDGE.

JAMIE D. DARR P.S. 7755

DATE: AUG. 28, 2007
JDD\AEG-DB
FILE NAME: WORK3\S-381-07\ERZ
INV: S-555-07