

BERLIN TOWNSHIP
 1ST. QTR., LOT 14
 T-9 N; R-6 W
 HOLMES COUNTY, OHIO

REFERENCES:
 DEED VOL. 201 PAGE 282
 " " 230 " 447
 BEARINGS FROM PLAT VOL.
 12 PAGE 76

0 50 100 200



SCALE: 1" = 100'

- IRON PIN FOUND
 - ▲ R.R. SPIKE FOUND
 - △ R.R. SPIKE SET
 - 5/8" RE BAR WITH I.D. CAP SET
 I.D. CAP MARKED "BAKER 6938"
- (SURVEYED FOR PAUL H. HOCHSTETLER)



RESURVEY OF TRACT #3 OF
 DEED VOL. 201 PAGE 282





I CERTIFY THIS SURVEY TO BE CORRECT
 TO THE BEST OF MY KNOWLEDGE.

Donald C. Baker

DONALD C. BAKER P.S. 6938
 138 N. CLAY ST.
 MILLERSBURG, OHIO 44654
 PH. (330) 674-4788
 JUNE 2, 1997

PAUL H. HOCHSTETLER
 230-447

DAN A. & BETTY E.
 MILLER
 201-282

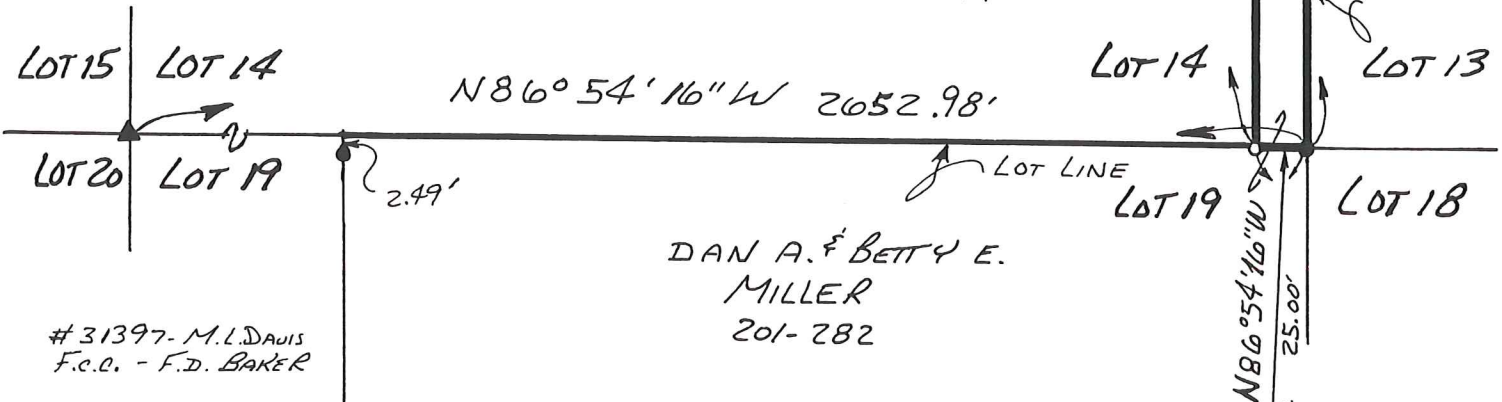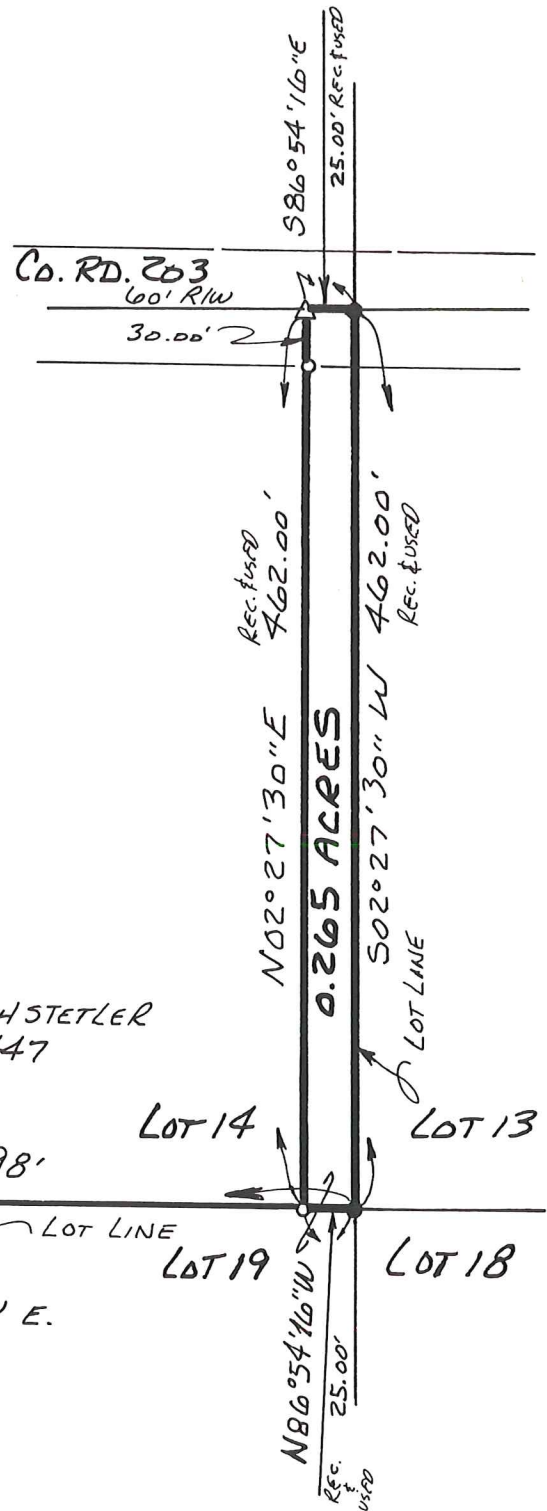

#31397 - M.L. DAVIS
 F.C.D. - F.D. BAKER