


Drawing of A Survey
 Part of Lot 21 Berlin Township
 Holmes County
 Township 9 North Range 6 West
 1st Quarter.

I certify that this drawing made
 from field notes of a survey made
 May 20 1960 for the owners Grace
 B Miller and Willard S. Miller
 to transfer 0.80 acres of land to
 L.L. Schlaubaugh.

Signed F.D. Krichbaum
 F.D. Krichbaum
 Orrville Ohio
 Registered Surveyor 1799
 State of Ohio
 Scale 1" = 60.0'

I Abe Yoder owner of land to
 west of 0.80 parcel of land
 directly west was present at time
 this survey was made and agree
 to this west line.

Signed Abe Yoder
 Abe Yoder

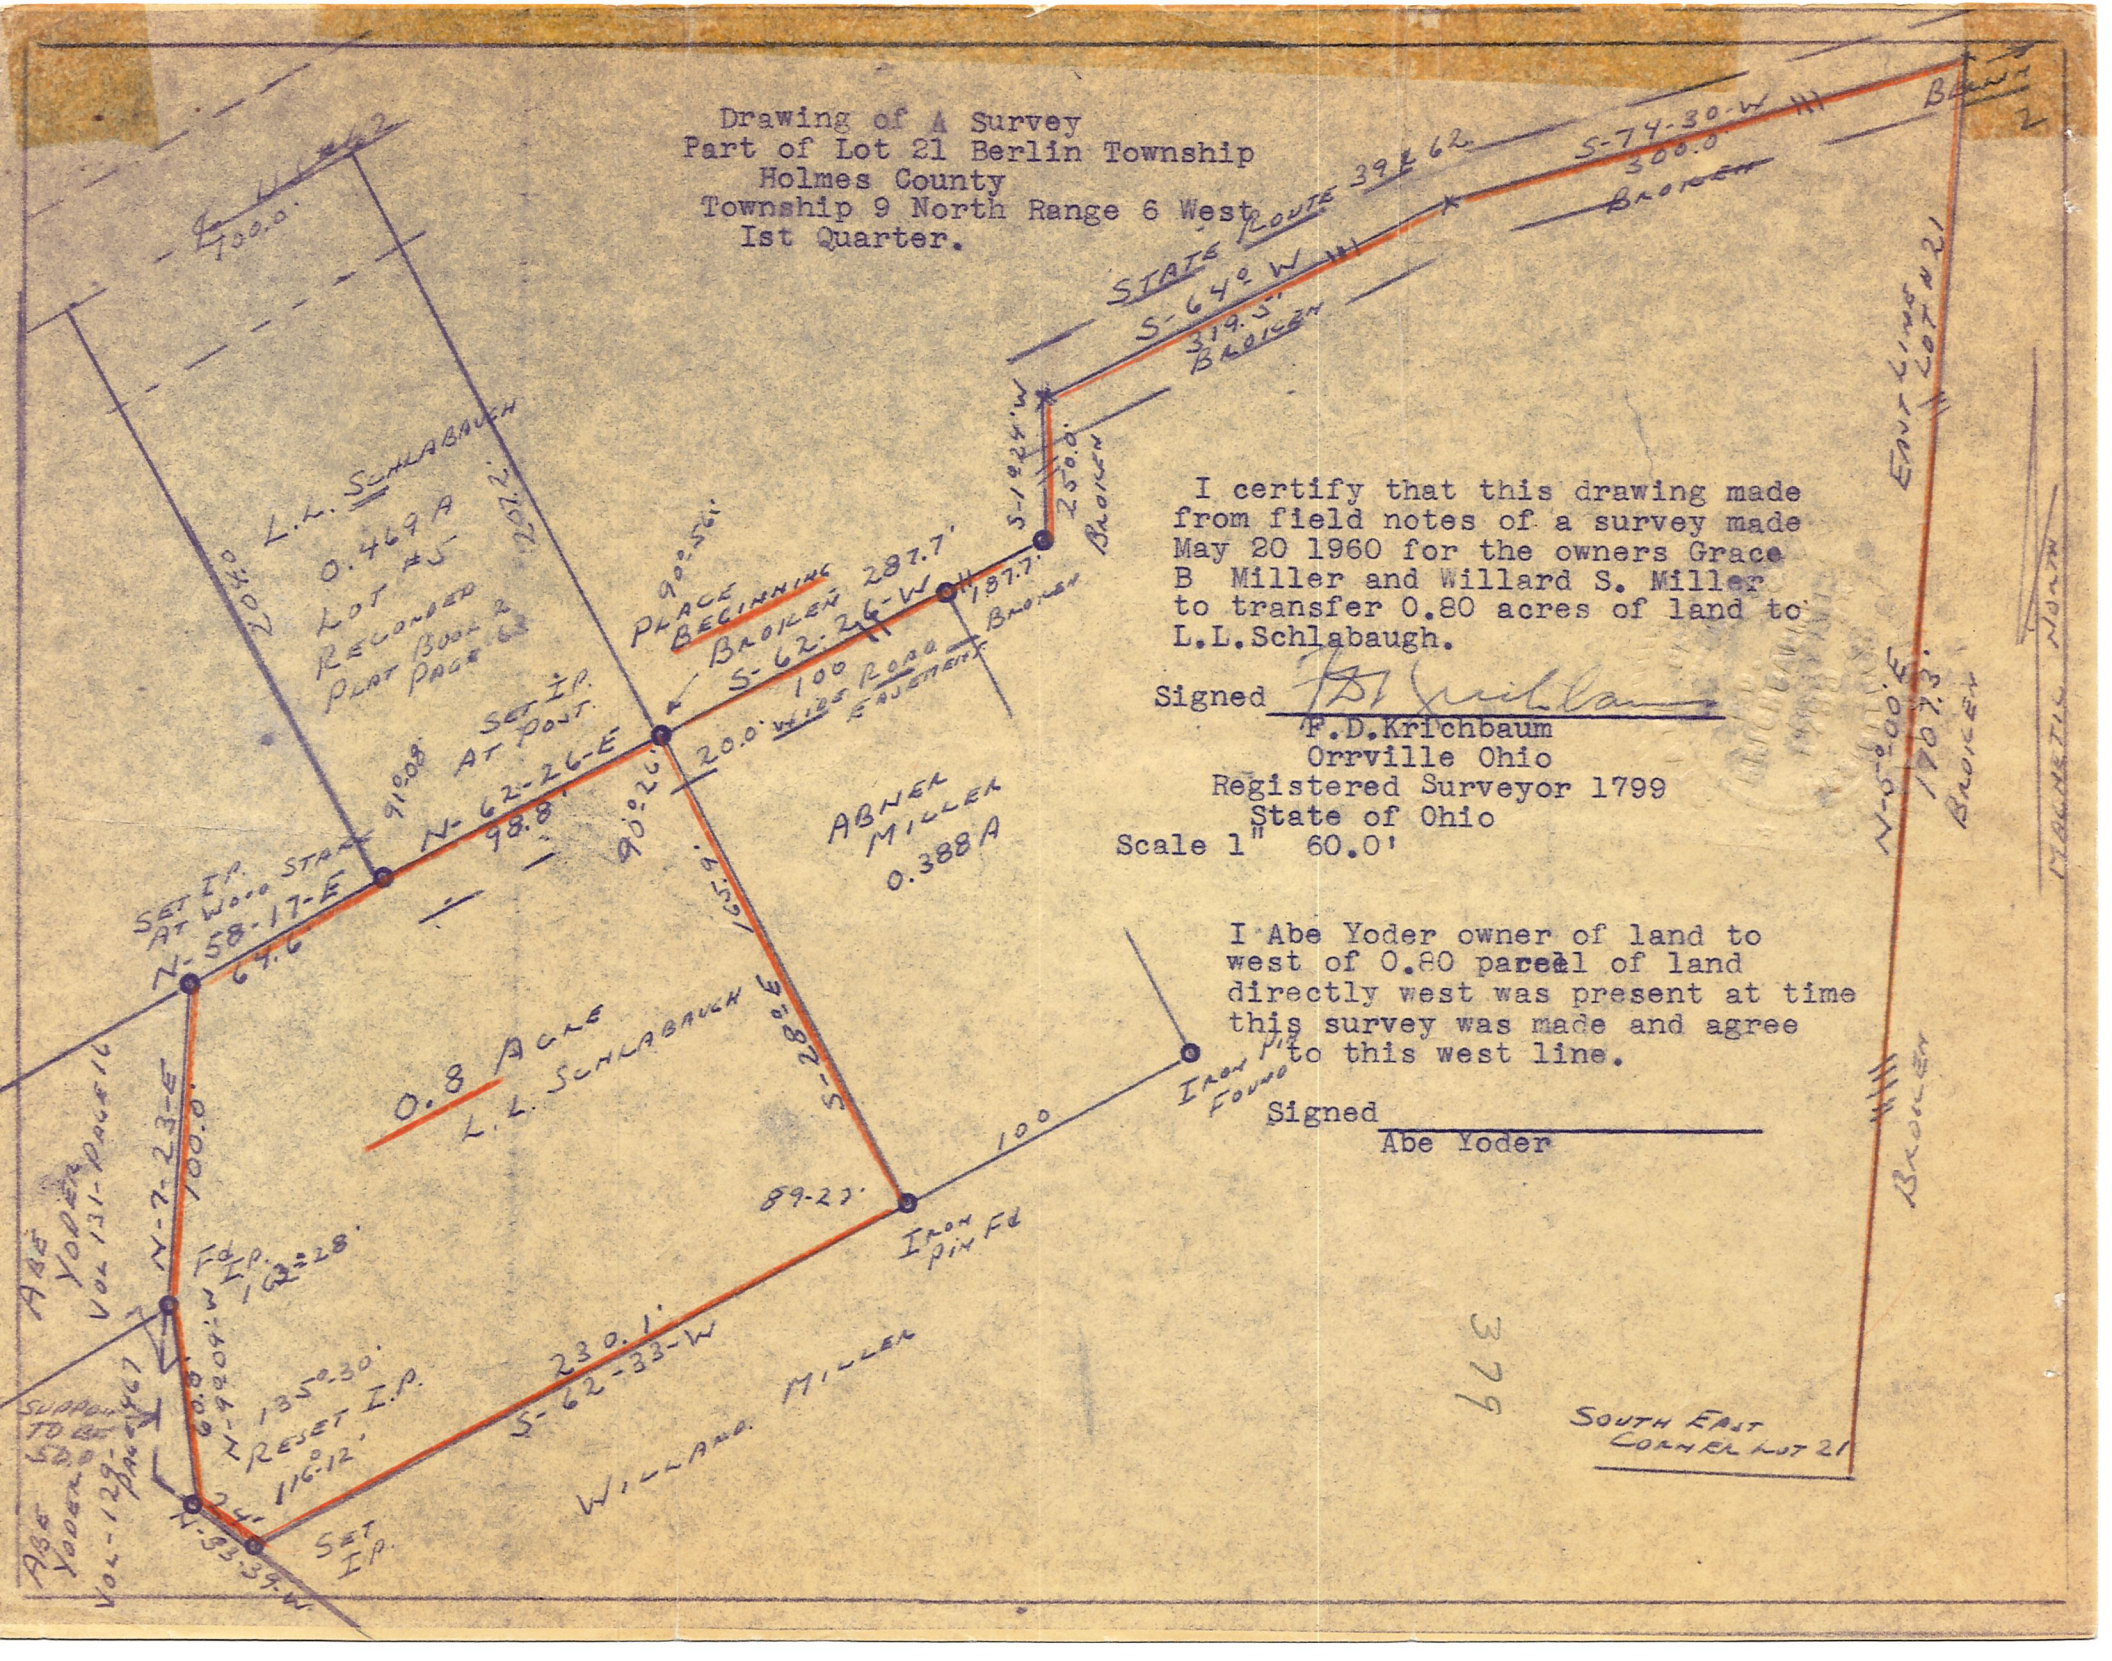

379

SOUTH EAST
 CORNER LOT 21