


LOT NO. 21 | 1ST QTR
 BERLIN TOWNSHIP
 T-9, R-6
 HOLMES COUNTY
 OHIO

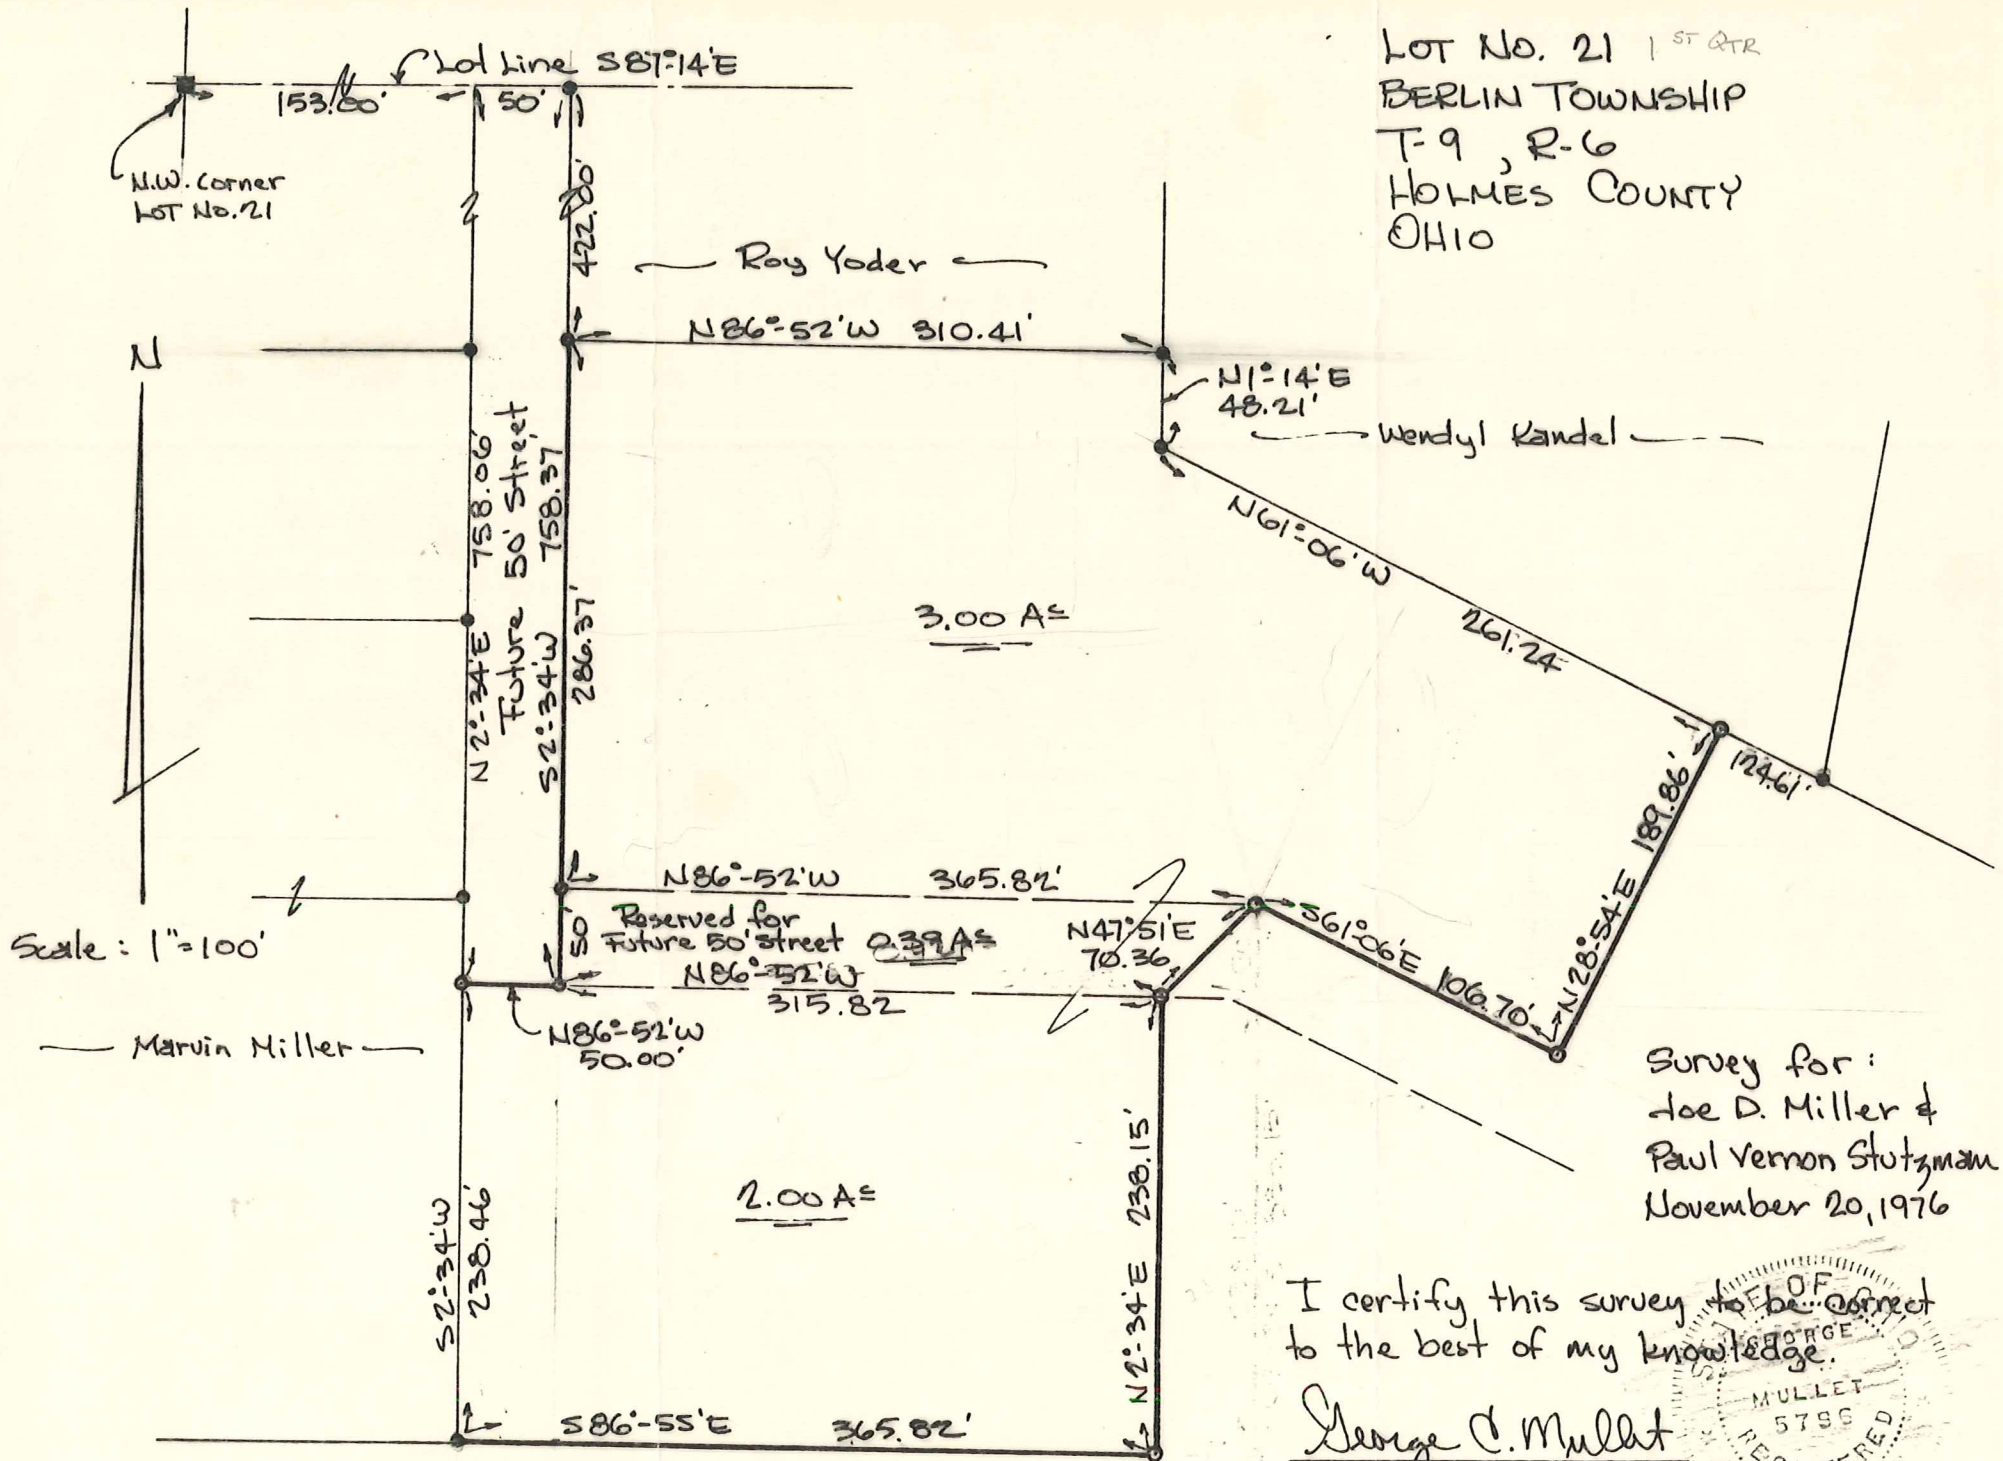

Survey for:
 Joe D. Miller &
 Paul Vernon Stutzman
 November 20, 1976

I certify this survey to be correct to the best of my knowledge.

George C. Mullett
 Reg. Sur. #5796

