


**THE COSHOCTON LAND SURVEYING SERVICE**

233 S. FOURTH ST.

COSHOCTON, OHIO 43812

BEING PART OF: LOT 1  
 SEC. 4th.  
 QUAR. 2  
 T9N, R6W  
 TOWNSHIP Berlin  
 COUNTY Holmes, Ohio, U.S.M.L.

SURVEY FOR: Berlin Mennonite Church  
 Carl Yoder Land  
 DATE: December, 1986  
 SCALE: 1" = 100'

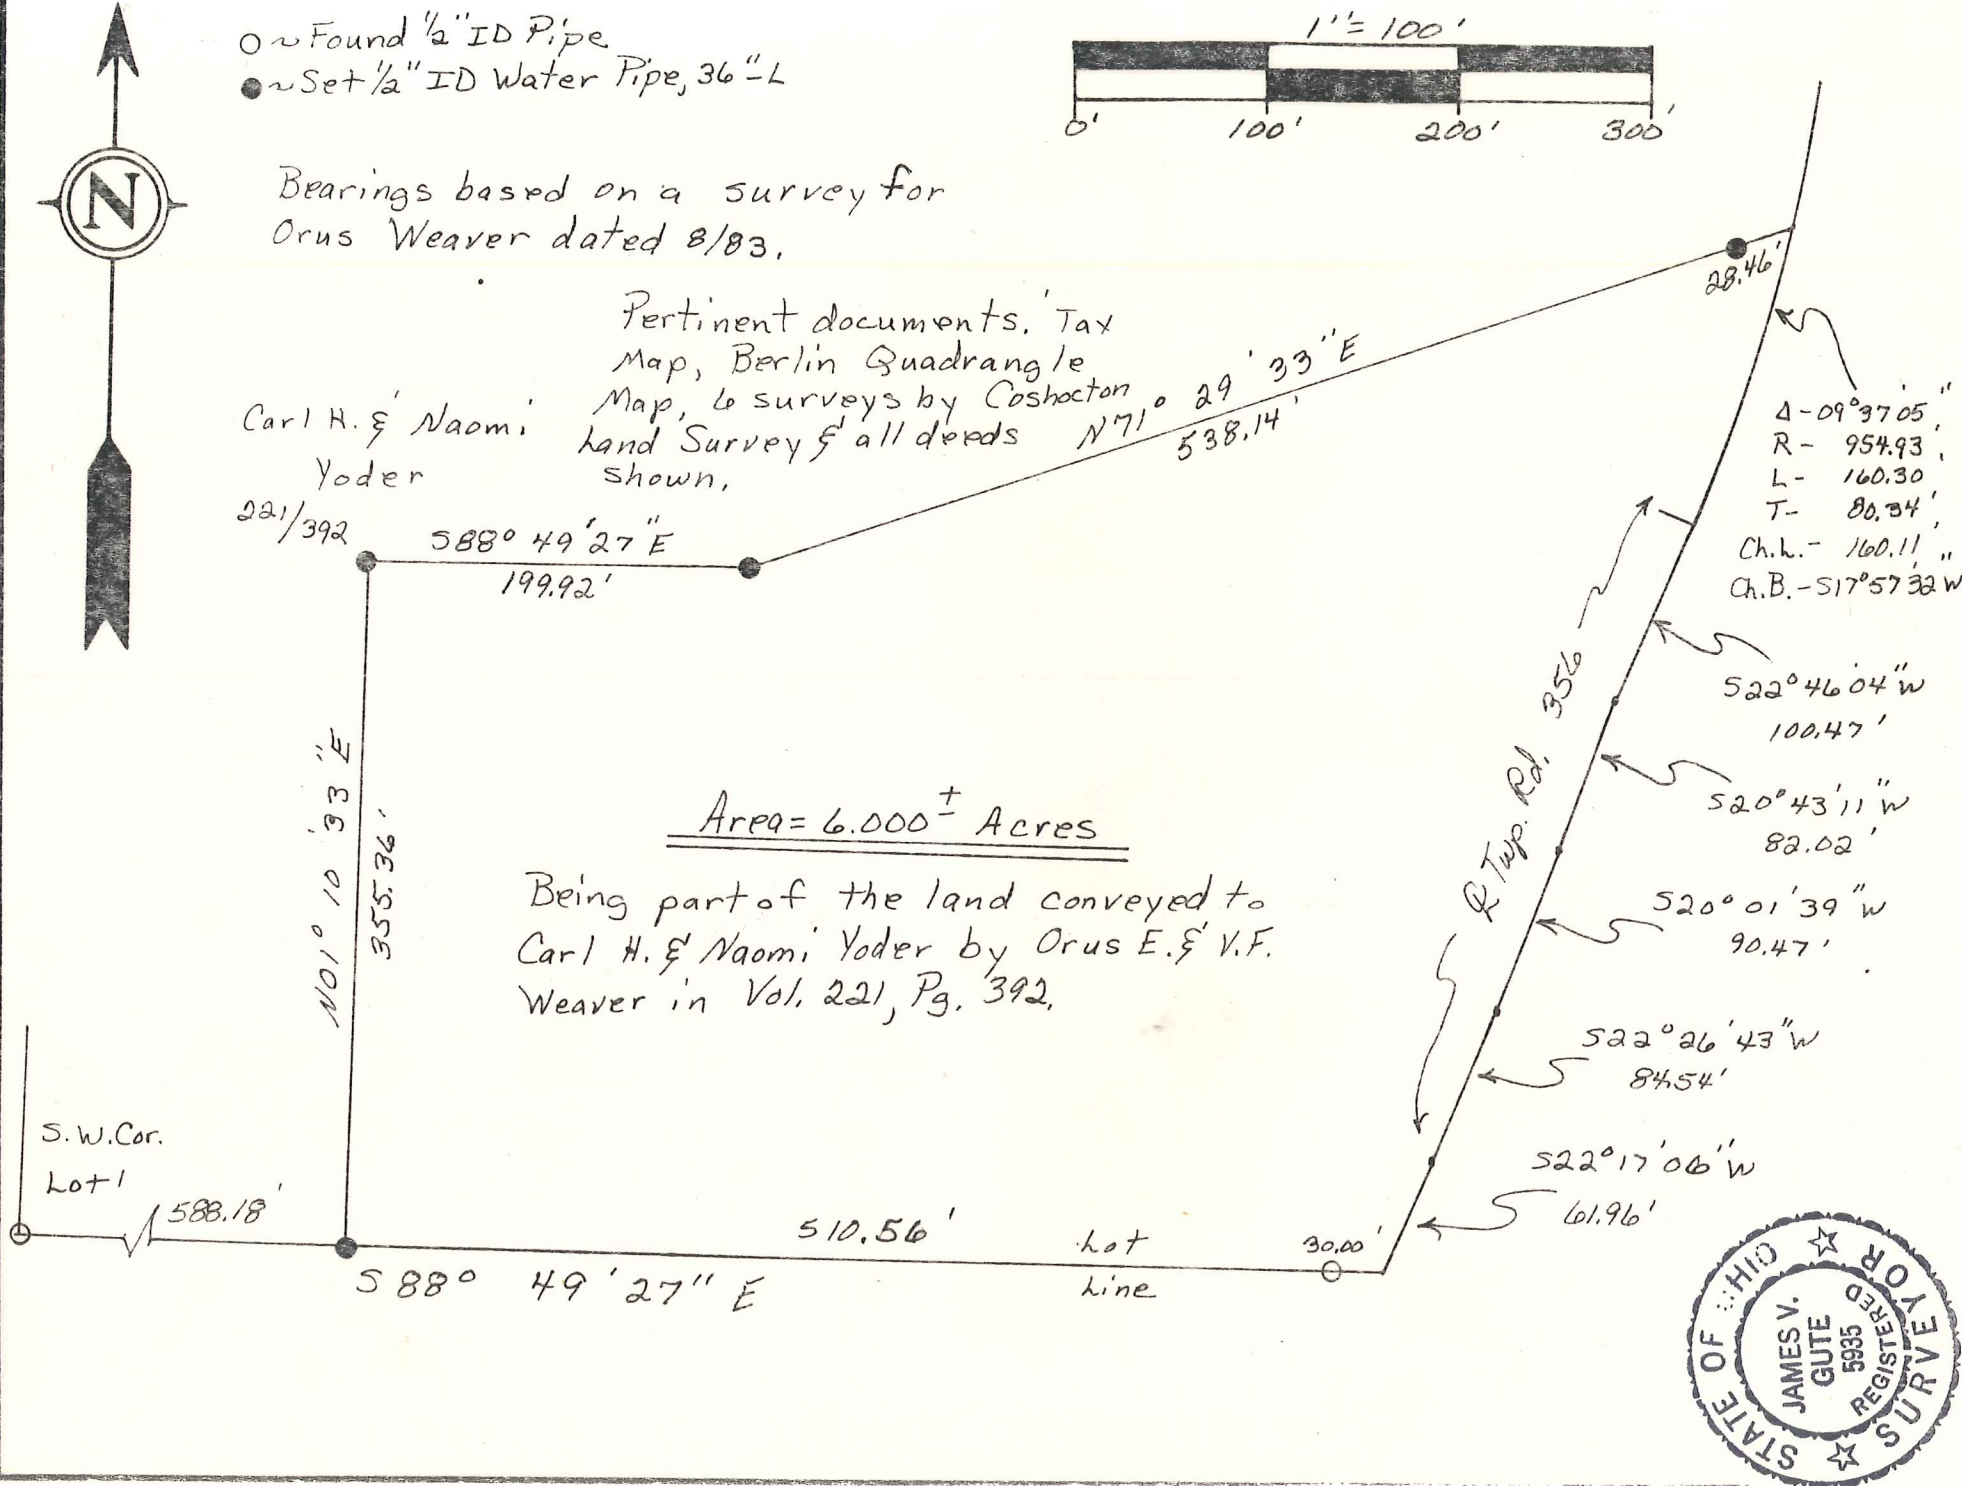

○ ~ Found 1/2" ID Pipe  
 ● ~ Set 1/2" ID Water Pipe, 36" L

Bearings based on a survey for Orus Weaver dated 8/83.

Pertinent documents, Tax Map, Berlin Quadrangle Map, 6 surveys by Coshocton Map, to surveys by Carl H. & Naomi Yoder land Survey of all deeds shown, N 71° 29' 33" E 538.14'

Area = 6.000<sup>±</sup> Acres

Being part of the land conveyed to Carl H. & Naomi Yoder by Orus E. & V.F. Weaver in Vol. 221, Pg. 392.

I hereby certify the above plat to be correct to the best of my knowledge and belief.

Subject To All Easements  
 And Rights-Of-Way, Public  
 And Private, Of Record

THE COSHOCTON LAND SURVEYING SERVICE

*James V. Gute*  
 REGISTERED SURVEYOR 5935



FB96, P3437 52, F26-27