

BERLIN TOWNSHIP  
 4TH. QTR. LOT 2  
 T. 9N; R. 6W  
 HOLMES COUNTY, OHIO





SCALE: 1" = 60'

- IRON PIN FOUND
- 5/8" RE BAR WITH I.D. CAP SET  
I.D. CAP MARKED "BAKER 6938"

**REFERENCES:**

DEED VOL. 143 PAGE 259  
 PLAT VOL. 10 PAGE 131  
 DEED VOL. 234 PAGE 259

BEARINGS FROM DEED VOL. 143 PAGE 259

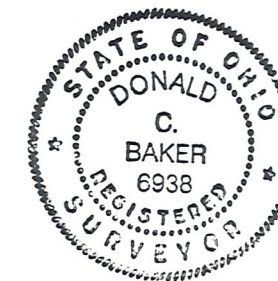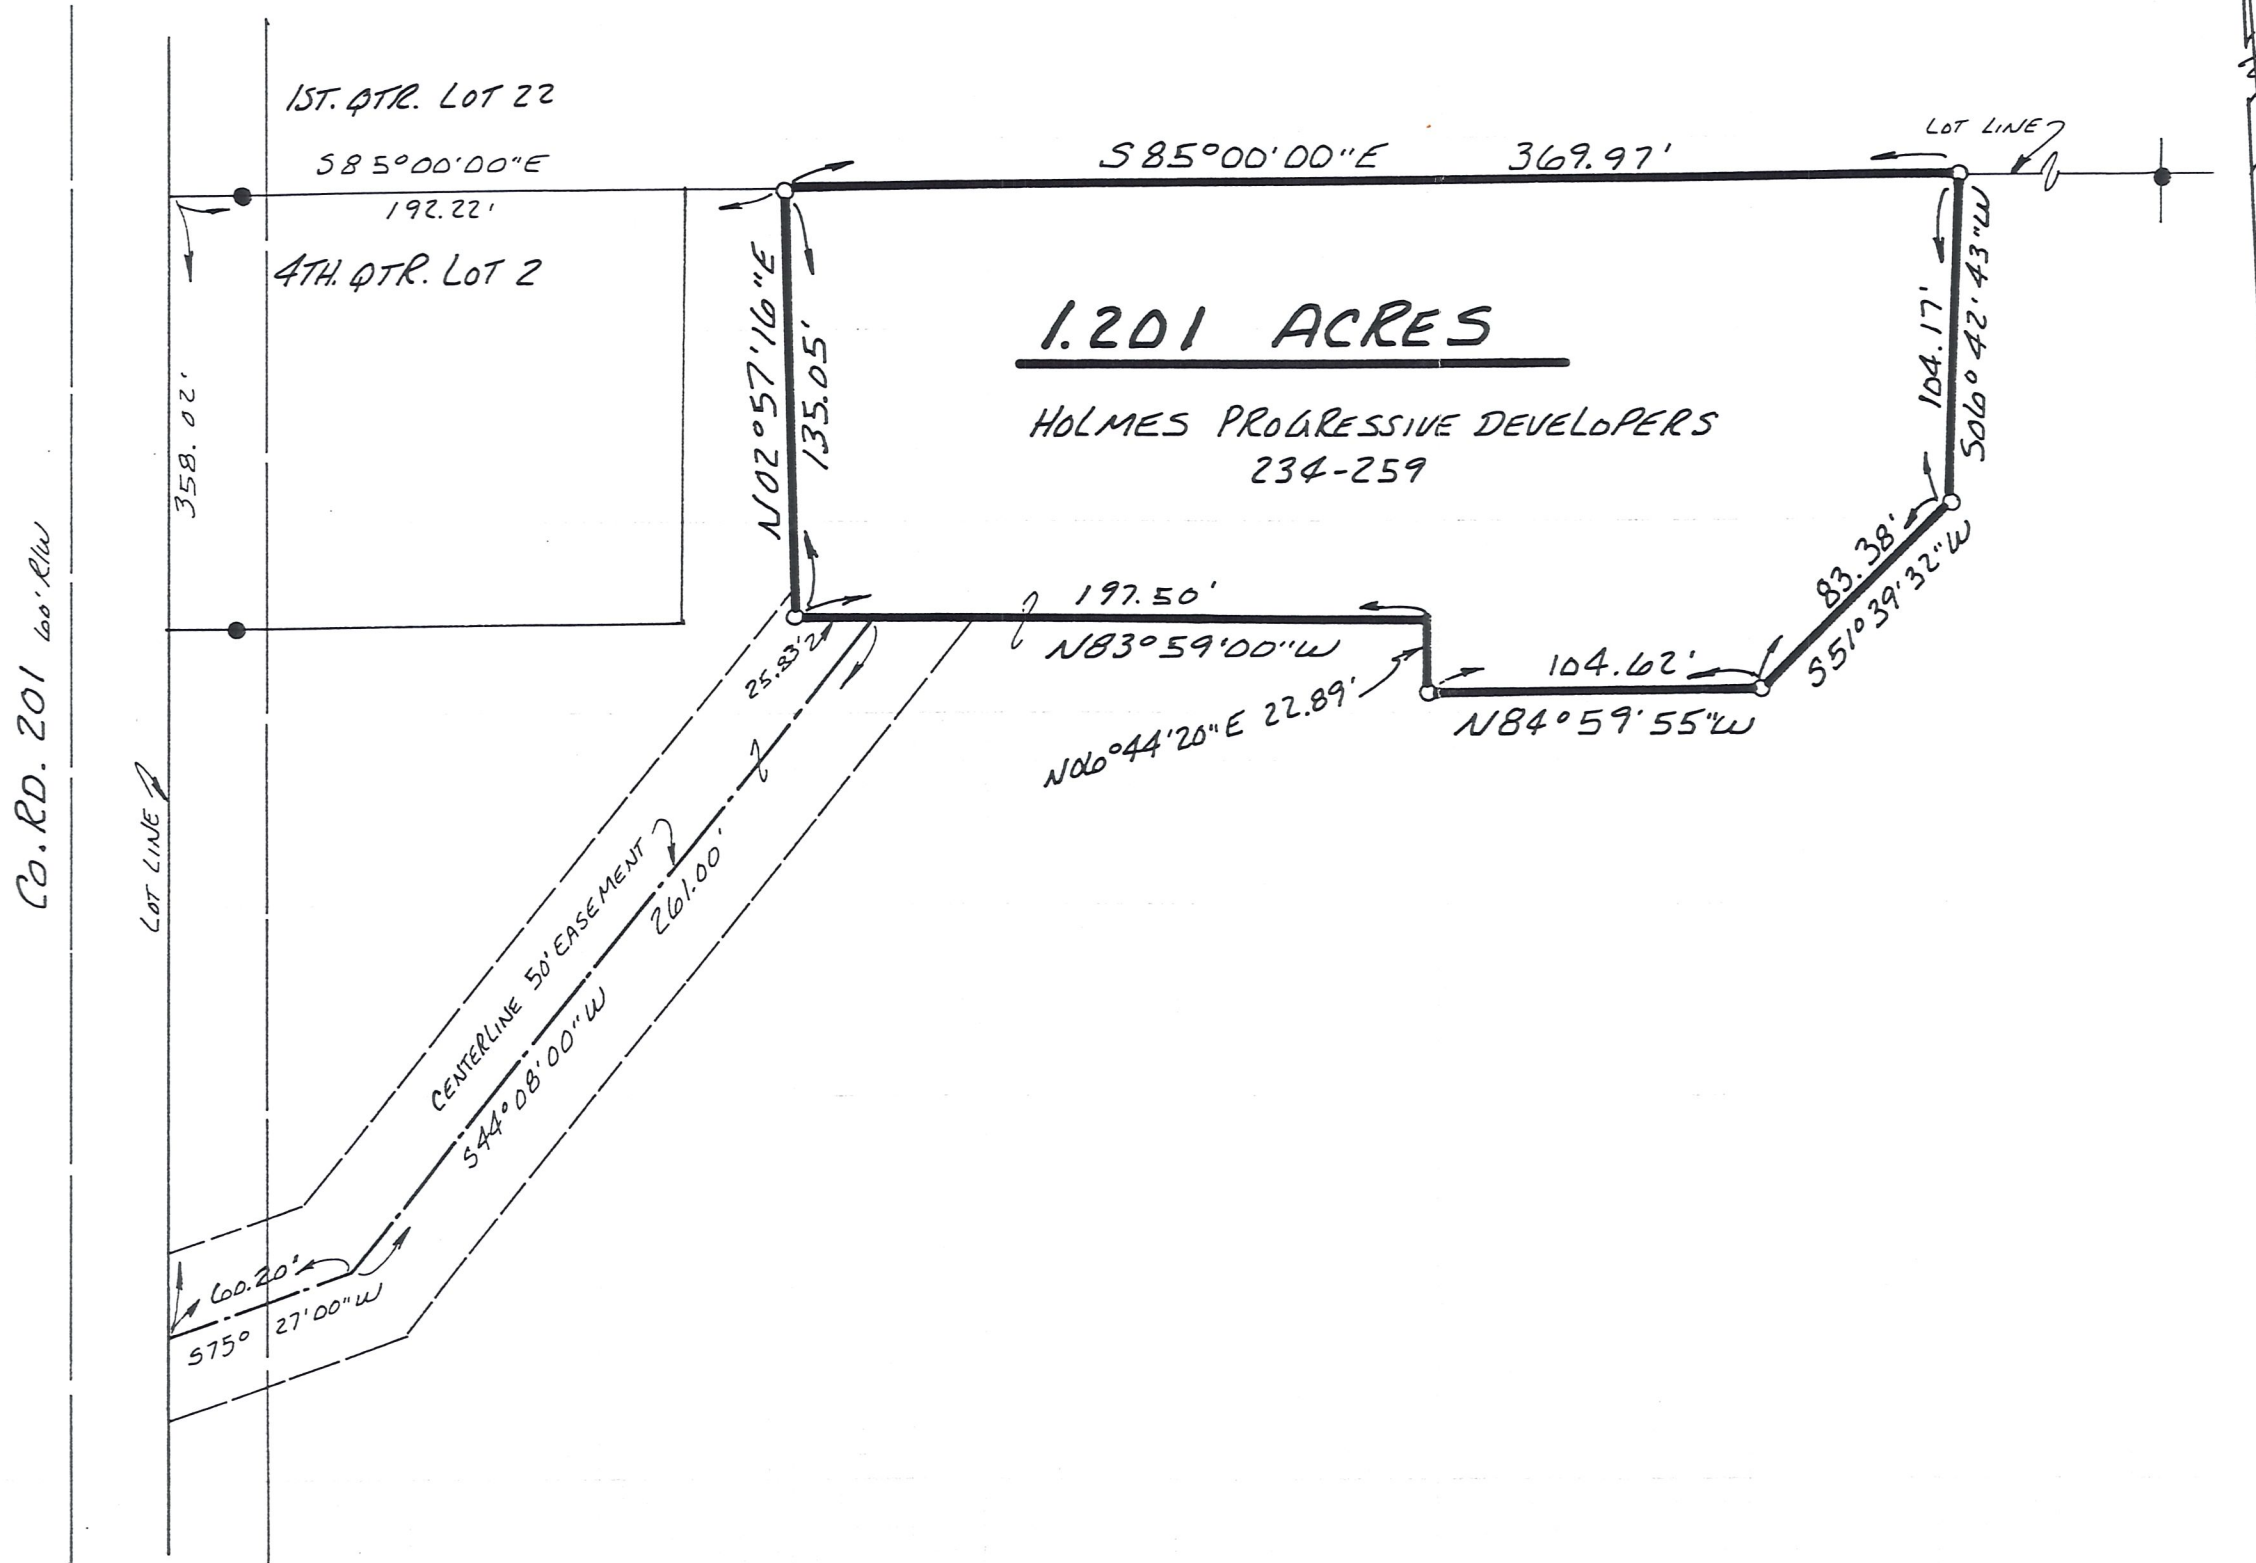

I CERTIFY THIS SURVEY TO BE  
 CORRECT TO THE BEST OF MY  
 KNOWLEDGE.

*Donald C. Baker*  
 DONALD C. BAKER P.S. 6938  
 5958 T.R. 322  
 MILLERSBURG, OHIO 44654  
 PH. (216) 674-4788

NOVEMBER 19, 1993