


BERLIN TOWNSHIP
 Central part LOT #3 4 Qr.
 T 9N R 5
 HOLMES COUNTY, O.

made for
 Mr C J Yoder
 RD 4
 Millersburg, Ohio

A - Spike set in Pavement
 Iron Pipe set 40 ft W
 T/Pole SW 28.5 ft
 E/Pole SE 40 ft

B - Spike set in Pavement
 Iron Pipe set 30 ft W
 NE Cor Culv Abut. 12.6 ft
 SE # " " 17.3 ft

373

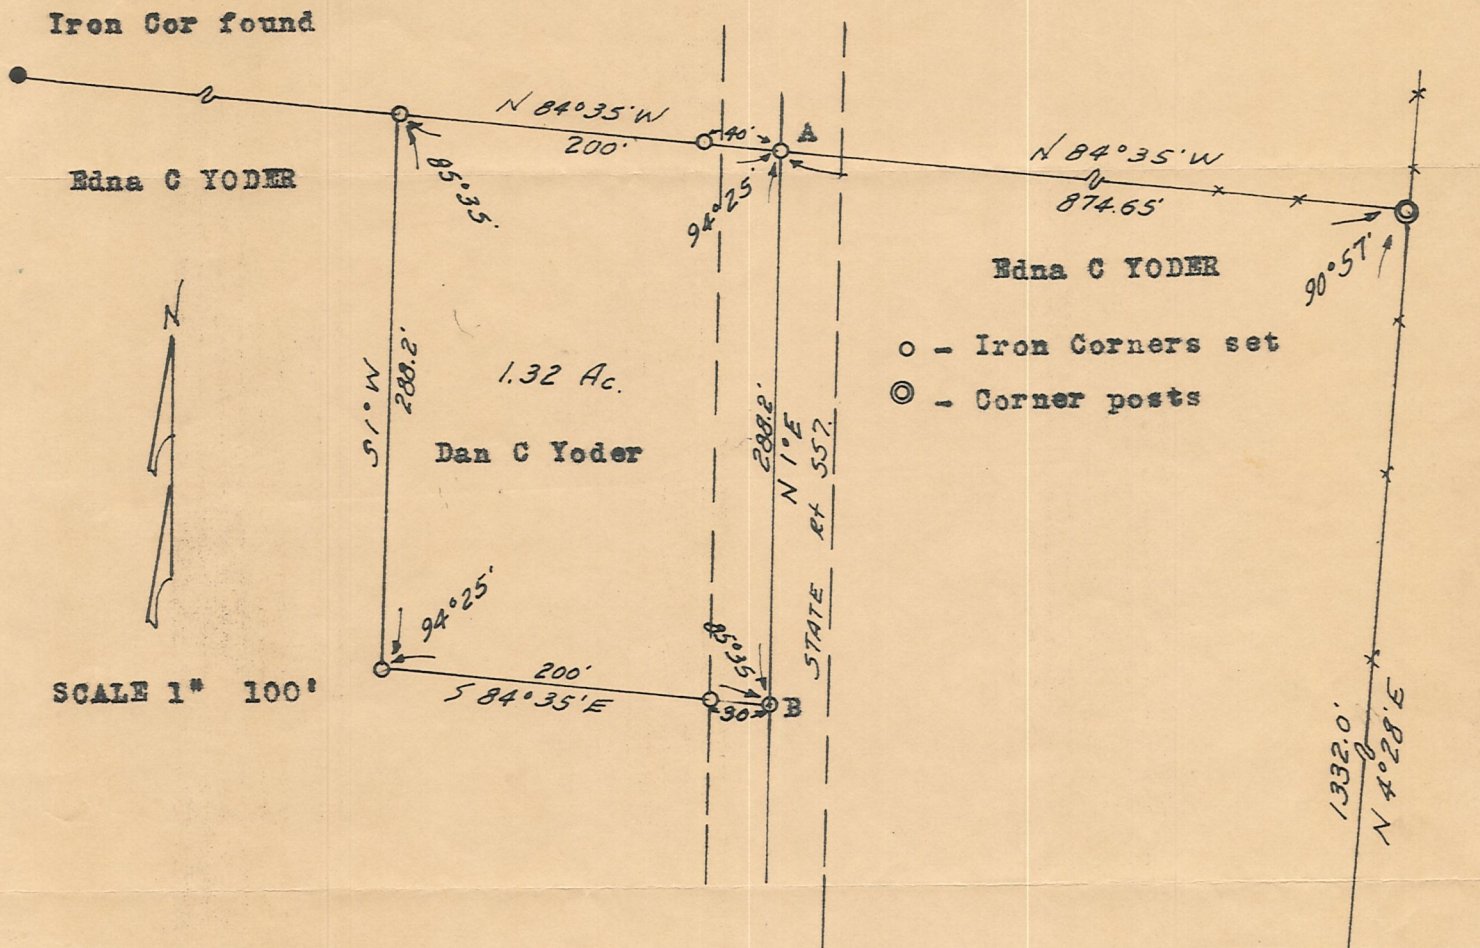

I certify this survey to be correct to the best of my knowledge.

Completed December 18th, 1957.

Ray W. Gasbarre
 Ray W Gasbarre RE #4153

