

BERLIN TOWNSHIP  
4TH. QTR., LOT 3  
T-9 N; R-6 W  
HOLMES COUNTY, OHIO

SURVEYED FOR: PHIL MILLER




- ▲ R.R. SPIKE FOUND
- 1/2" PIPE FOUND UNLESS OTHERWISE NOTED
- 5/8" REBAR SET WITH I.D. CAP
- I.D. CAP MARKED "BAKER 6938"

REFERENCES

- O.R. VOL. 55 PAGE 787
- O.R. VOL. 101 PAGE 3
- O.R. VOL. 200 PAGE 3179
- O.R. VOL. 201 PAGE 4
- O.R. VOL. 222 PAGE 2171
- O.R. VOL. 231 PAGE 3057
- O.R. VOL. 246 PAGE 2062
- O.R. VOL. 246 PAGE 6639
- O.R. VOL. 253 PAGE 3054
- O.R. VOL. 253 PAGE 3056
- PLAT VOL. 19 PAGE 1183
- PLAT VOL. 3 PAGE 34
- PLAT VOL. 5 PAGE 78
- PLAT VOL. 8 PAGE 690
- PLAT VOL. 17 PAGE 572
- PLAT VOL. 17 PAGE 695
- PLAT VOL. 19 PAGE 1183
- PLAT VOL. 19 PAGE 2776
- PLAT VOL. 19 PAGE 2734
- STATE HIGHWAY PLANS HOL-62-(21.09-21.38)
- BEARINGS FROM PLAT VOL. 19 PAGE 1183

- Ⓐ DANIEL A. GINGERICH  
CLARA A. GINGERICH  
O.R. 55-787
- Ⓑ DEM FAMILY, LLC  
O.R. 253-3056

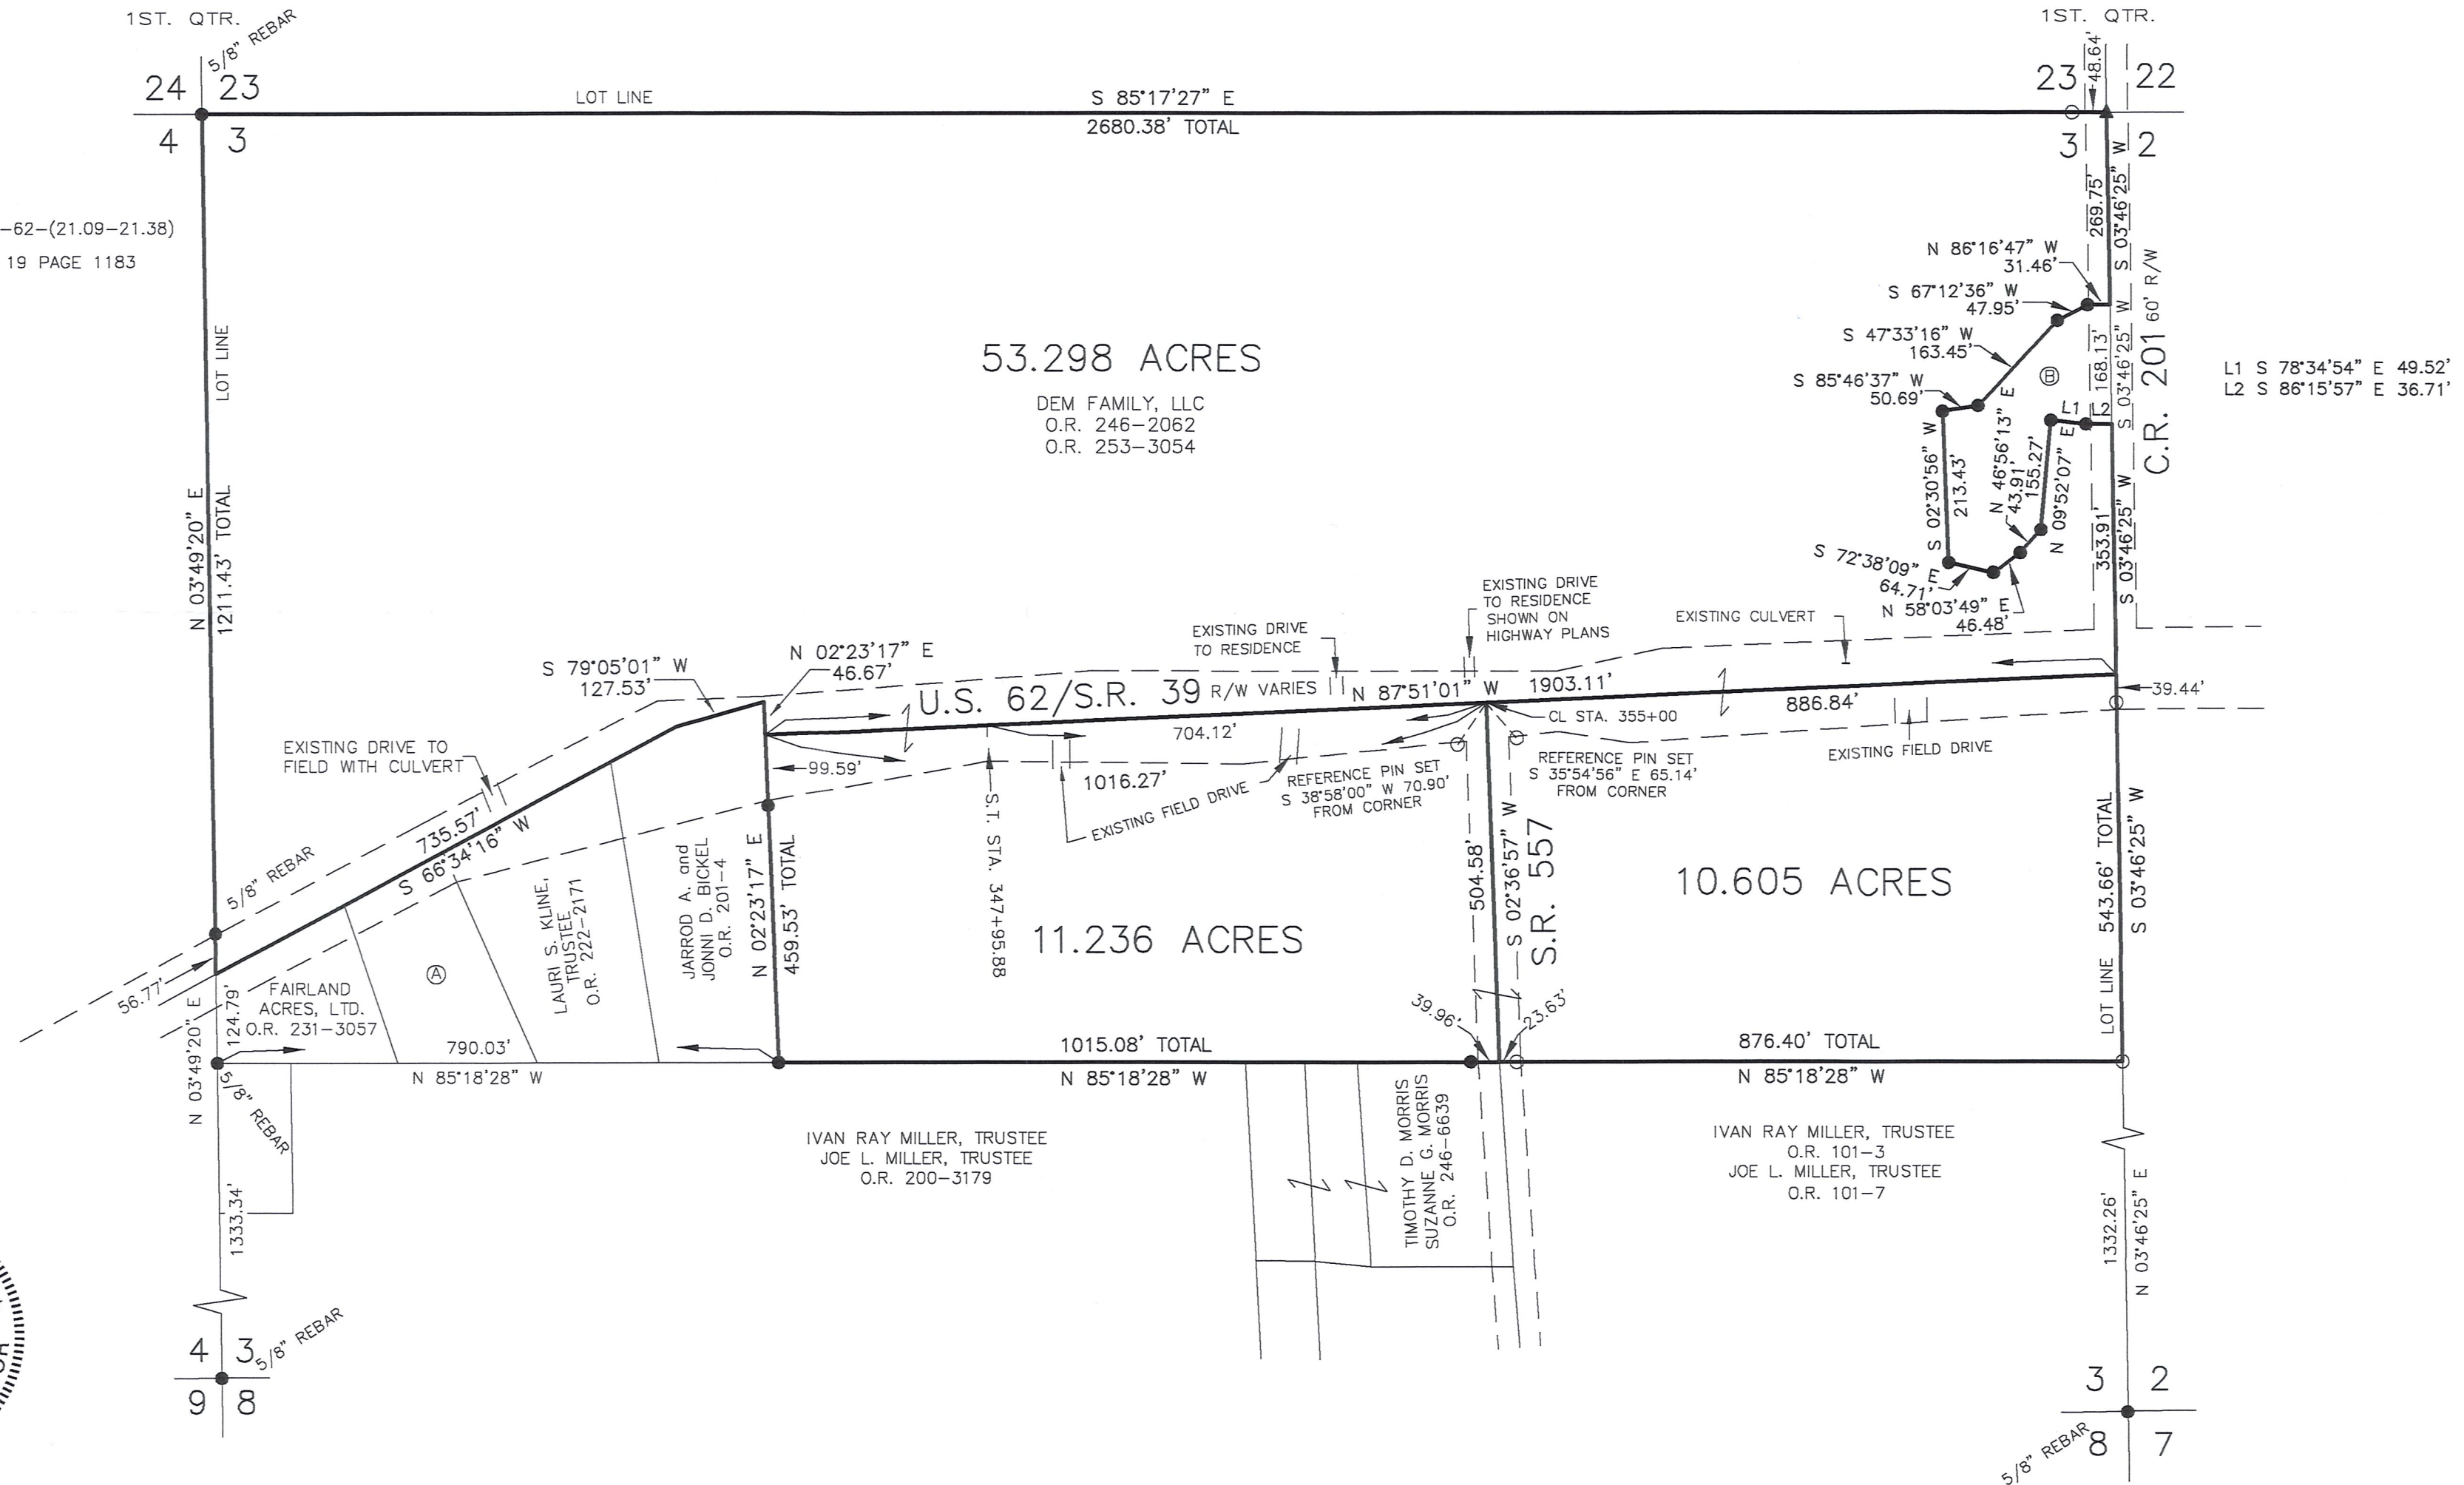

I CERTIFY THIS SURVEY TO BE CORRECT TO THE BEST OF MY KNOWLEDGE.

DONALD C. BAKER, P.S. 6938  
DATE: FEBRUARY 24, 2016  
CJG\FDB  
FILE NAME: WORK5\S-22-16\ALG

**PRELIMINARY FOR REVIEW ONLY**



BAKER SURVEYING, LLC  
138 N. CLAY STREET  
MILLERSBURG, OHIO 44654  
PH. 330-674-4788  
FAX 330-674-6027