


BERLIN TOWNSHIP
 4TH. QTR. LOT 4
 T-9N R-6W
 HOLMES COUNTY, OHIO

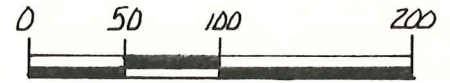


SCALE: 1" = 100'

- IRON PIN FOUND
- △ R.R. SPIKE SET
- 5/8" REBAR WITH I.D. CAP SET
- I.D. CAP MARKED "BAKER 6938"

REFERENCES:

DEED VOL. 226 PAGE 409
 BEARINGS FROM PLAT VOL. 7
 PAGE 794.

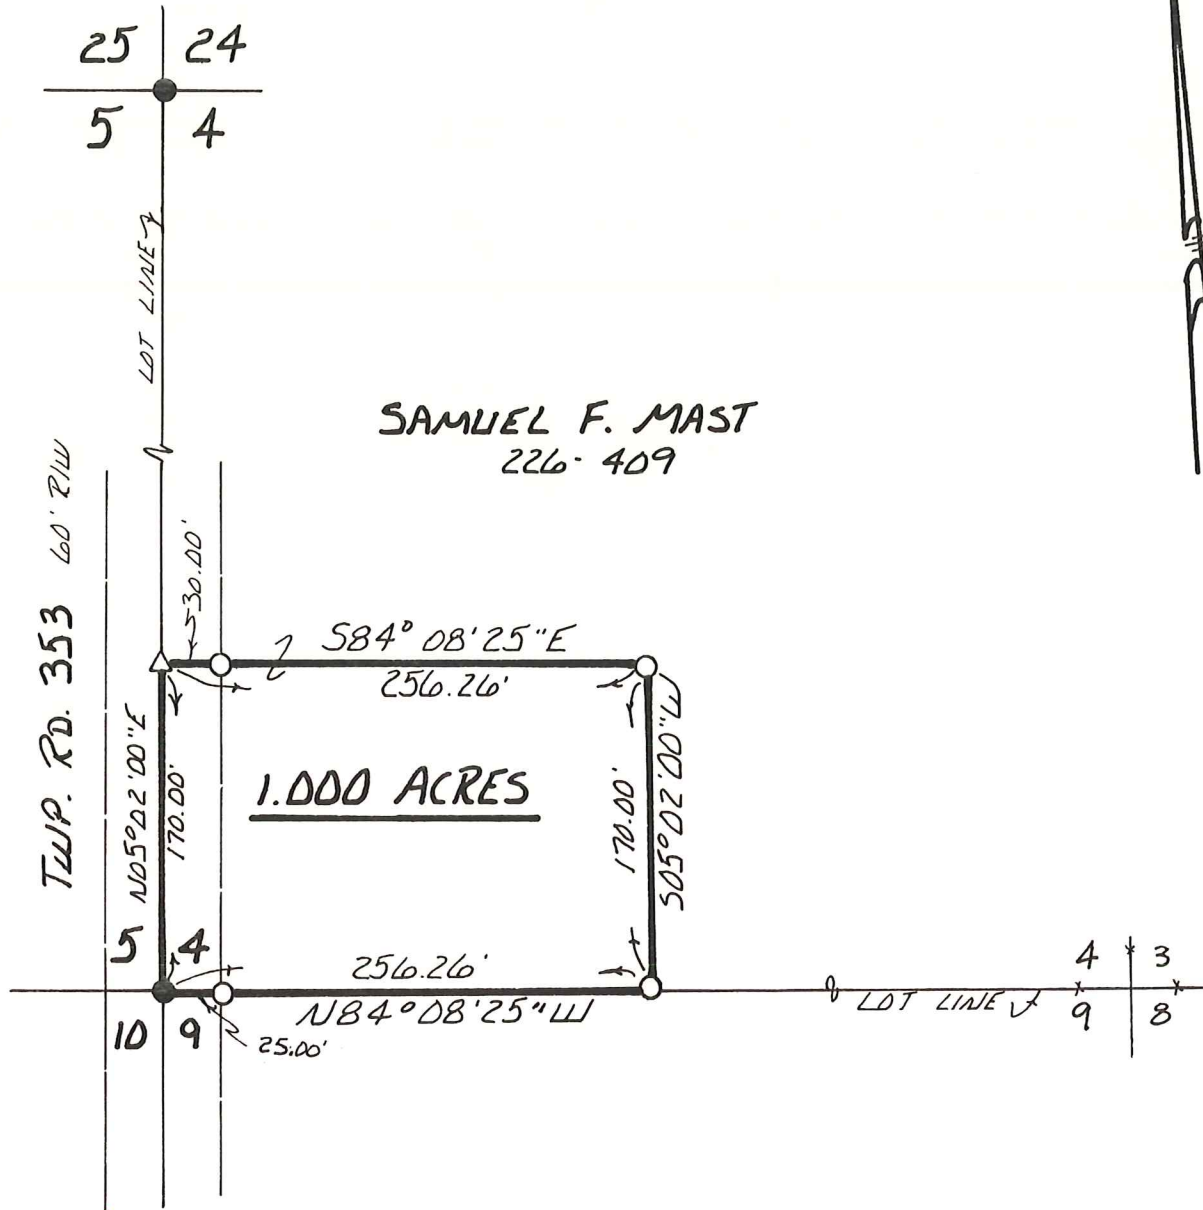

I CERTIFY THIS SURVEY TO BE CORRECT
 TO THE BEST OF MY KNOWLEDGE.

Donald C. Baker
 DONALD C. BAKER P.S. 6938
 4321 T.R. 252
 GLENMONT, OHIO

APRIL 16, 1990