

BERLIN TOWNSHIP  
 4TH-QTR. LOT 4  
 T-9N i R-6W  
 HOLMES COUNTY, OHIO

S.R.39  $\frac{1}{2}$  U.S.62




- HIGHWAY MARKER FOUND
- IRON PIN FOUND
- 5/8" REBAR WITH I.D. CAP SET
- I.D. CAP MARKED "BAKER 6938"

REFERENCES:

DEED VOL. 194-391  
 DEED VOL. 247-837  
 DEED VOL. 225-PAGE 215

BEARINGS FROM PLAT VOL. 7 PAGE 794

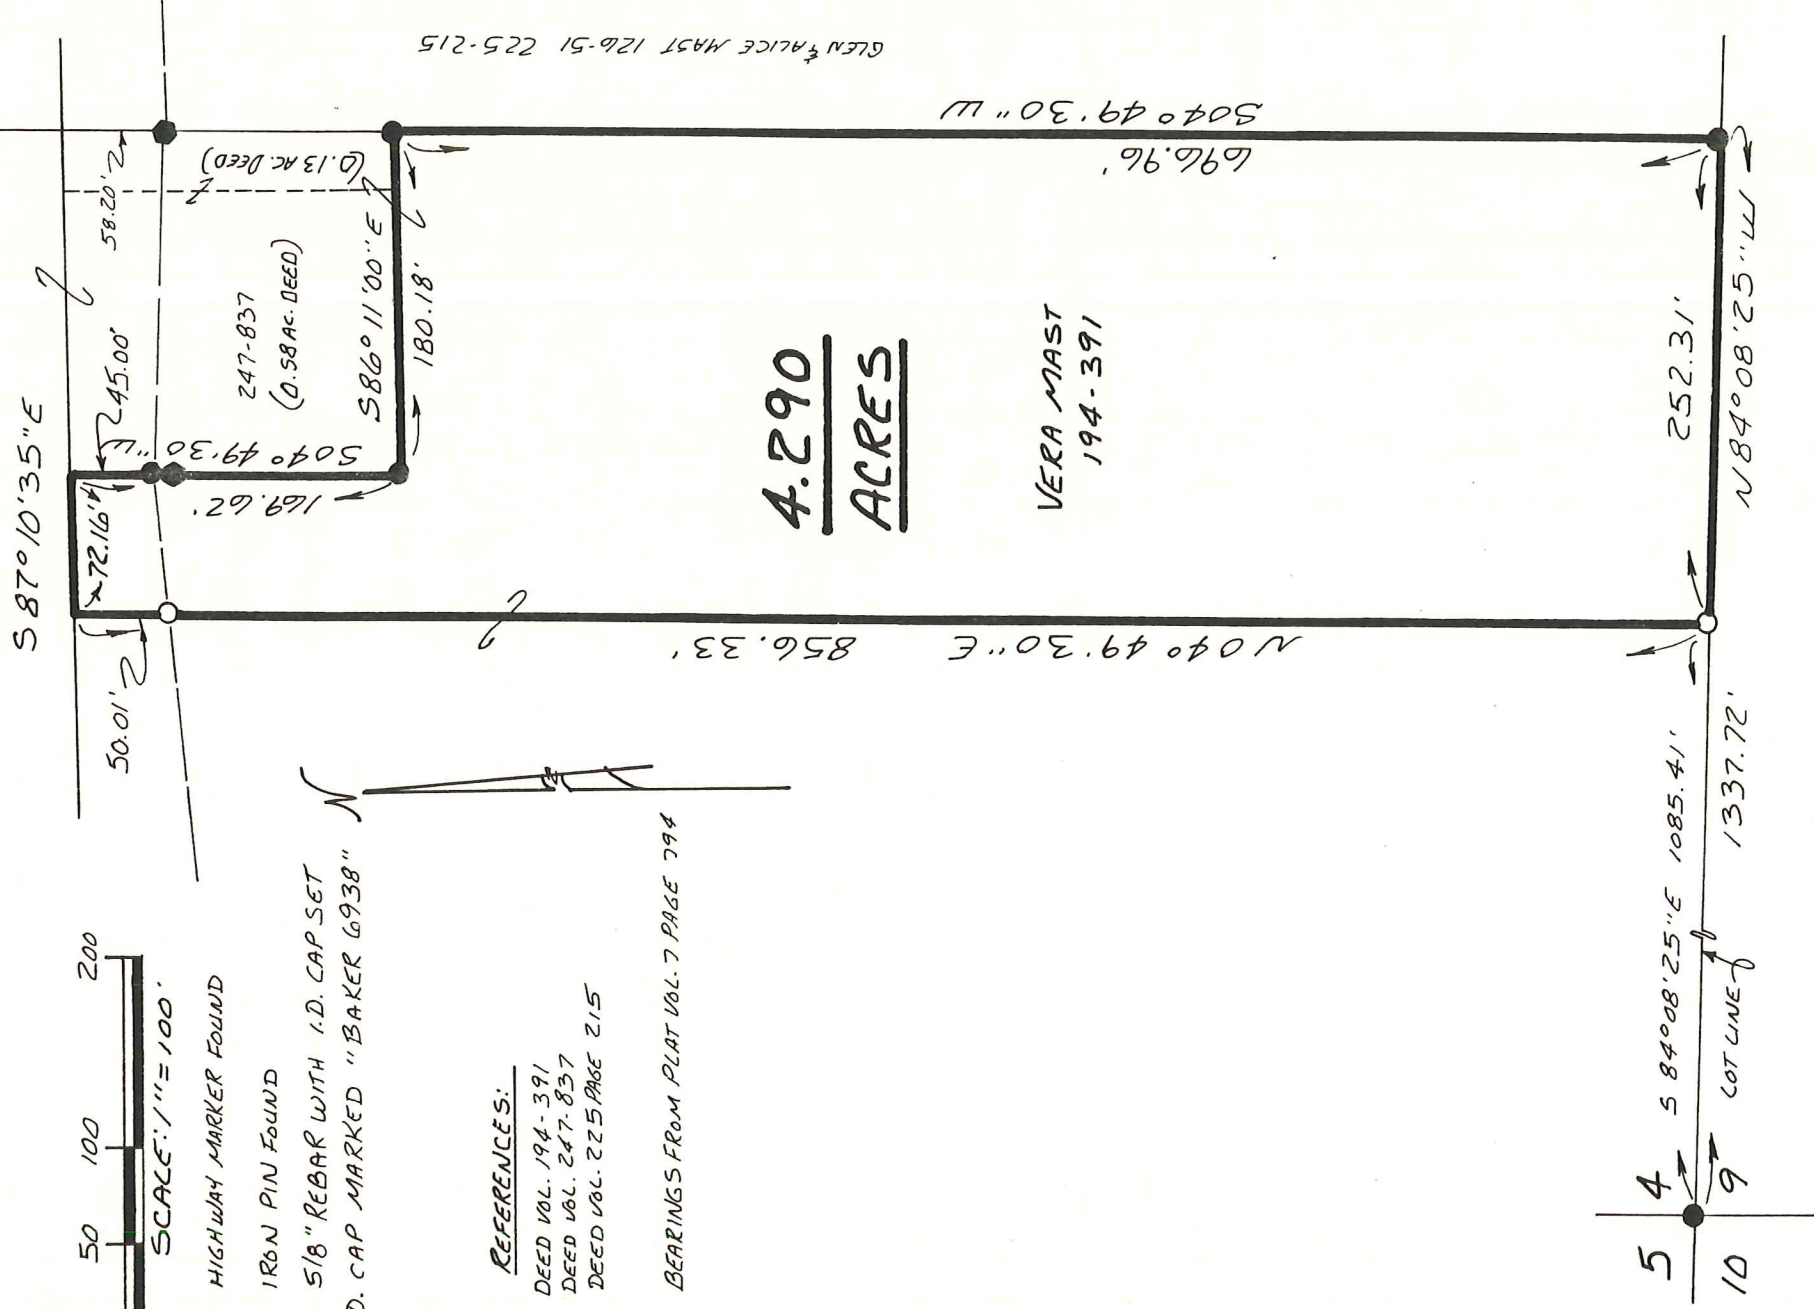

4.290  
ACRES

VERA MAST  
 194-391

I CERTIFY THIS SURVEY TO BE CORRECT  
 TO THE BEST OF MY KNOWLEDGE.

Donald C. Baker  
 DONALD C. BAKER P.S. 6938  
 4321 T.R. 252  
 GLENMONT, OHIO 44028



APRIL 23, 1991