

# PROPERTY LINE SURVEY

BERLIN TOWNSHIP  
 4TH. QTR. LOT 4  
 T- 9N; R- 6W  
 HOLMES COUNTY, OHIO





SCALE: 1" = 200'

- ▲ R.R. SPIKE FOUND
- IRON PIN FOUND
- 5/8" RE BAR WITH I.D. CAP SET  
 (I.D. CAP MARKED "BAKER 6938")

REFERENCES:

- DEED VOL. 225 PAGE 215
- " " 126 " 51
- " " 266 " 719
- " " 220 " 955

BEARINGS FROM DEED VOL. 263 PAGE 891

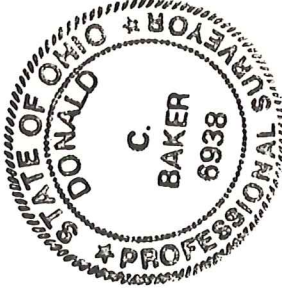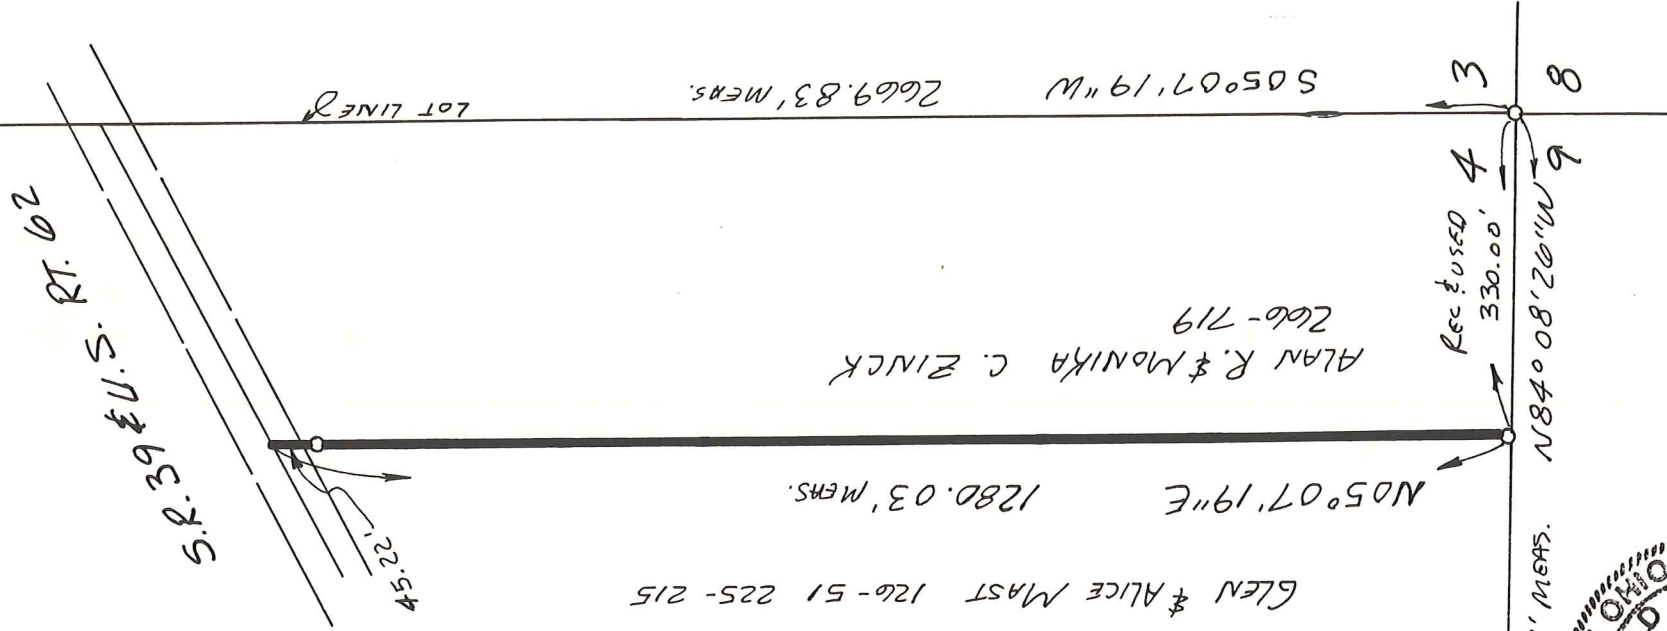

I CERTIFY THIS SURVEY TO BE CORRECT  
 TO THE BEST OF MY KNOWLEDGE.

*Donald C. Baker*

DONALD C. BAKER P.S. 6938

5958 T.R. 322

MILLERSBURG, OHIO 44654

PH. (216) 674-4788

JULY 7, 1995

33295-MLS