



BERLIN TOWNSHIP
 4TH. QTR., LOT 4
 T- 9 N R- 6 W
 HOLMES COUNTY, OHIO

REFERENCES:
 DEED VOL. 253 PAGES 231 & 233
 DEED VOL. 271 PAGE 256
 DEED VOL. 279 PAGE 632
 DEED VOL. 266 PAGE 719
 DEED VOL. 280 PAGE 484
 O.R. VOL. 44 PAGE 170 & 177
 PLAT VOL. 14 PAGE 612

RESURVEY OR 44-170
 OR 44-177

BEARINGS FROM PLAT VOL. 14 PAGE 612

● IRON PIN FOUND
 ○ 5/8" REBAR WITH I.D. CAP SET,
 I.D. CAP MARKED "BAKER 6938"

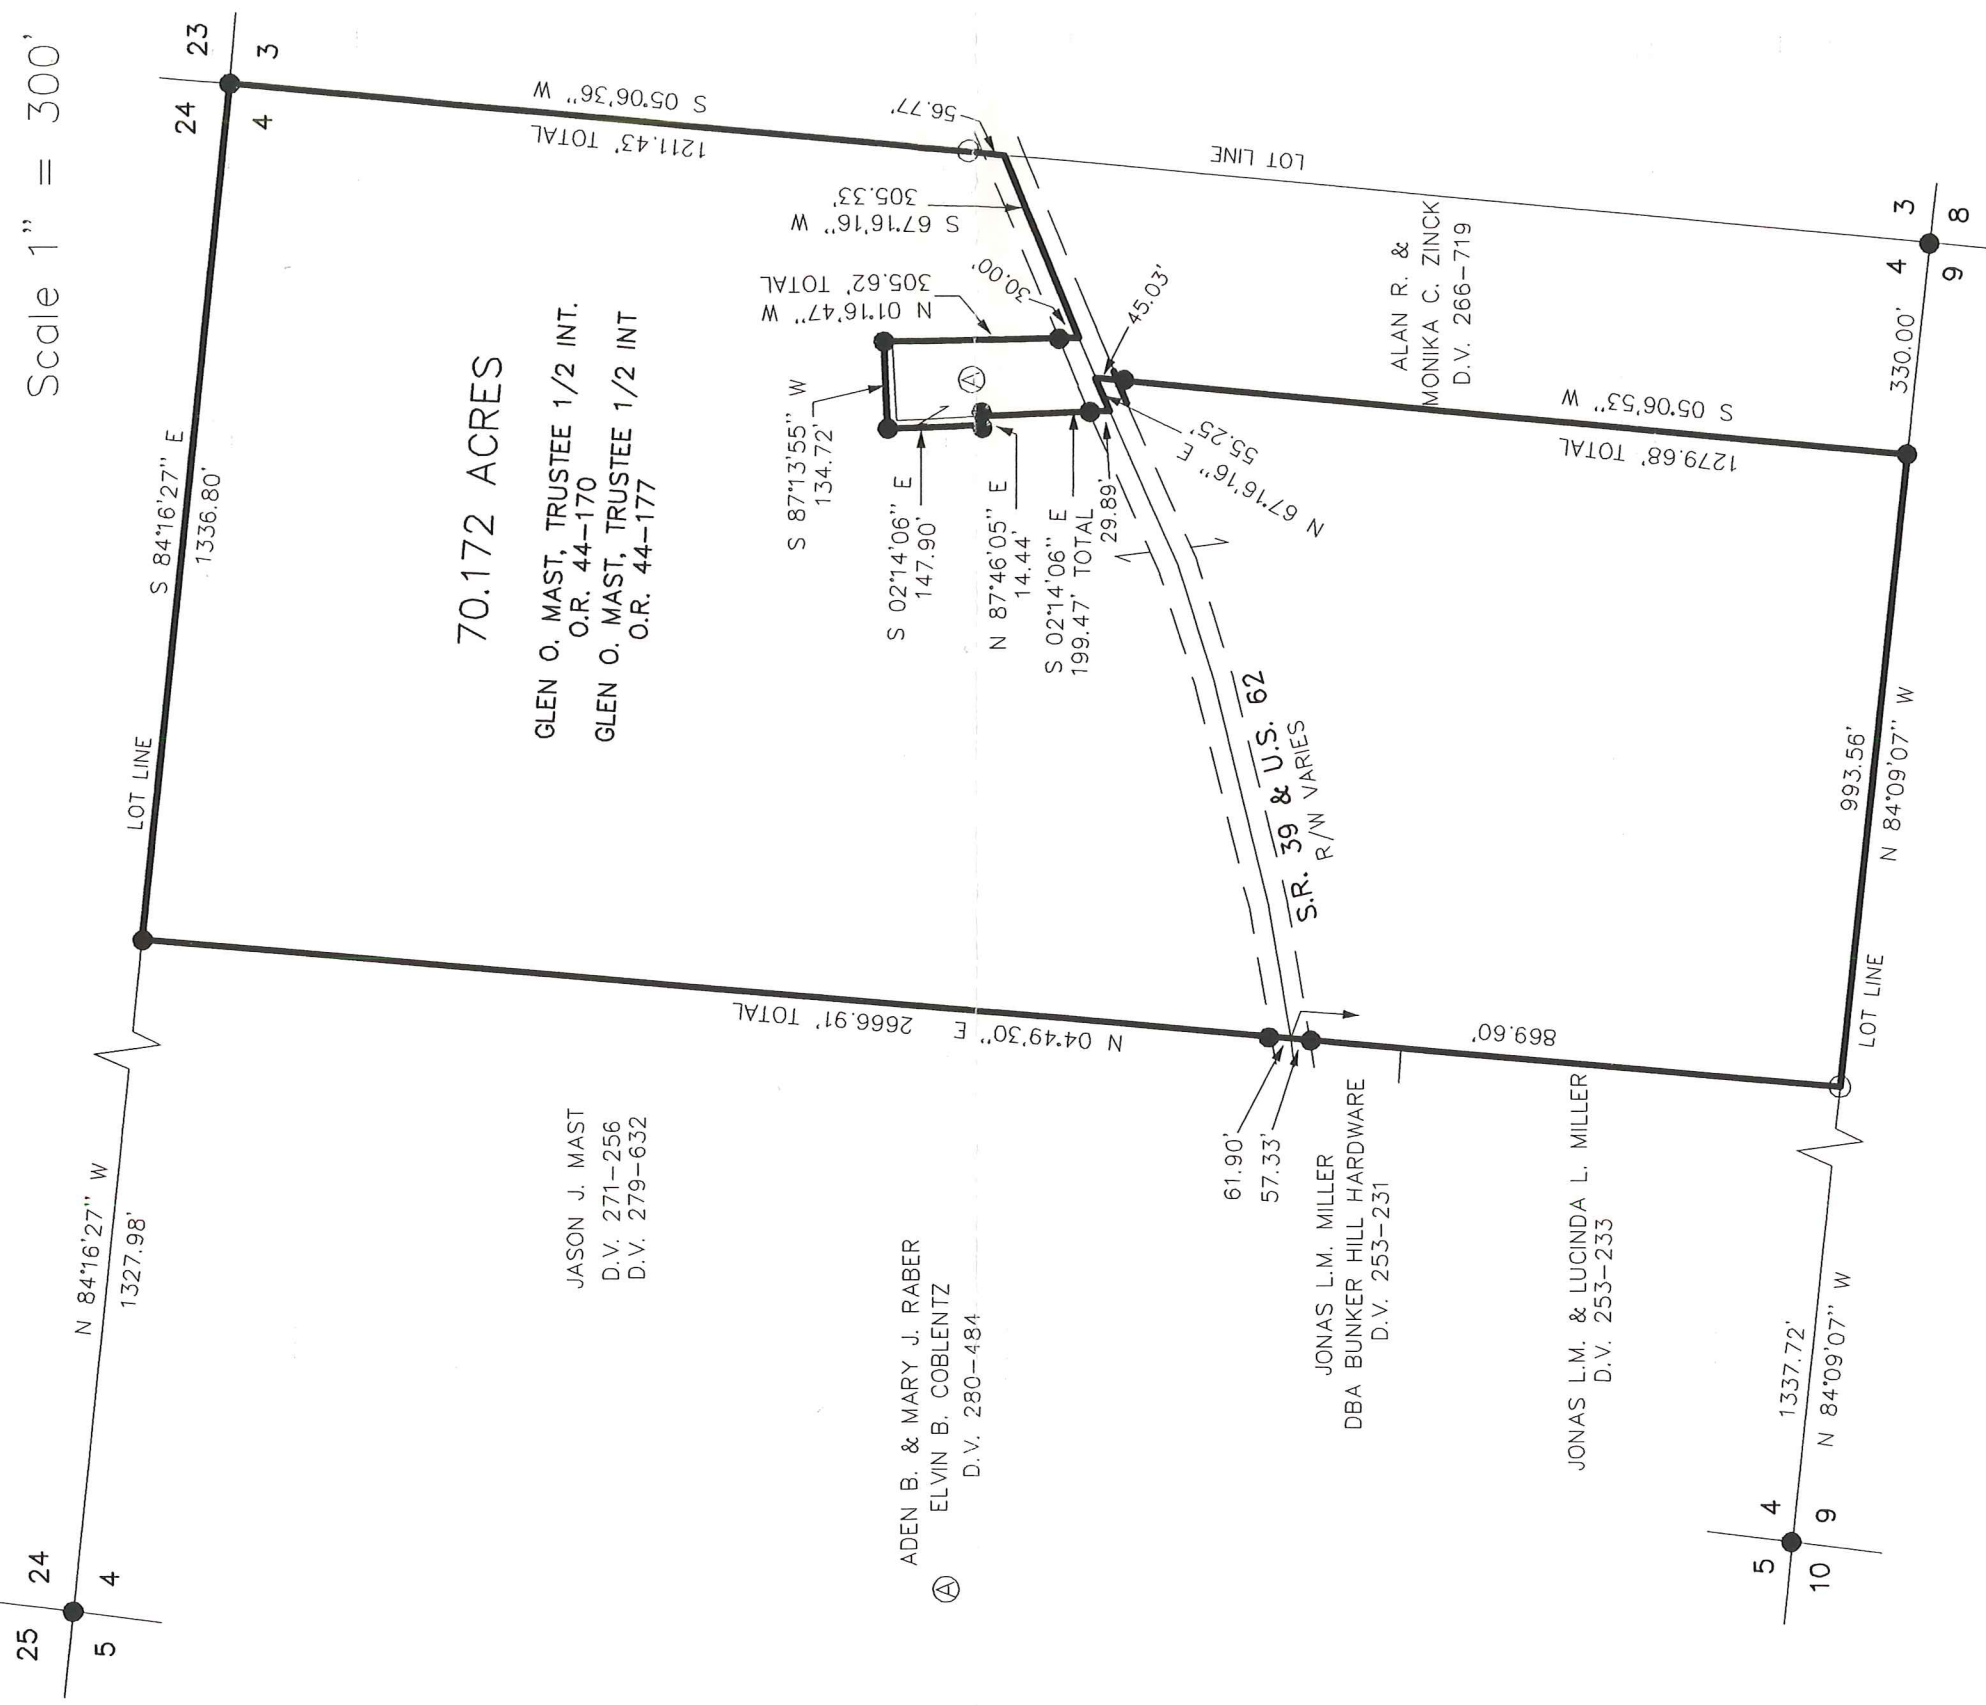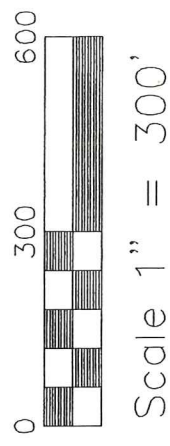

DONALD C. BAKER SURVEYING
 138 N. CLAY ST.
 MILLERSBURG, OHIO 44654
 PH. 330-674-4788
 FAX 330-674-6027

I CERTIFY THIS SURVEY TO BE CORRECT
 TO THE BEST OF MY KNOWLEDGE.

Donald C. Baker
 DONALD C. BAKER P.S. 6938

FDB/ FCC DATE: AUG. 31, 2001
 File name: C:\JOBS1\S-604-01\ERZ