

0 200 400



SCALE: 1"=200'

- ▲ R.R. SPIKE FOUND
- 1/2" I.D. PIPE FOUND
- 5/8" REBAR SET WITH I.D. CAP I.D. CAP MARKED "BAKER 6938"


REFERENCES

DEED VOL. 241 PAGE 468
 PLAT VOL. 4 PAGE 116
 PLAT VOL. 8 PAGE 106
 BEARINGS FROM PLAT VOL. 17 PAGE 68



BERLIN TOWNSHIP
 4TH. QTR., LOT 6
 T-9 N; R-6 W
 HOLMES COUNTY, OHIO

SURVEYED FOR: DANIEL MILLER

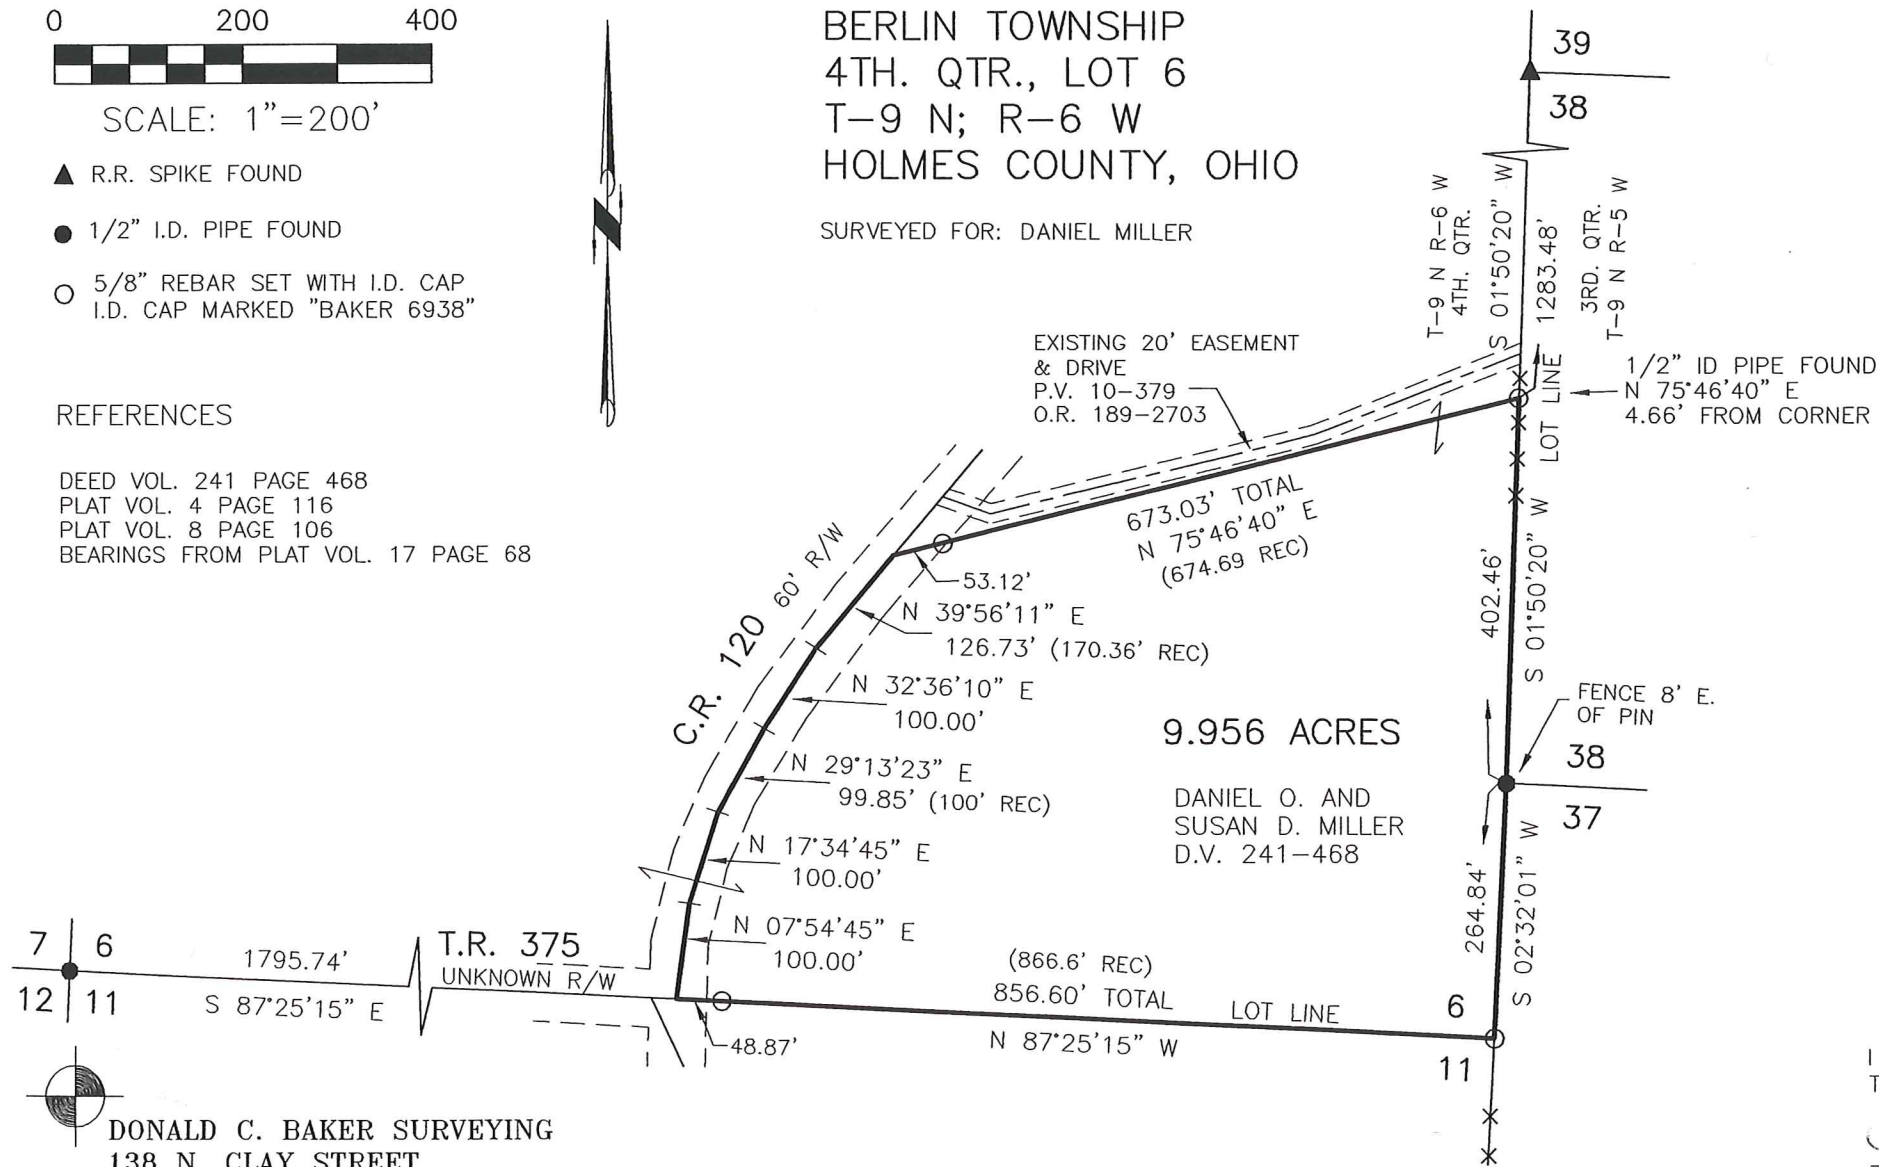

I CERTIFY THIS SURVEY TO BE CORRECT
 TO THE BEST OF MY KNOWLEDGE.

Jamie D. Darr
 JAMIE D. DARR P.S. 7755

DATE: NOV. 15, 2006

JDD\ERZ

FILE NAME: WORK3\S-806-06\ERZ

DONALD C. BAKER SURVEYING
 138 N. CLAY STREET
 MILLERSBURG, OHIO 44654
 PH. 330-674-4788
 FAX 330-674-6027