


BERLIN TOWNSHIP
 4TH. QTR. LOT 7 & 6
 T-9N:R-6W
 HOLMES COUNTY, OHIO

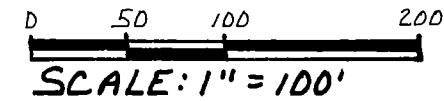


• IRDN PIN FOUND
 O 5/8" REBAR WITH I.D. CAP SET
 I.D. CAP MARKED "BAKER 6938"

SURVEYED FOR MOSE D. YODER

REFERENCES:

DEED VOL. 235 PAGE 400
 " " 232 " 661
 " " 160 " 110
 " " 222 " 810

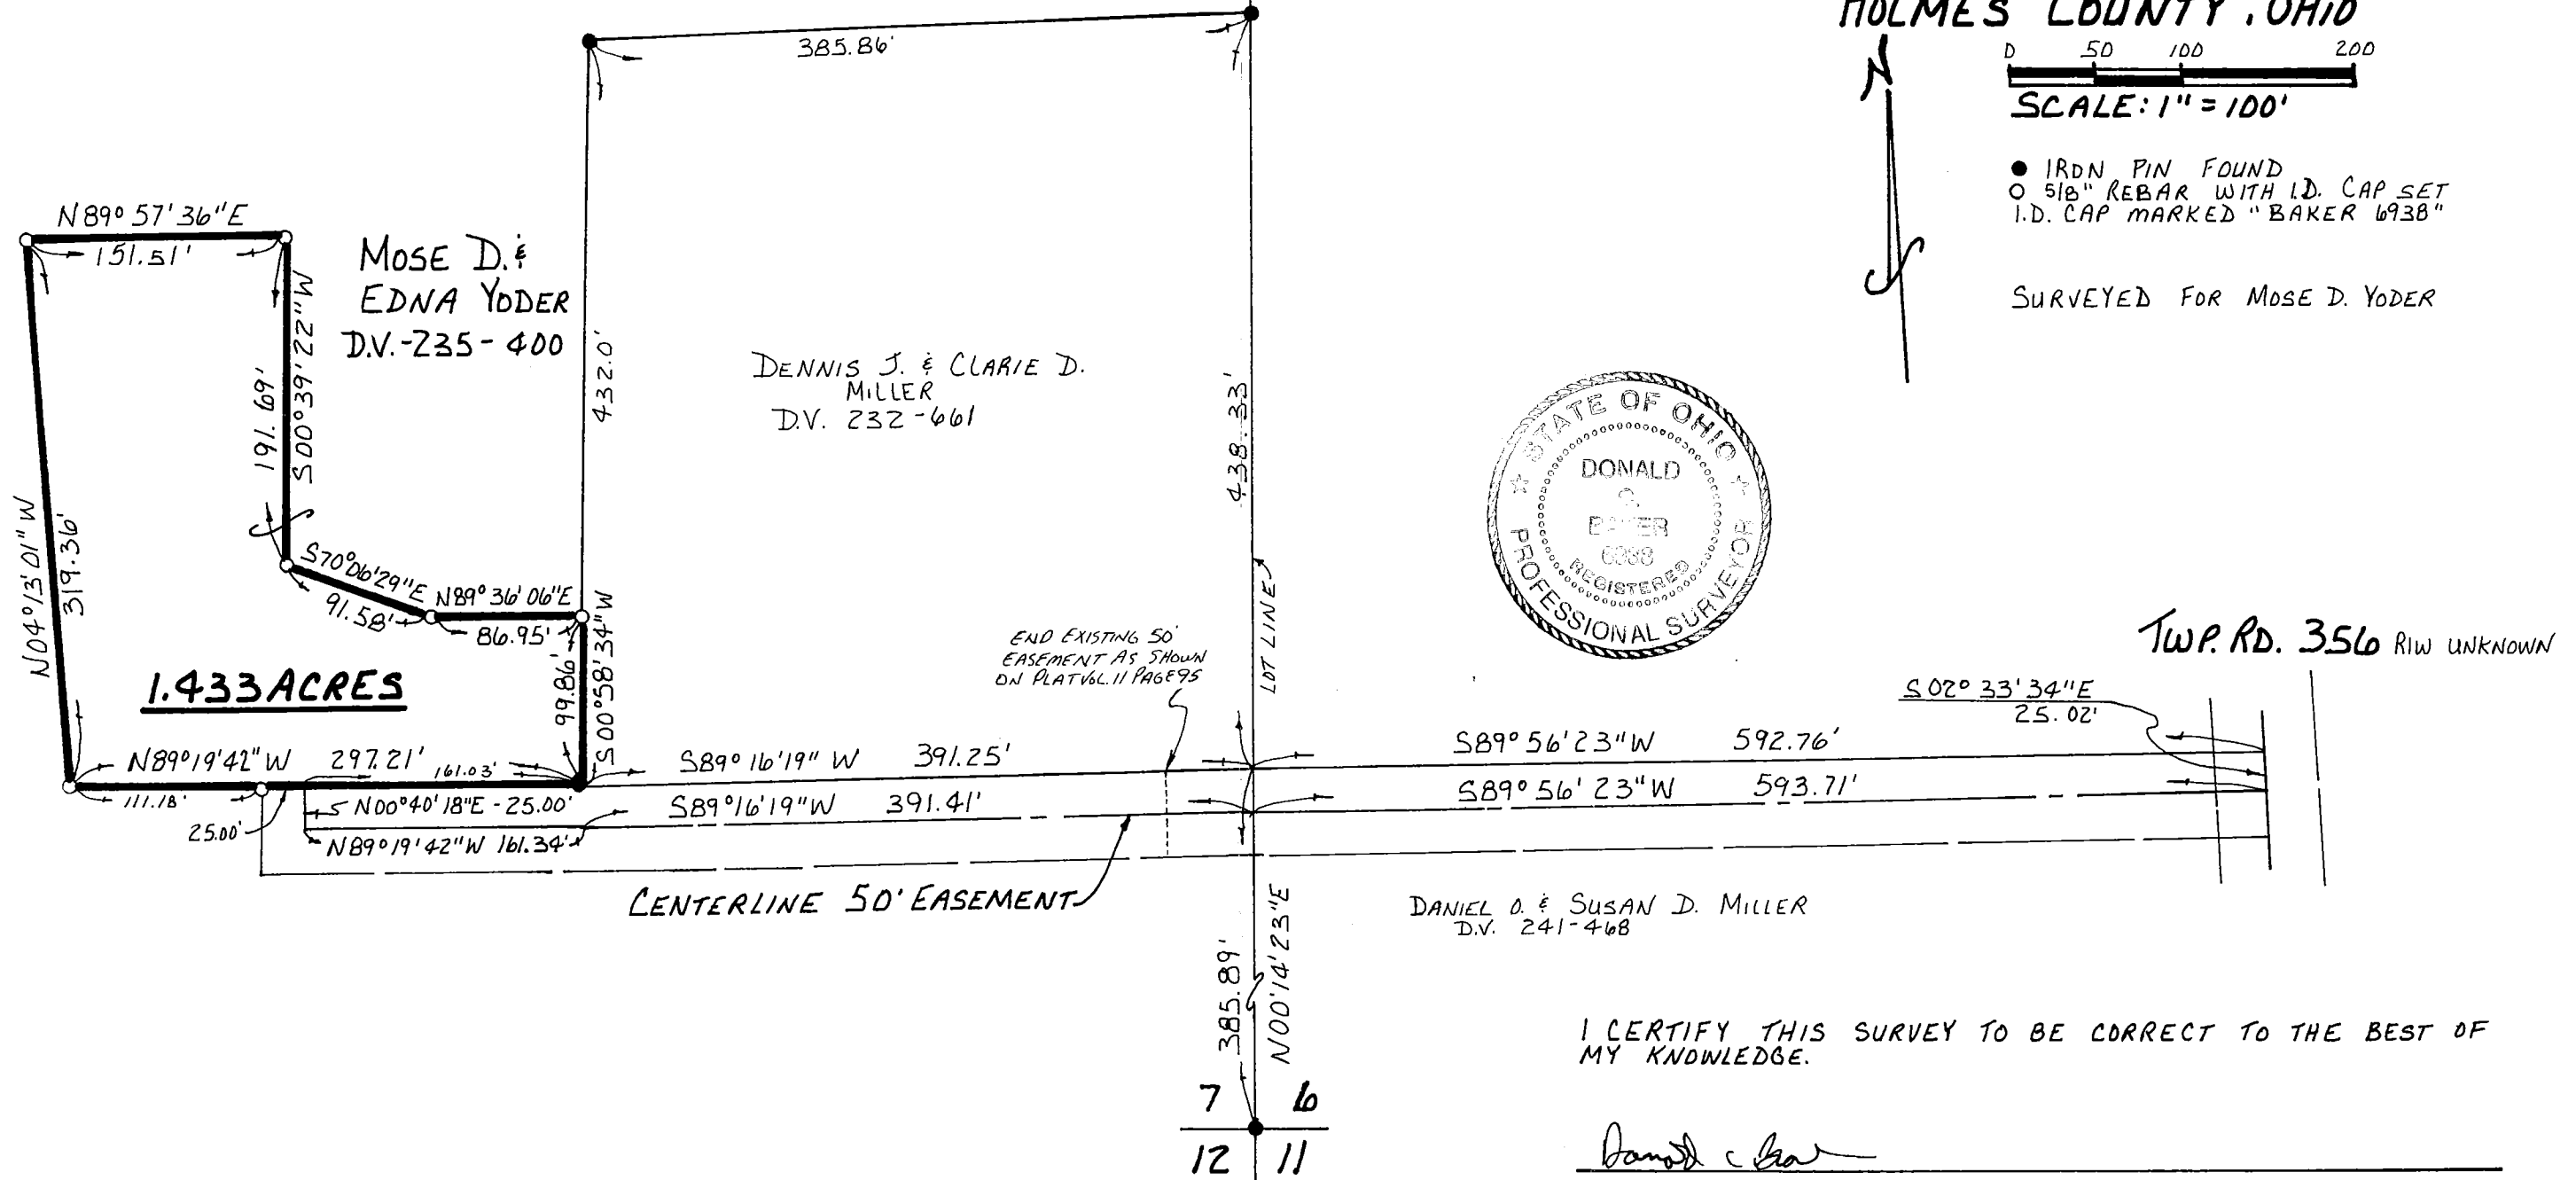

Donald C. Baker
 DONALD C. BAKER
 138 N. CLAY ST.
 MILLERSBURG, OHIO 44654
 PH: (330) 674-4788
 P.S. 6938
 # 15398 - FJM
 F.C.C. - D.C. BAKER