


BERLIN TOWNSHIP
 SW QTR. SECTION 13
 TWP. 9 RANGE 6
 HOLMES COUNTY, OHIO

made for MR. LEO MAST
 R.D. 3
 WOOSTER, OHIO

361

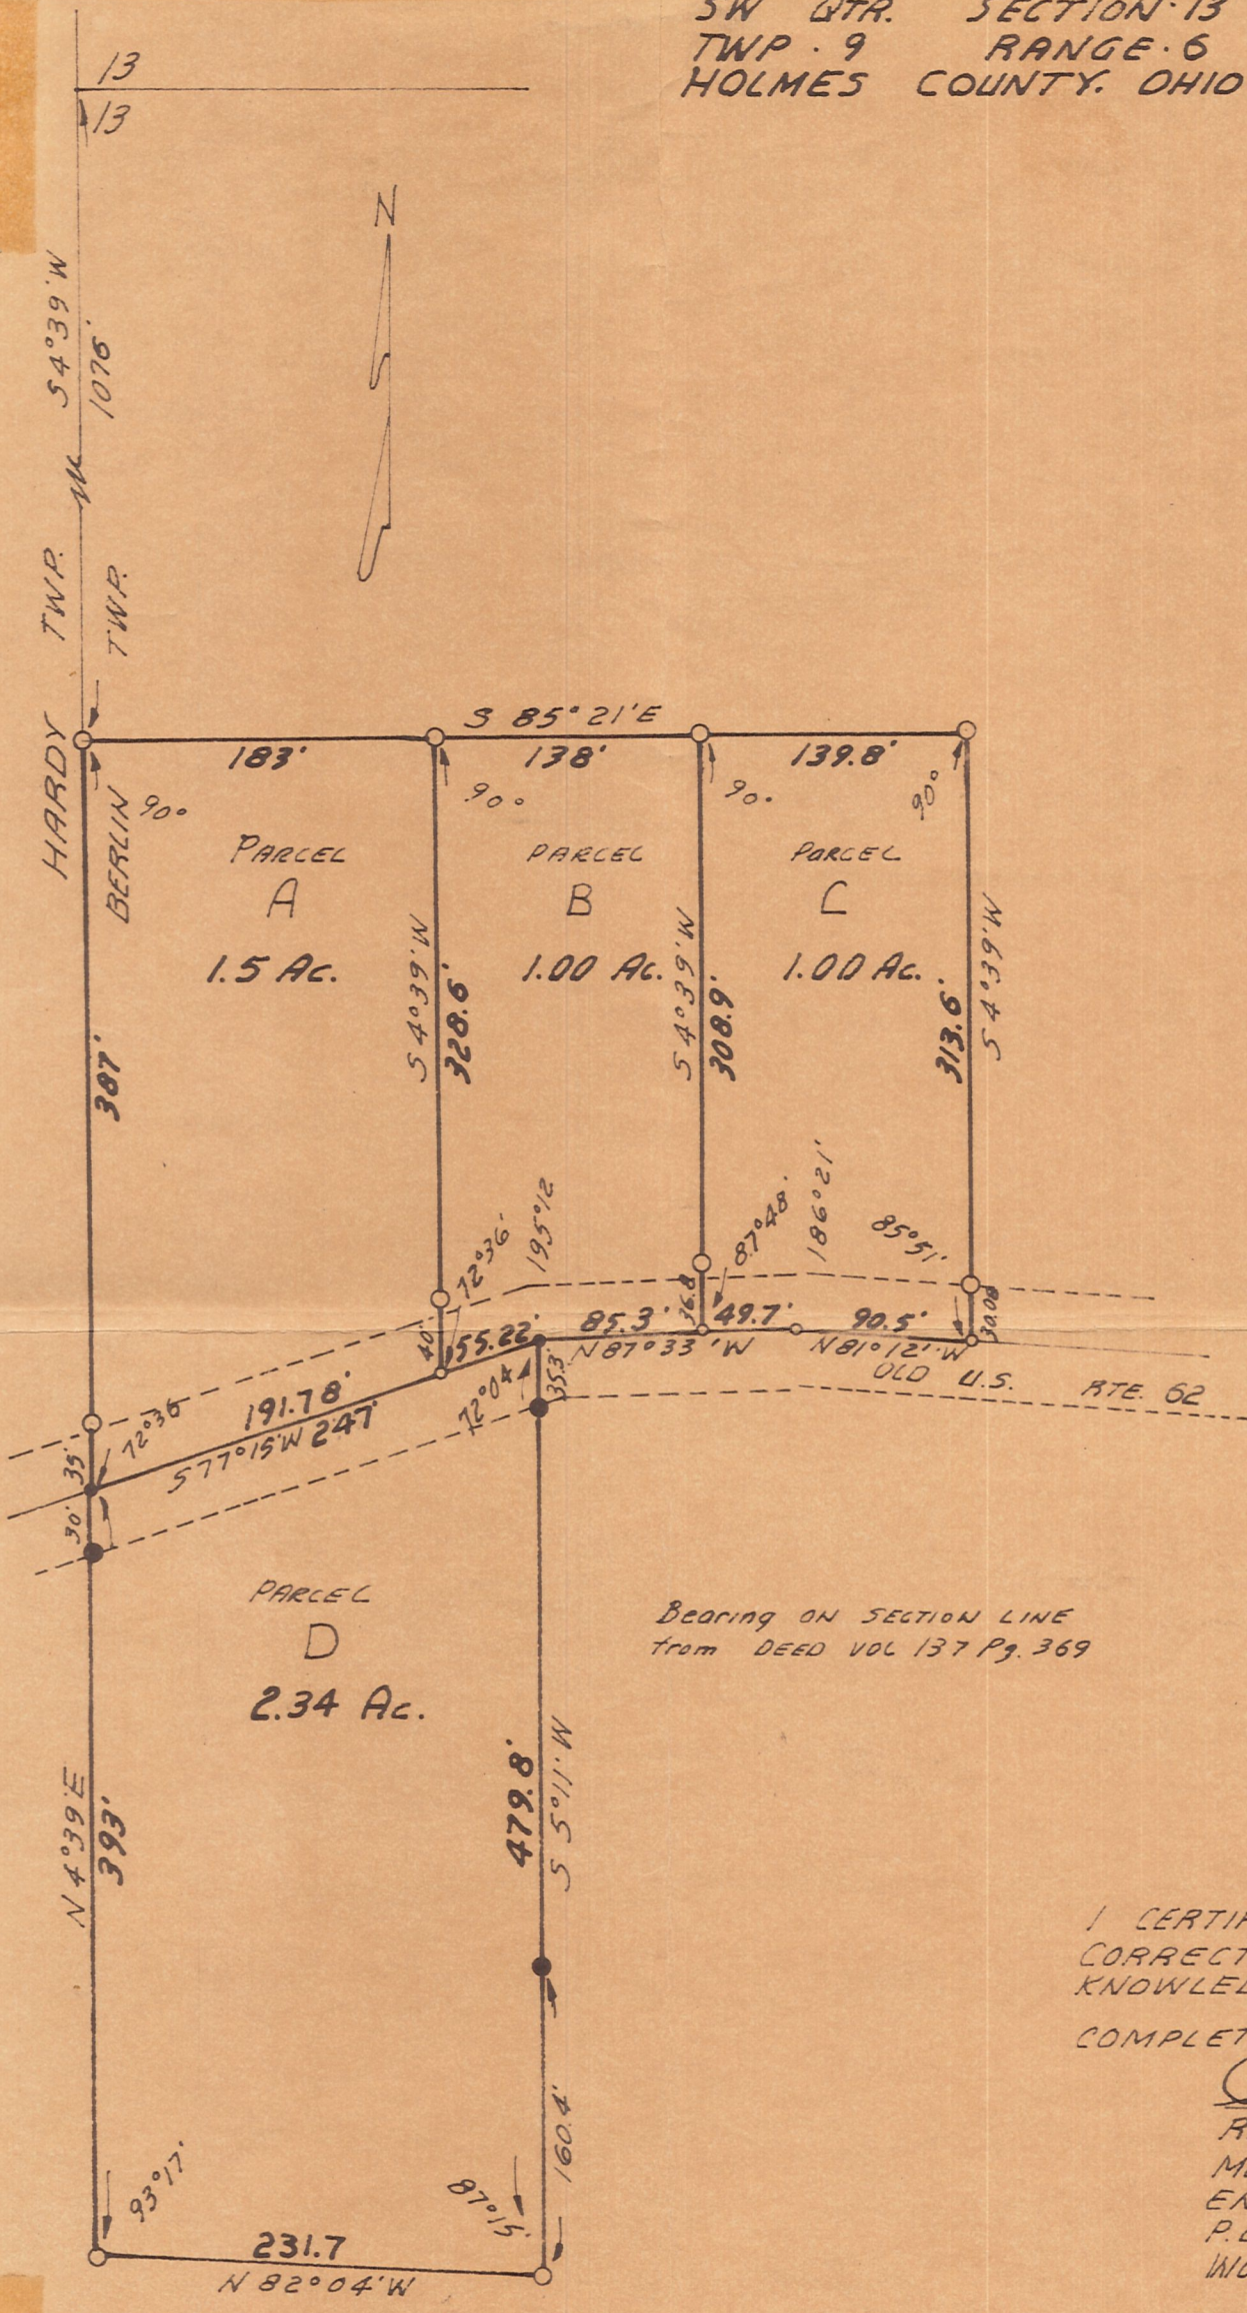

- - IRON CORNS FD
- - IRON CORNS SET
- - PK SPIKES SET IN PAVEMENT

SCALE 1" = 100'

I CERTIFY THIS SURVEY TO BE
 CORRECT TO THE BEST OF MY
 KNOWLEDGE.

COMPLETED 4-24-62

Ray W. Gasbarre
 RAY W. GASBARRE R.S. 4153
 MURPHY, MCDONALD & GASBARRE
 ENGINEERING ASSOC.
 P.O. BOX 157
 WOOSTER, OHIO