


REFERENCES:

DEED VOL. 223	PAGE 472
" " 204	" 613
" " 258	" 962
" " 276	" 717
" " 276	" 225
" " 252	" 500

OFFICIAL RECORD VOL. 26 PAGE 311




VILLAGE OF BALTIC

CLARK TOWNSHIP
S.W. QTR. SECTION 25
T-8N; R-4W
HOLMES COUNTY, OHIO
(SURVEYED FOR ELI MILLER)

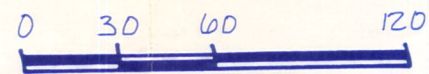

SCALE: 1" = 60'

- IRON PIN FOUND
- ▲ R.R. SPIKE FOUND
- 5/8" REBAR WITH I.D. CAP SET
- I.D. CAP MARKED "BAKER 6938"

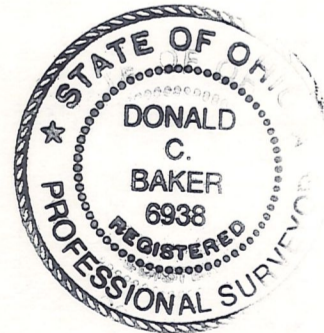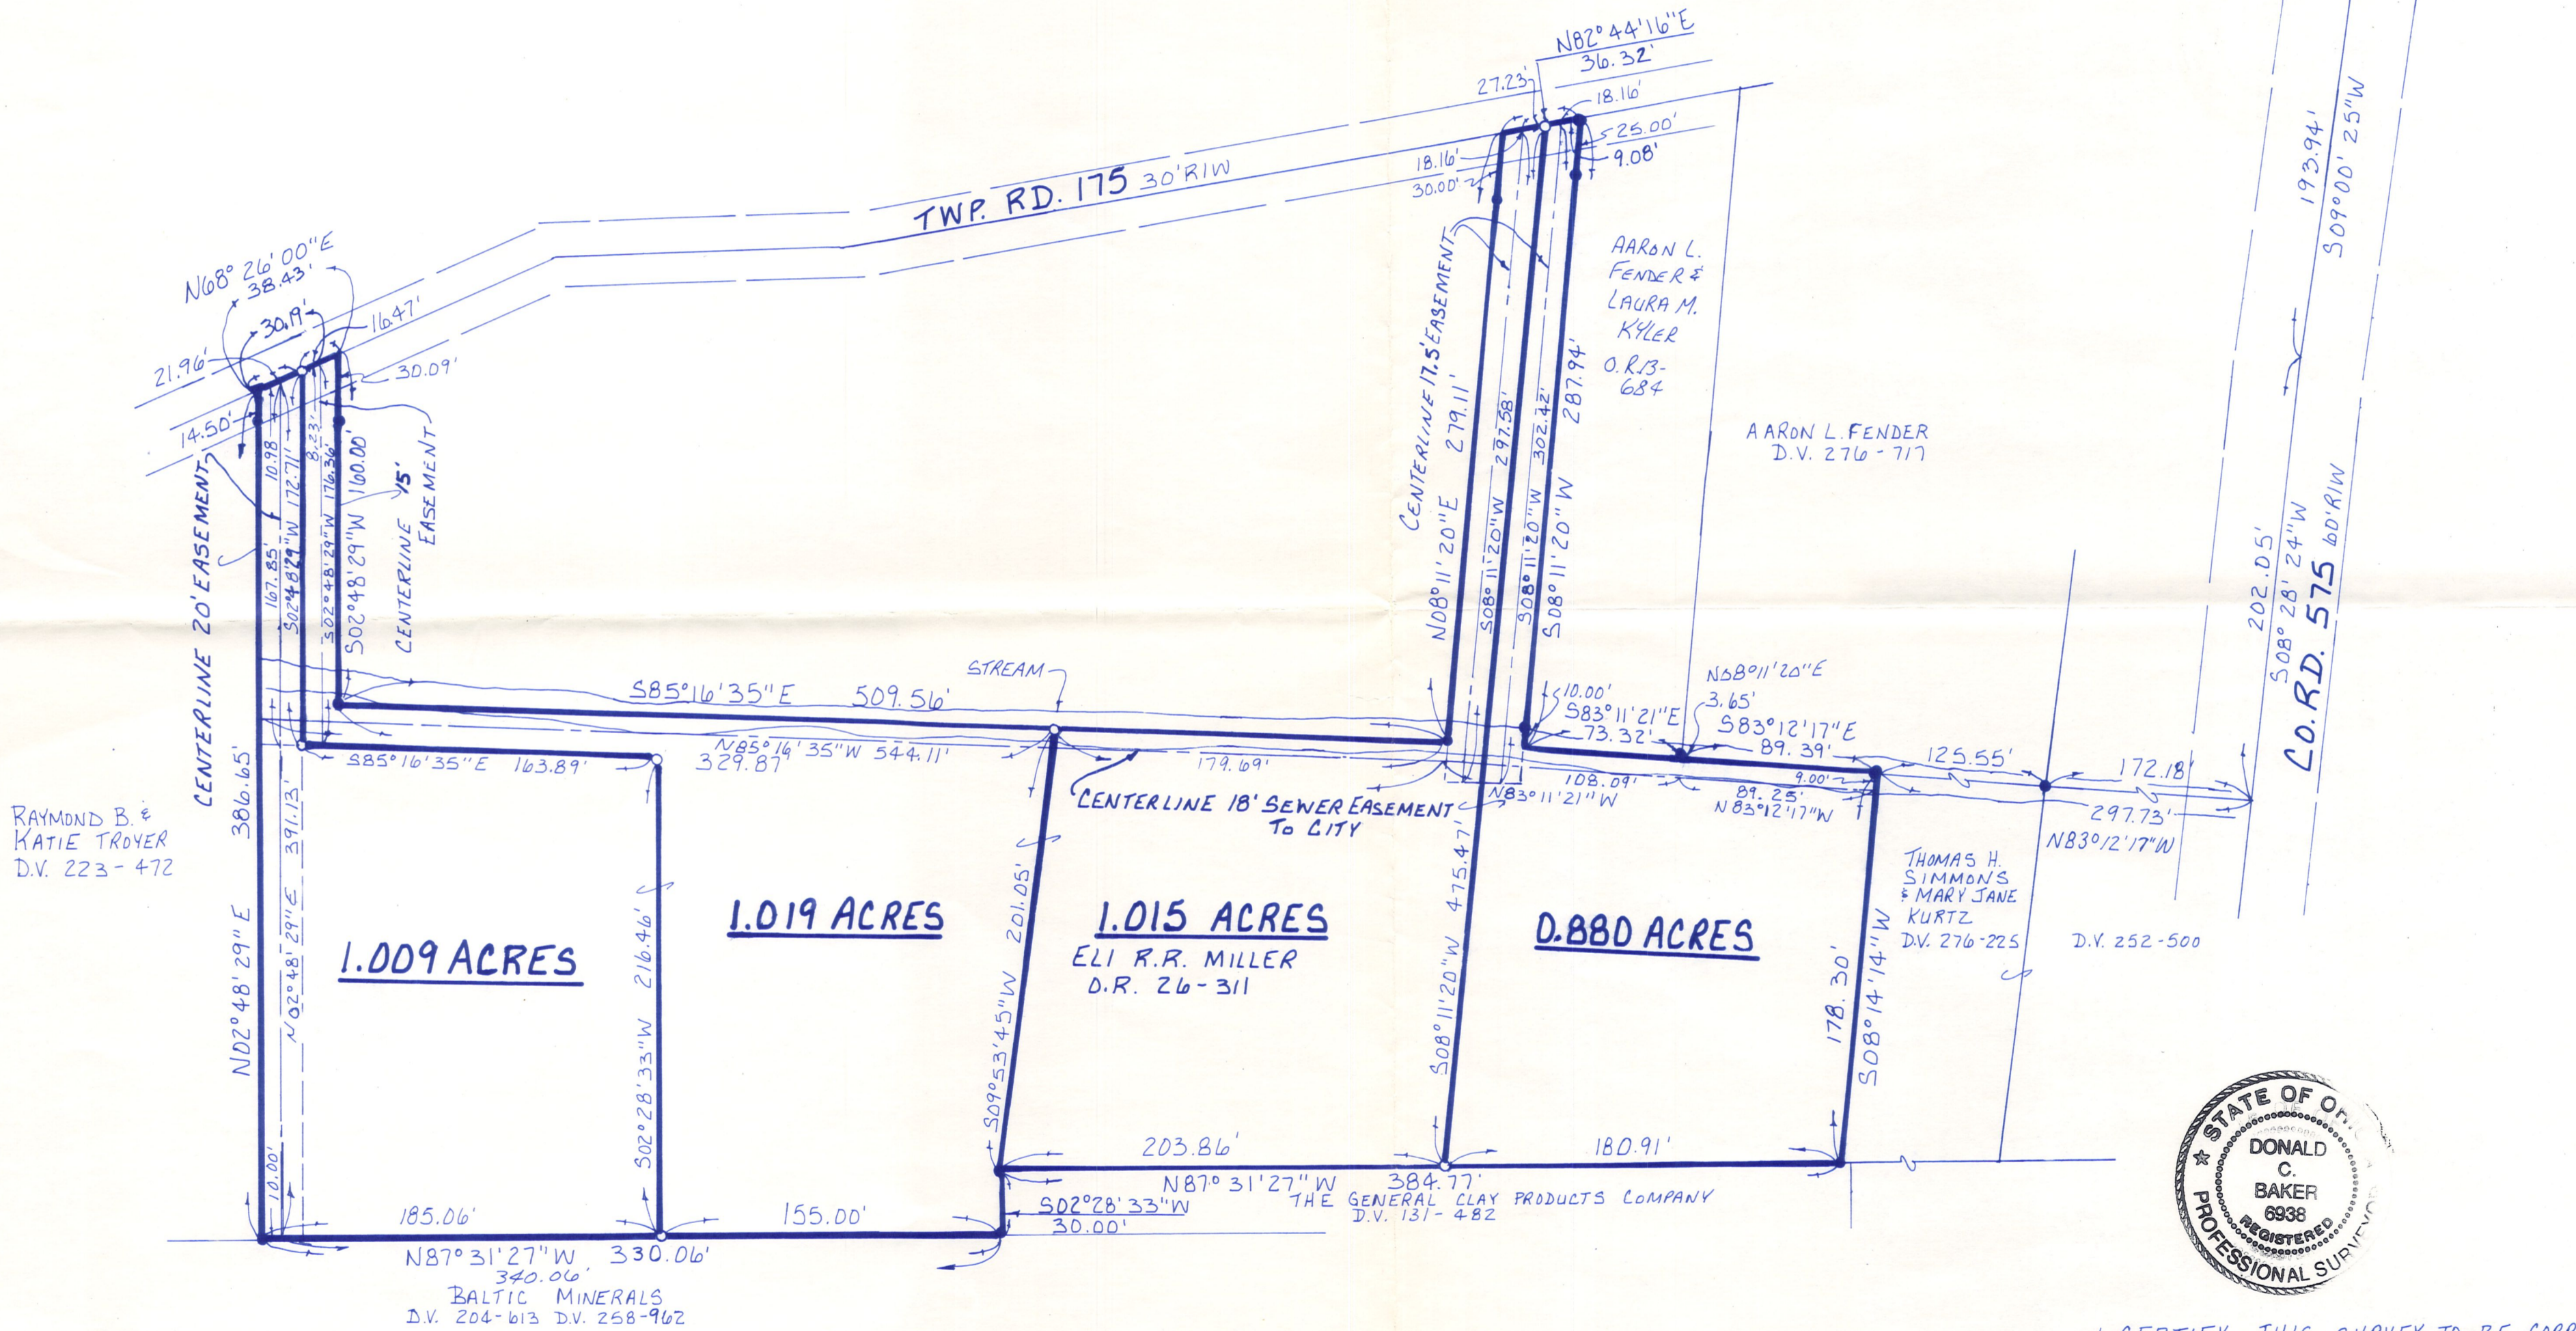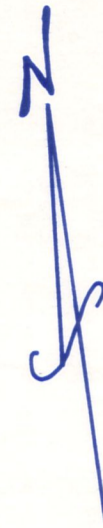

I CERTIFY THIS SURVEY TO BE CORRECT TO THE BEST OF MY KNOWLEDGE.

Donald C. Baker
DONALD C. BAKER P.S. 6938
138 N. CLAY ST.
MILLERSBURG, OHIO 44654
PH: (330) 674-4788

FEBRUARY 25, 1999 # 9599-FJM
F.C.C. - J.D. DARR