

PROPERTY LINE SURVEY

CLARK TOWNSHIP
S.E. QTR. SECTION 6
T-8 N; R-4 W
HOLMES COUNTY, OHIO

SURVEYED FOR: MYRON TROYER

REFERENCES

- DEED VOL. 194 PAGE 404
- DEED VOL. 267 PAGE 237
- O.R. VOL. 37 PAGE 285
- O.R. VOL. 184 PAGE 3332
- O.R. VOL. 217 PAGE 2656
- O.R. VOL. 230 PAGE 1838
- O.R. VOL. 230 PAGE 1843
- PLAT VOL. 15 PAGE 26



BEARINGS FROM PLAT VOL. 15 PAGE 26



SCALE: 1"=200'

- ▲ R.R. SPIKE FOUND
- 5/8" REBAR FOUND
- UNLESS OTHERWISE NOTED
- 5/8" REBAR SET WITH I.D. CAP
- I.D. CAP MARKED "BAKER 6938"

NOV 25 '15 AM 9:00

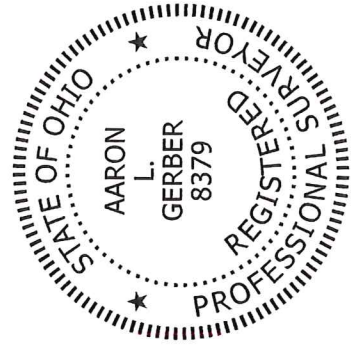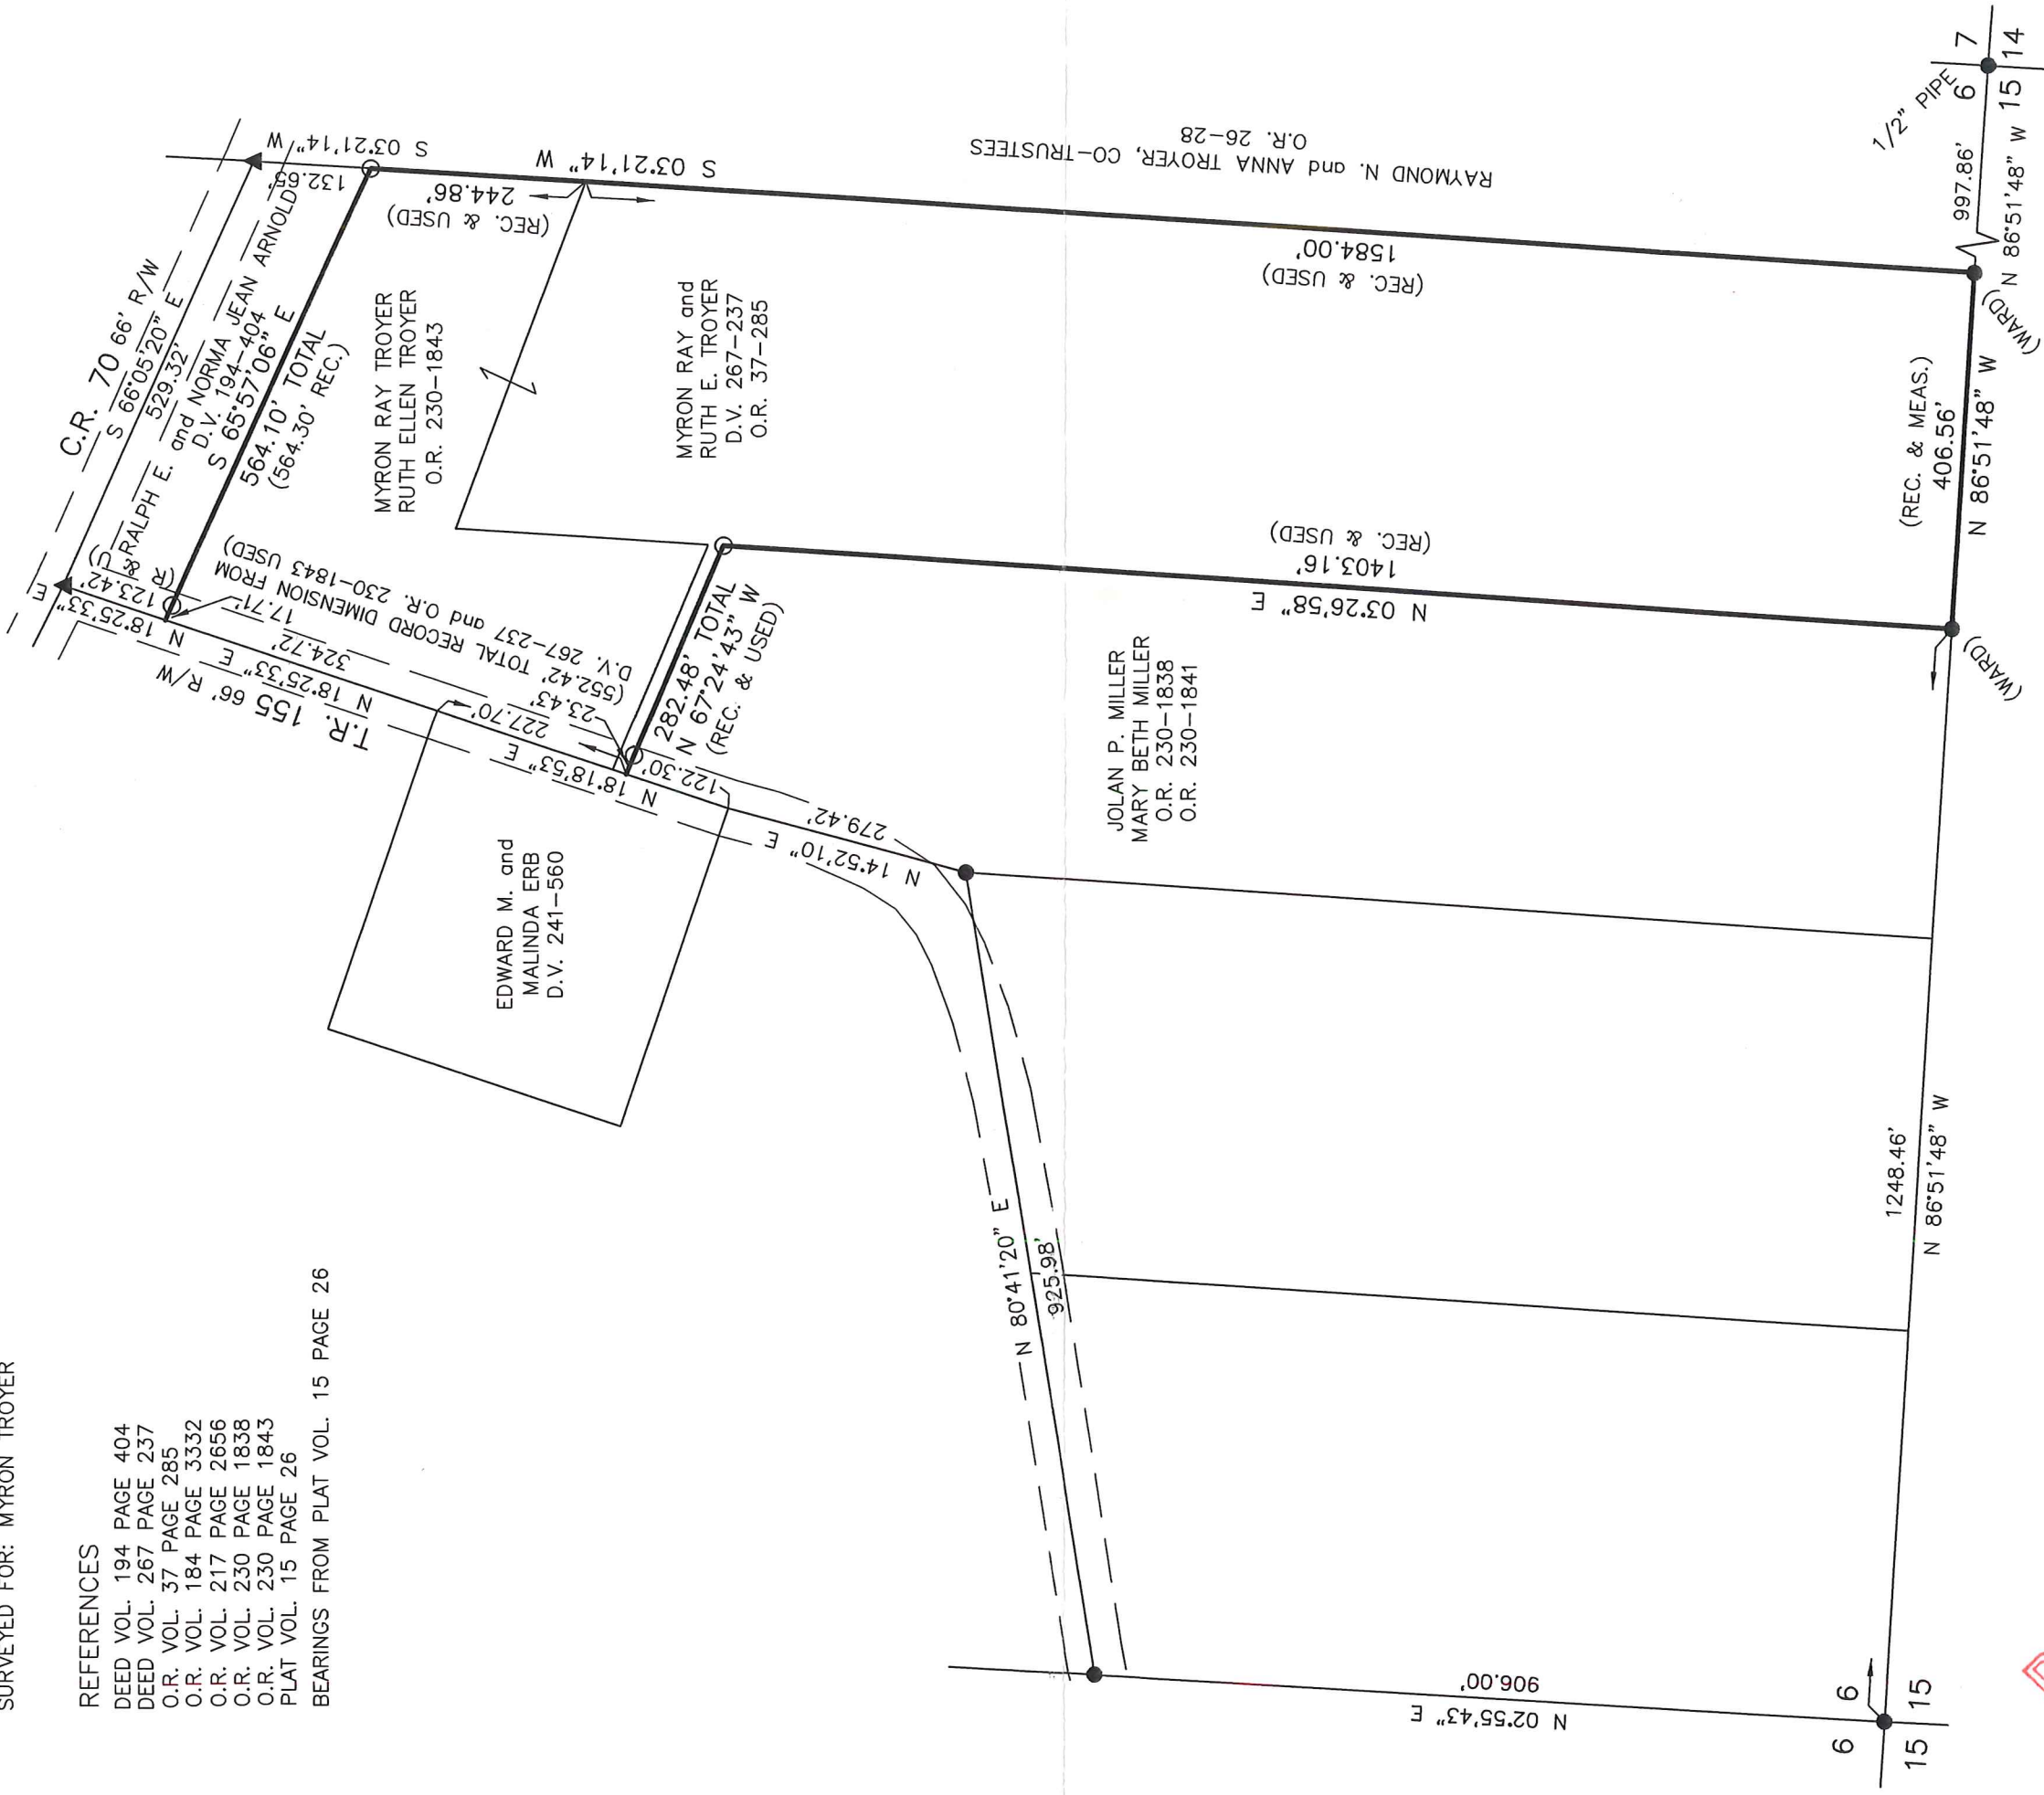

I CERTIFY THIS SURVEY TO BE CORRECT TO THE BEST OF MY KNOWLEDGE.

A.L.G.
 AARON L. GERBER P.S. 8379
 DATE: OCTOBER 30, 2015
 ALG\JNG
 FILE NAME: WORK5\15-5937-15\ALG

DONALD C. BAKER SURVEYING
 138 N. CLAY STREET
 MILLERSBURG, OHIO 44654
 PH. 330-674-4788
 FAX 330-674-6027
 EMAIL: bakersurveying@gmail.com