
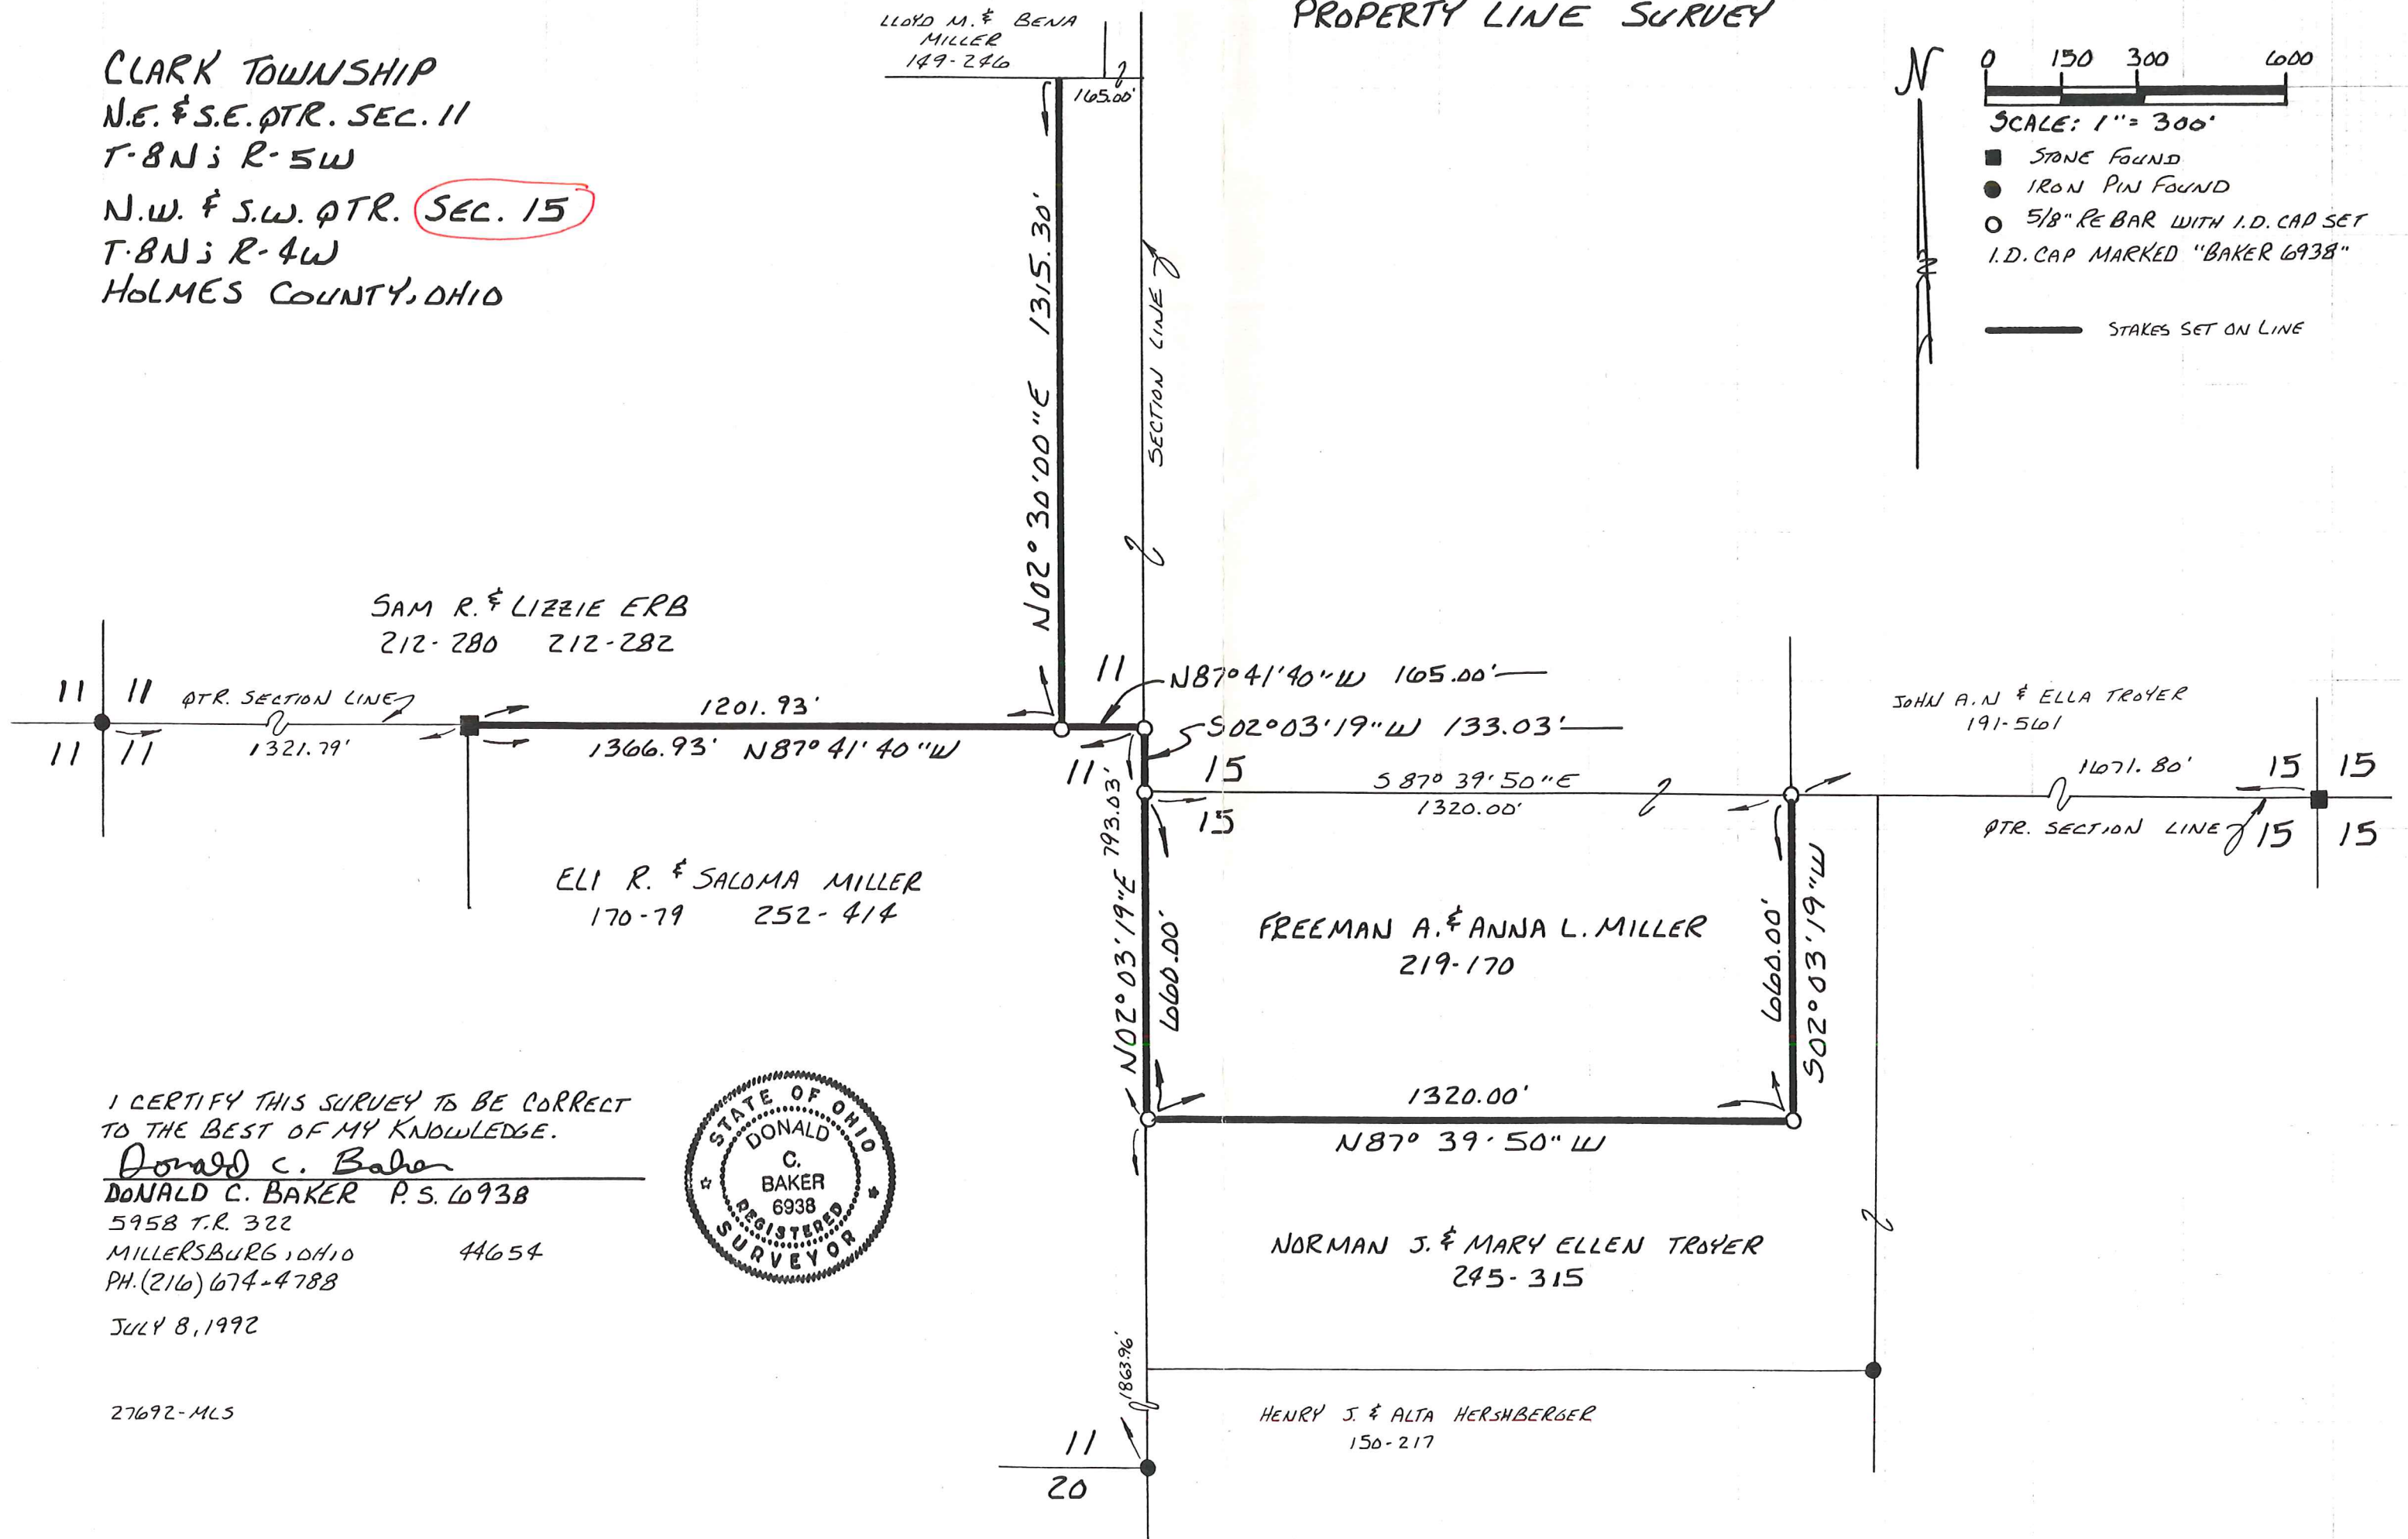


CLARK TOWNSHIP  
 N.E. & S.E. QTR. SEC. 11  
 T-8N; R-5W  
 N.W. & S.W. QTR. **SEC. 15**  
 T-8N; R-4W  
 HOLMES COUNTY, OHIO

PROPERTY LINE SURVEY

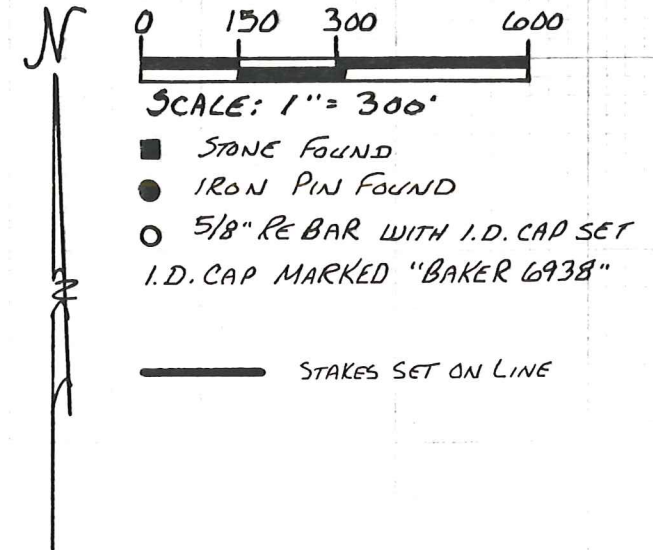

I CERTIFY THIS SURVEY TO BE CORRECT TO THE BEST OF MY KNOWLEDGE.

Donald C. Baker  
 DONALD C. BAKER P.S. 6938  
 5958 T.R. 322  
 MILLERSBURG, OHIO 44654  
 PH. (216) 674-4788  
 JULY 8, 1992

