


CLARK TOWNSHIP
 N.E. QTR. SECTION 17
 T-8N; R-4W
 HOLMES COUNTY, OHIO
 SURVEYED FOR VERNON MULLET

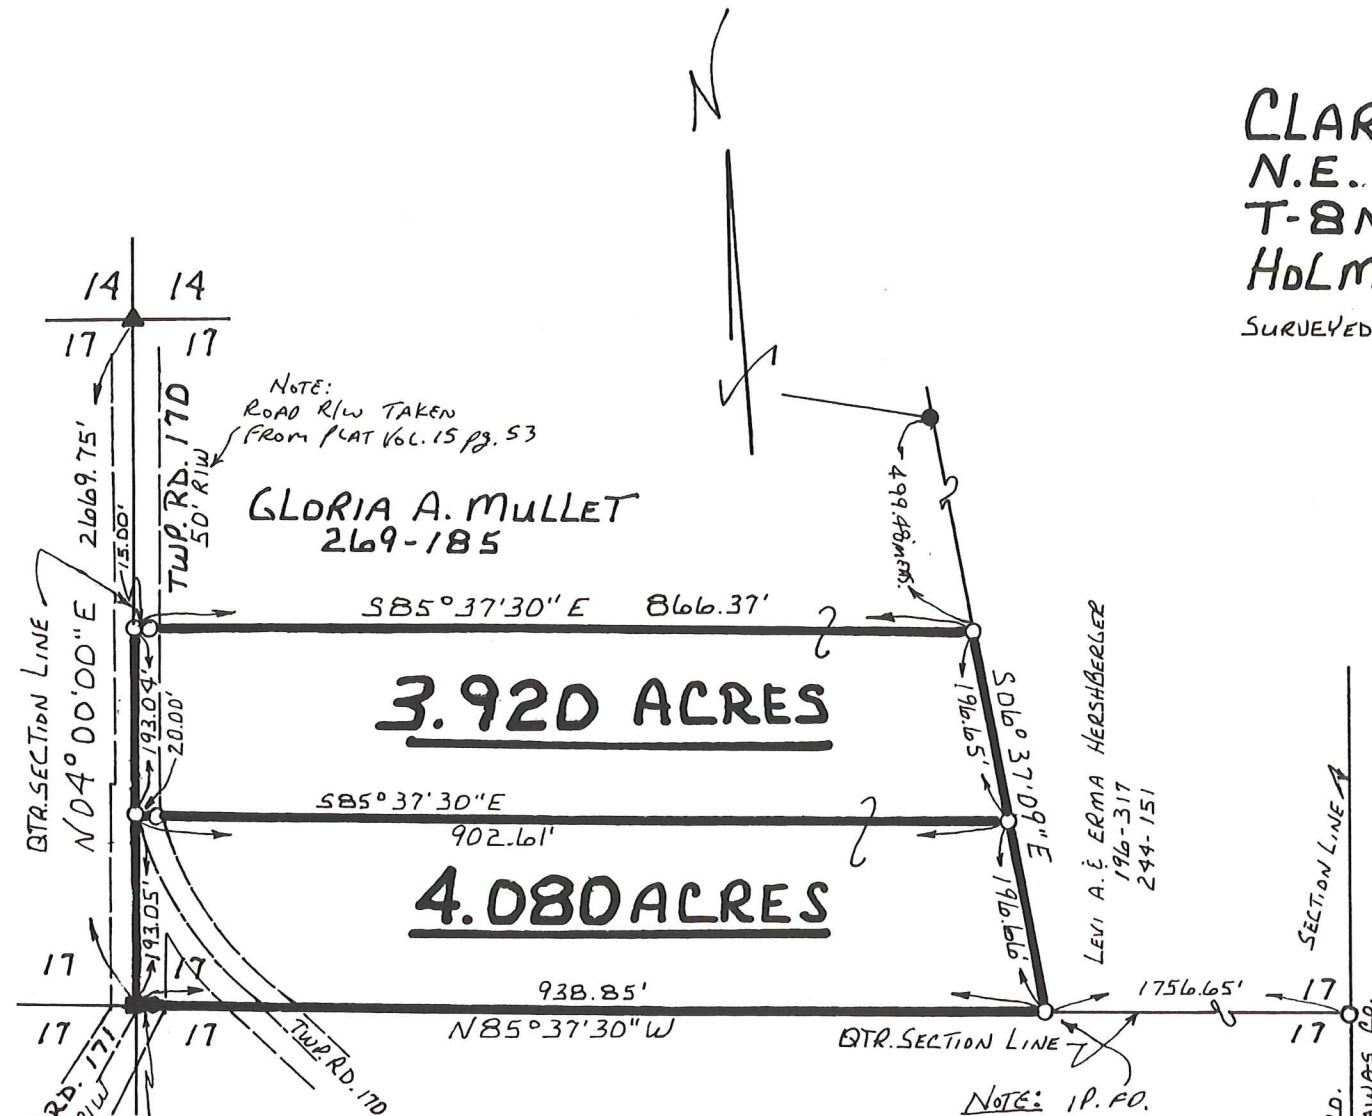

SCALE: 1" = 200'

- IRON PIN FOUND
- STONE FOUND
- ▲ R.R. SPIKE FOUND
- 3/8" REBAR WITH ID. CAP SET
 ID. CAP MARKED "BAKER 6938"

REFERENCES:

- DEED VOL. 269 PAGE 185
- DEED VOL. 244 PAGE 151
- DEED VOL. 272 PAGE 514
- DEED VOL. 182 PAGE 188

I CERTIFY THIS SURVEY TO BE CORRECT
 TO THE BEST OF MY KNOWLEDGE.

Donald C. Baker

DONALD C. BAKER P.S. 6938
 595B T.R. 322
 MILLERSBURG, OHIO 44654
 PH. (330) 674-4788
 OCTOBER 4, 1996
 59696-SRU

