


- LEGEND:
- △ = P.K. NAIL FOUND
 - × = FENCE POST FOUND
 - = I.P. FOUND
 - = I.P. SET (5/8" X 30" RE-BAR W/PLASTIC CAPS STAMPED "JIM SHAMP 6088")
 - = POINT OF DEPARTURE
 - ⊠ = RAILROAD SPIKE SET
 - MEA = MEASURED
 - REC = RECORD
 - TOT = TOTAL


HEARTLAND Surveying			
Jim Shamp			
5210 Twp. Rd. 257 Millersburg, OH 44654			
Phone: 216-674-4698			
SURVEY		DATE	
ROBERT MILLER		OCTOBER 28, 1992	
STATE	COUNTY	TOWNSHIP	RANGE
OHIO	HOLMES	CLARK	5 WEST
TOWNSHIP		SECTION 3	
8 NORTH			

I CERTIFY THIS TO BE A TRUE PLAT OF A FIELD SURVEY COMPLETED ON OCTOBER 28, 1992:

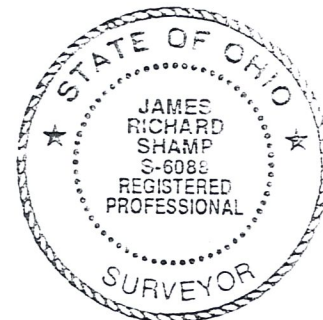

J. Shamp
 JIM SHAMP, REG. SUR. NO. S-6088

BEARINGS ESTABLISHED FROM A SURVEY OF A 0.721 ACRE TRACT BY THIS SUVEYOR COMPLETED ON OCTOBER 21, 1991.

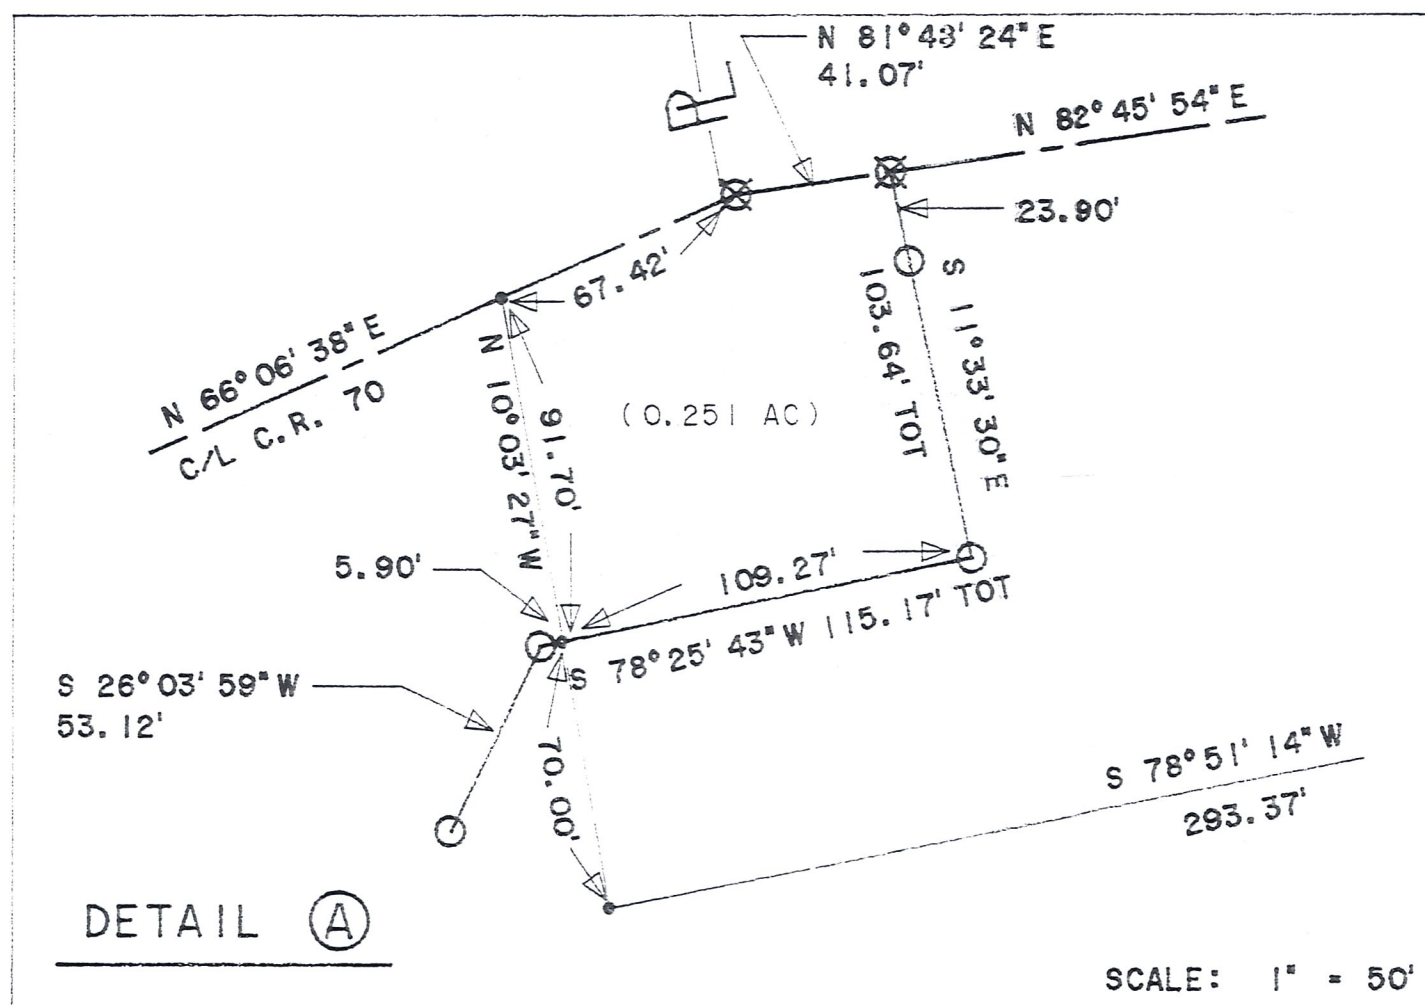

MERVIN H. & EMMA SHETLER
 V. 225, P. 421

