



CLARK TOWNSHIP  
 S.W. QTR. SECTION 4  
 T-8 N; R-5 W  
 HOLMES COUNTY, OHIO

SURVEYED FOR: WAYNE SHETLER

REFERENCES:

DEED VOL. 274 PAGE 495  
 O.R. VOL. 28 PAGE 540  
 O.R. VOL. 92 PAGE 175  
 PLAT VOL. 17 PAGE 2  
 BEARINGS FROM PLAT VOL. 17 PAGE 2

RECEIVED  
 SEP 04 2003  
 Hol. Co. Tax Map Office

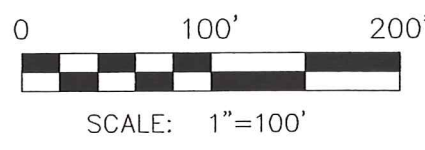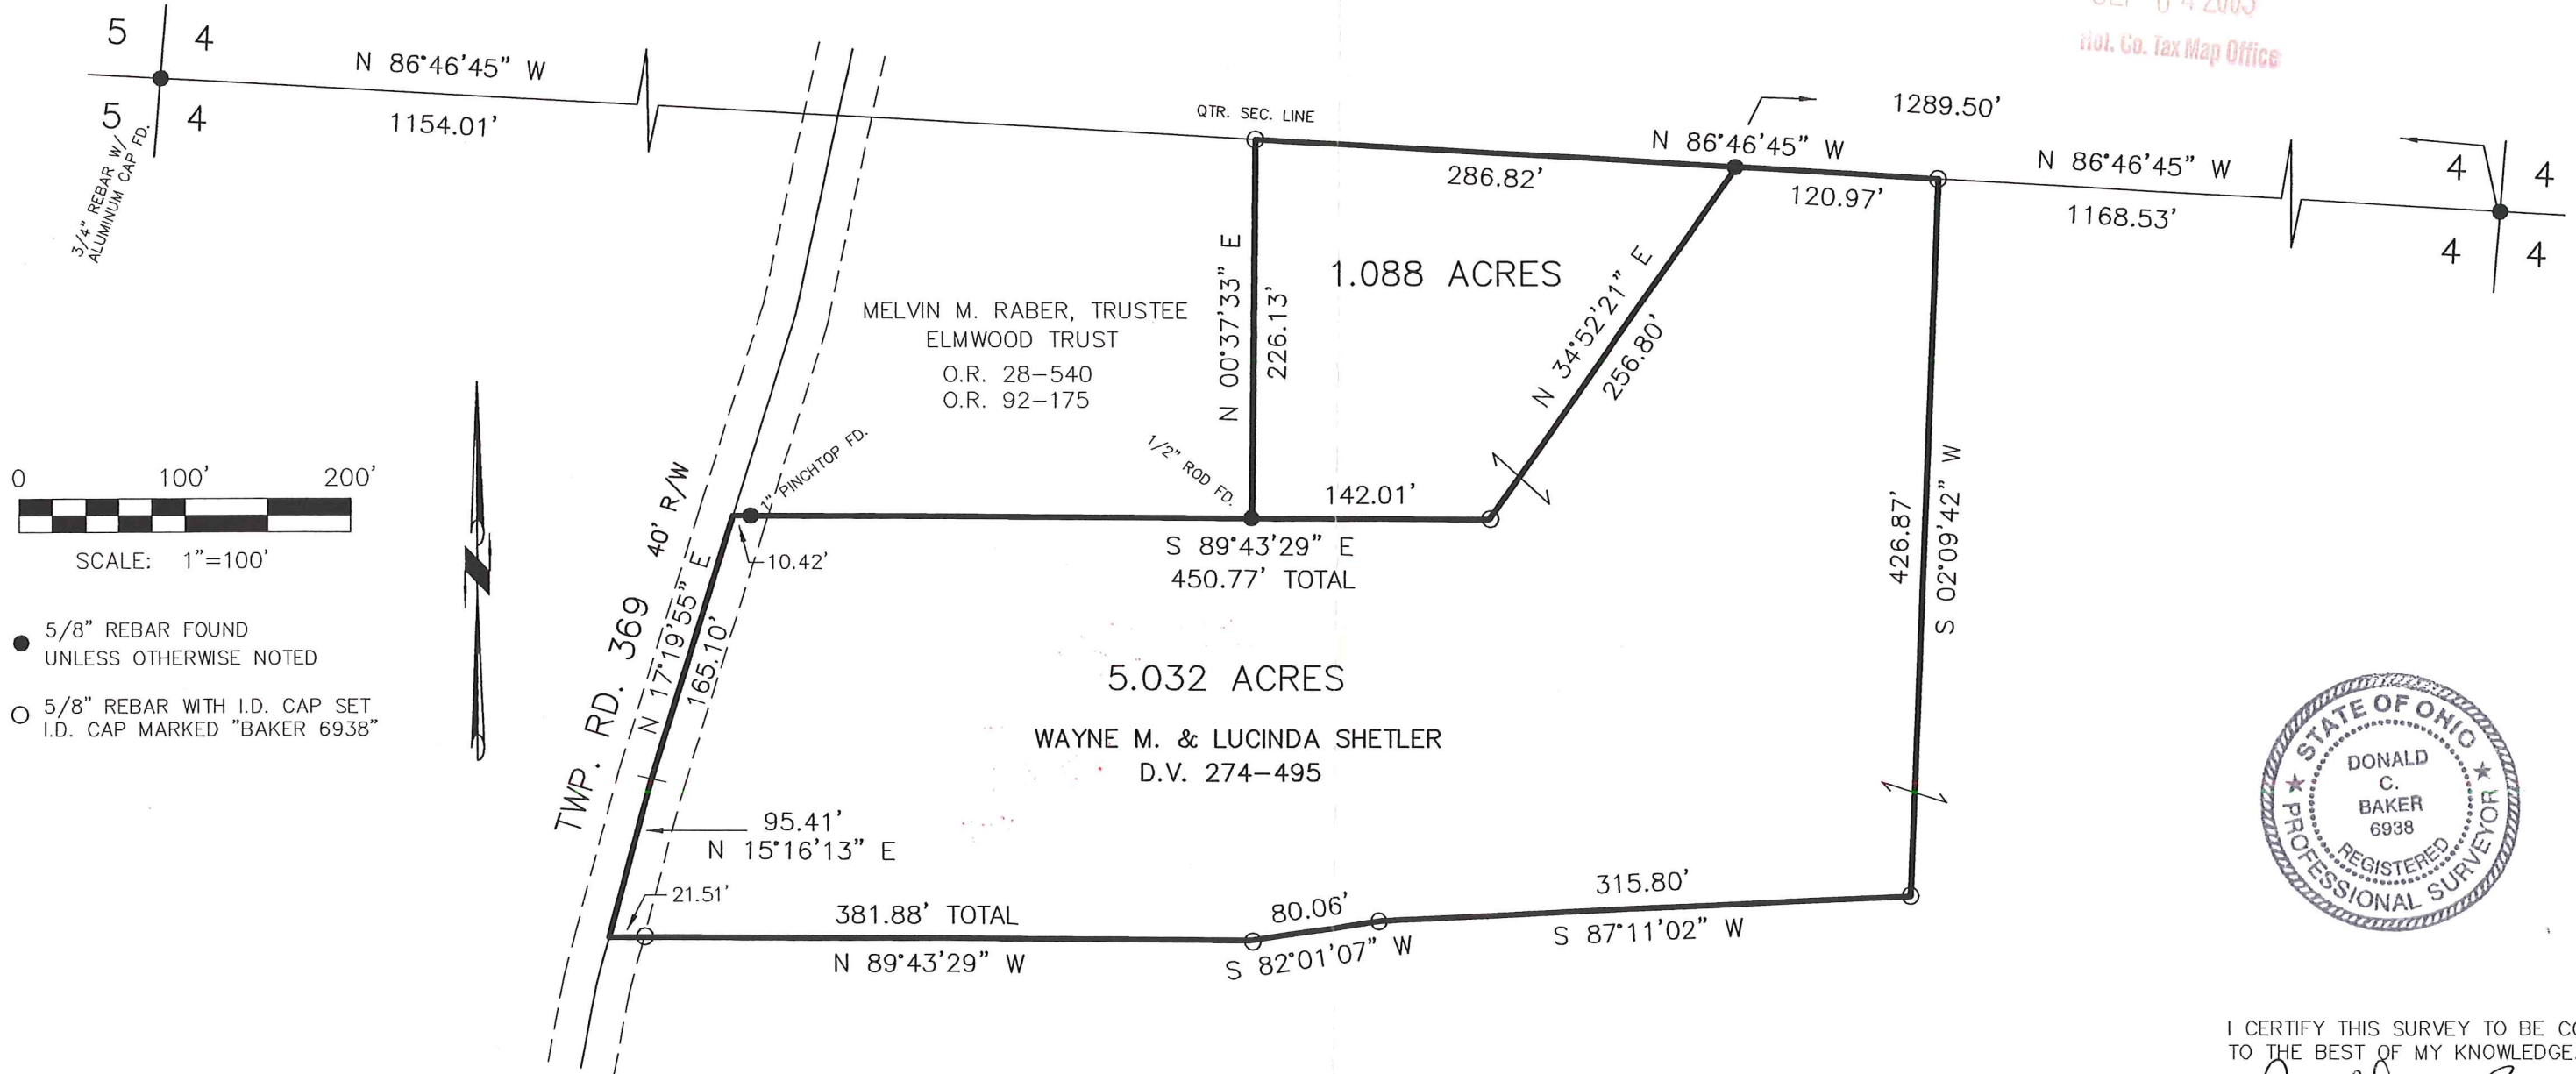

- 5/8" REBAR FOUND UNLESS OTHERWISE NOTED
- 5/8" REBAR WITH I.D. CAP SET I.D. CAP MARKED "BAKER 6938"



I CERTIFY THIS SURVEY TO BE CORRECT TO THE BEST OF MY KNOWLEDGE.

*Donald C. Baker*  
 DONALD C. BAKER PS 6938

DATE: JULY 30, 2003  
 REVISED: SEPT 3, 2003

FCC\FDB  
 File Name: C:\JOBS\S-622-03\ERZ  
 S-738-03

DONALD C. BAKER SURVEYING  
 138 N. CLAY ST.  
 MILLERSBURG, OH 44654  
 PH. 330-674-4788  
 FAX: 330-674-6027