

RETRACEMENT SURVEY OF
DEED VOL. 234 PAGE 812

VILLAGE OF CHARM
CLARK TOWNSHIP
S.E. QTR. SECTION 5
T-8 N; R-5 W
HOLMES COUNTY, OHIO

JUN 2 '14 AM 8:53

0 100 200



SCALE: 1"=100'

● 5/8" REBAR FOUND
UNLESS OTHERWISE NOTED


○ P.K. NAIL SET

○ 5/8" REBAR SET WITH I.D. CAP
I.D. CAP MARKED "BAKER 6938"

SURVEYED FOR: ANN DeHASS

REFERENCES

- DEED VOL. 203 PAGE 443
- DEED VOL. 234 PAGE 812
- DEED VOL. 275 PAGE 229
- DEED VOL. 275 PAGE 232
- PLAT VOL. 10 PAGE 824
- PLAT VOL. 7 PAGE 320
- PLAT VOL. 12 PAGE 756
- BEARINGS FROM PLAT VOL. 12 PAGE 756

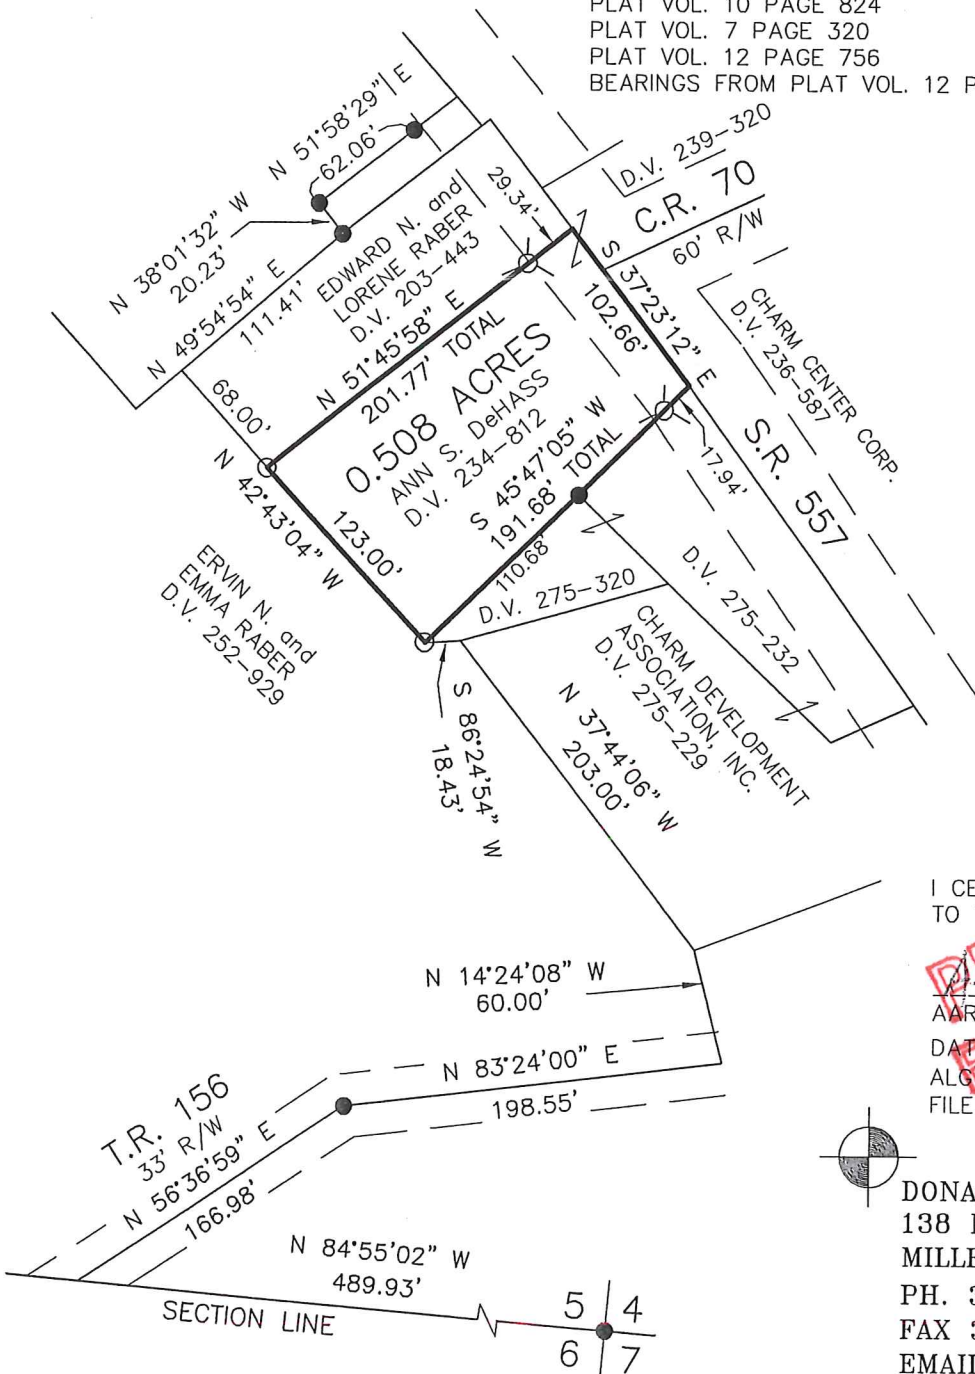

I CERTIFY THIS SURVEY TO BE CORRECT
TO THE BEST OF MY KNOWLEDGE.

Aaron L. Gerber P.S. 8379

DATE: MAY 29, 2014

ALC/FDB

FILE NAME: WORK5\S-223-14\AG-MD



DONALD C. BAKER SURVEYING
138 N. CLAY STREET
MILLERSBURG, OHIO 44654

PH. 330-674-4788

FAX 330-674-6027

EMAIL: bakersurveying@gmail.com