


RETRACEMENT SURVEY OF O.R. 208-3229
 CLARK TOWNSHIP
 N.E. QTR. SECTION 6
 T-8 N; R-5 W
 HOLMES COUNTY, OHIO

SURVEYED FOR: ERVIN KEIM

REFERENCES

- DEED VOL. 131 PAGE 82
 O.R. VOL. 41 PAGE 110 PLAT VOL. 8 PAGE 838
 O.R. VOL. 90 PAGE 710 PLAT VOL. 16 PAGE 769
 O.R. VOL. 169 PAGE 2669 PLAT VOL. 17 PAGE 287
 O.R. VOL. 208 PAGE 3229 PLAT VOL. 18 PAGE 881

BEARINGS FROM PLAT VOL. 16 PAGE 769

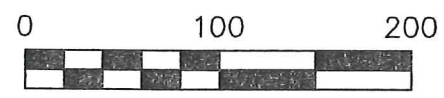


SCALE: 1"=100'

- ▲ R.R. SPIKE FOUND
- 5/8" REBAR FOUND UNLESS OTHERWISE NOTED
- 5/8" REBAR WITH I.D. CAP SET I.D. CAP MARKED "BAKER 6938"



DONALD C. BAKER SURVEYING
 138 N. CLAY ST.
 MILLERSBURG, OHIO, 44654
 PH. 330-674-4788
 FAX. 330-674-6027

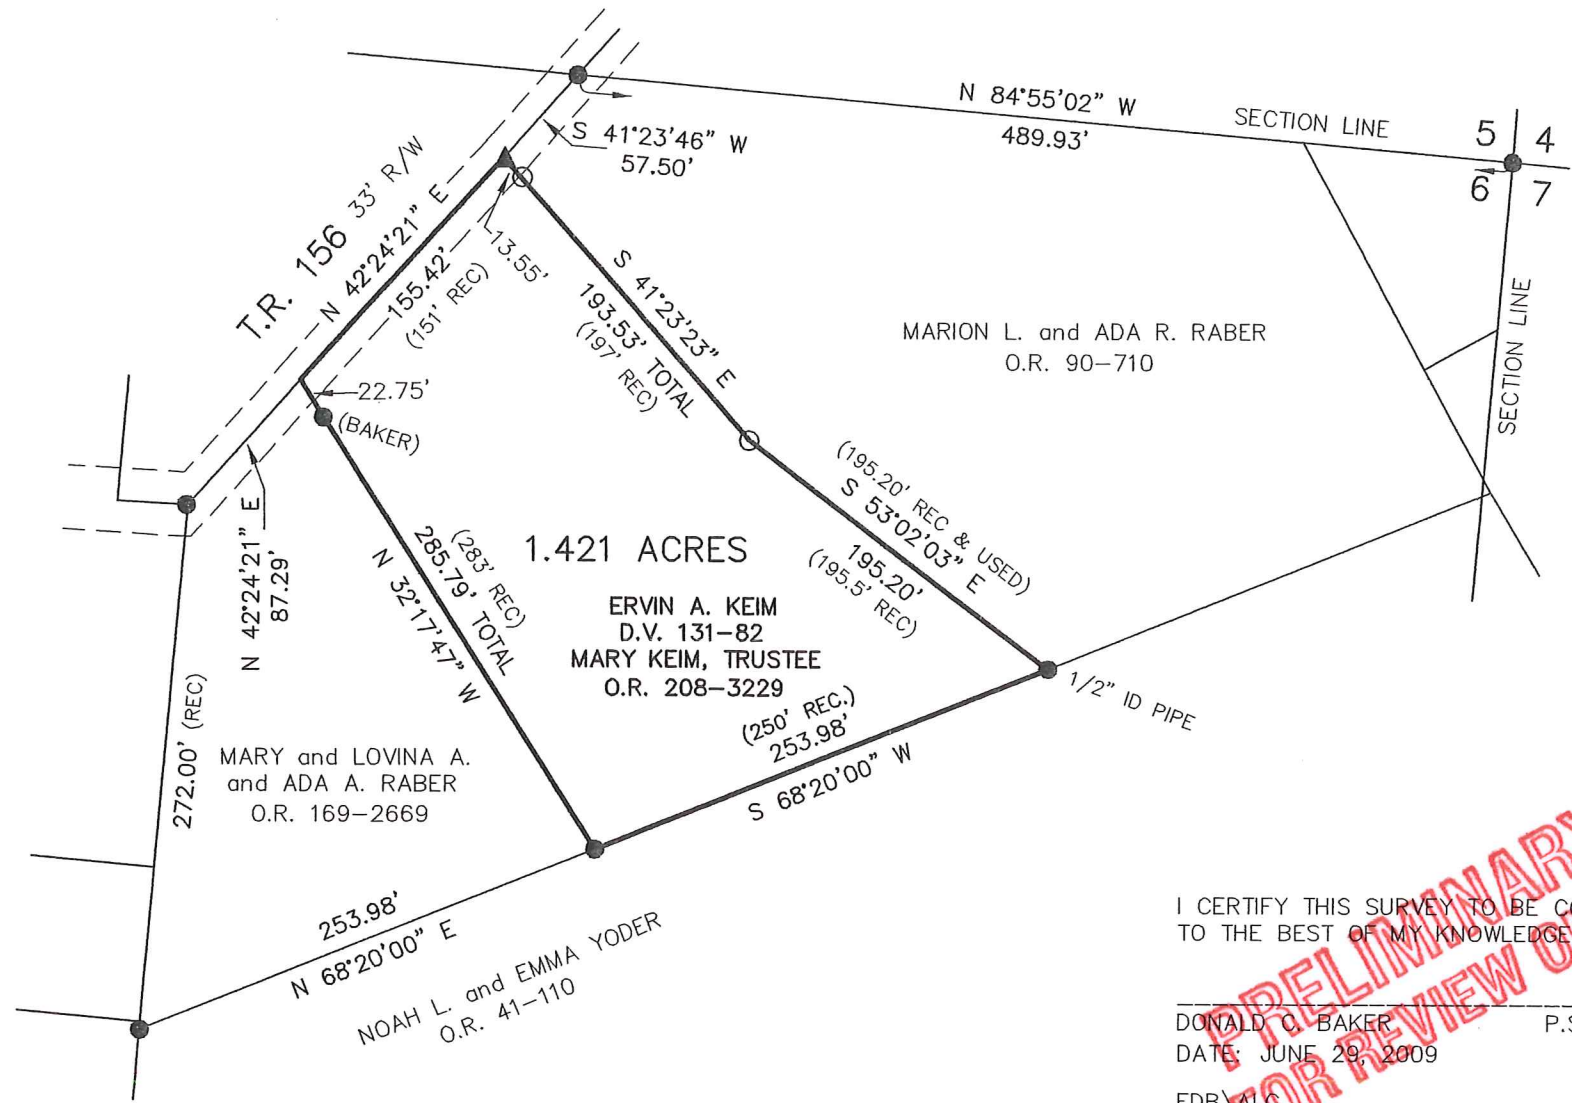

PRELIMINARY FOR REVIEW ONLY

I CERTIFY THIS SURVEY TO BE CORRECT TO THE BEST OF MY KNOWLEDGE.

DONALD C. BAKER P.S. 6938
 DATE: JUNE 29, 2009

FDB/ALG
 File Name: WORK2\S-293-09\ERZ