


CLARK TOWNSHIP
 N.E. QTR. SECTION 7
 T-8 N; R-5 W
 HOLMES COUNTY, OHIO

SURVEYED FOR: CHARM BUILDERS, LTD.

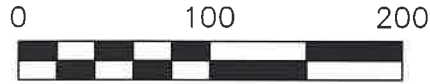

SCALE: 1"=100'

- 5/8" REBAR FOUND
UNLESS OTHERWISE NOTED
- 5/8" REBAR SET WITH I.D. CAP
I.D. CAP MARKED "BAKER 6938"



I CERTIFY THIS SURVEY TO BE CORRECT
 TO THE BEST OF MY KNOWLEDGE.


Donald C. Baker

DONALD C. BAKER P.S. 6938

DATE: FEB. 11, 2022

TAB

FILE NAME: WORK6\S-82-22\CNK

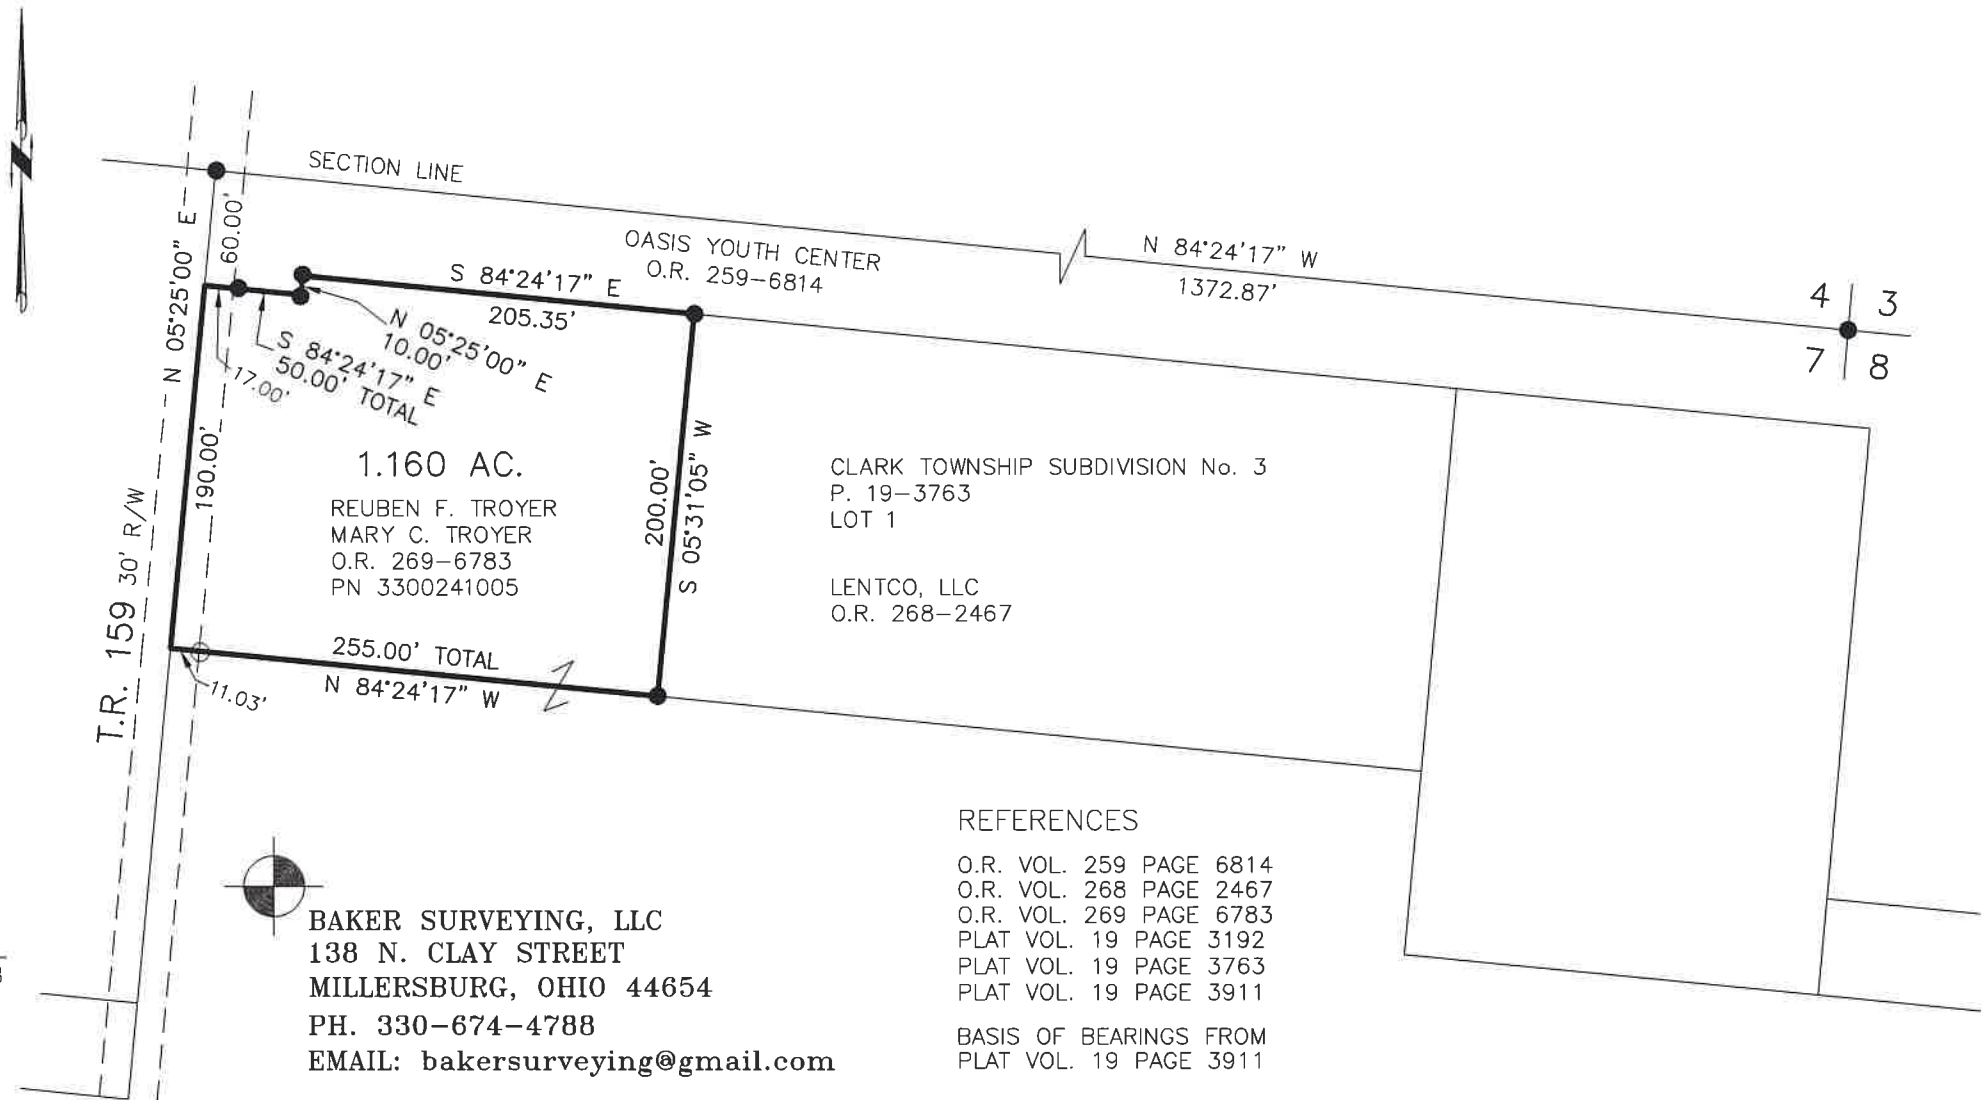

BAKER SURVEYING, LLC
 138 N. CLAY STREET
 MILLERSBURG, OHIO 44654
 PH. 330-674-4788
 EMAIL: bakersurveying@gmail.com

REFERENCES

- O.R. VOL. 259 PAGE 6814
- O.R. VOL. 268 PAGE 2467
- O.R. VOL. 269 PAGE 6783
- PLAT VOL. 19 PAGE 3192
- PLAT VOL. 19 PAGE 3763
- PLAT VOL. 19 PAGE 3911

BASIS OF BEARINGS FROM
 PLAT VOL. 19 PAGE 3911