



CLARK TOWNSHIP
 N.E. QTR. SECTION 17
 TWP. 8N RANGE 5W
 HOLMES COUNTY, OHIO

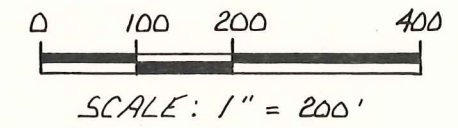

- STONE FOUND
- IRON PIN FOUND
- 5/8" REBAR WITH I.D. CAP SET
- I.D. CAP MARKED "BAKER 6938"

REFERENCES:
 PLAT VOL. 5 PAGE 137
 DEED VOL. 226 PAGE 353
 BEARINGS FROM DEED VOL. 198 PAGE 420

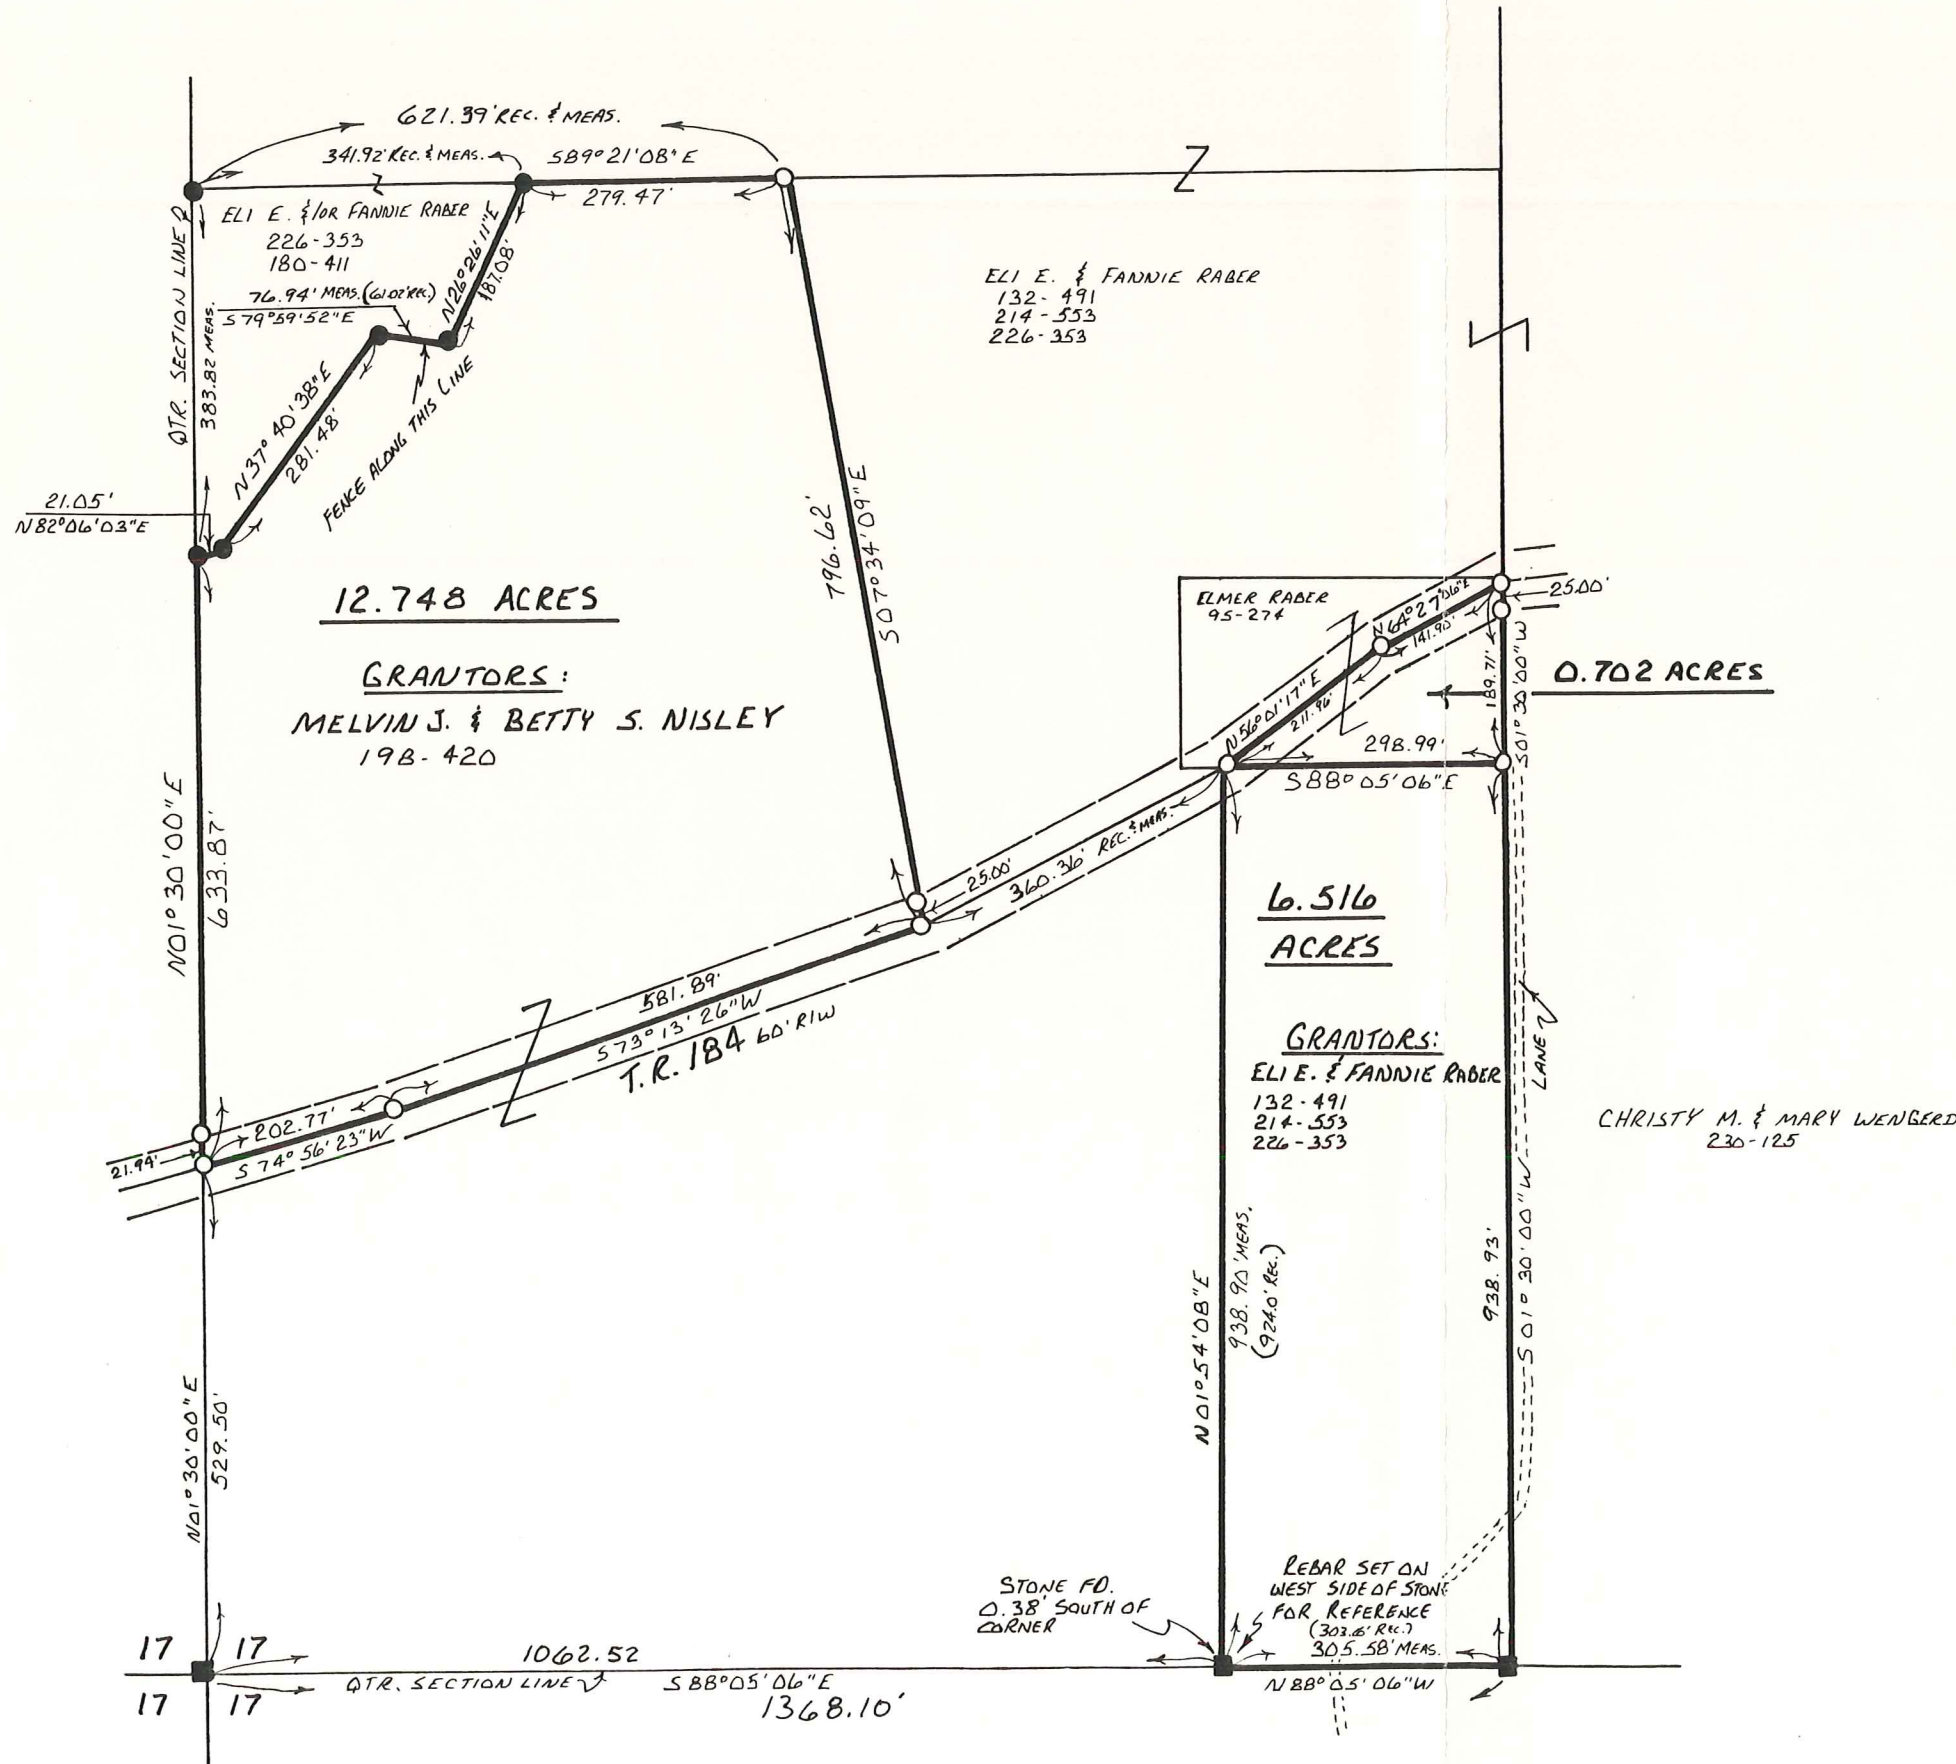

I CERTIFY THIS SURVEY TO BE CORRECT
 TO THE BEST OF MY KNOWLEDGE.
Donald C. Baker
 DONALD C. BAKER P.S. 6938
 4321 T.R. 252
 GLENMONT, OHIO

AUG. 23, 1989
 REV. 1-12-1990