
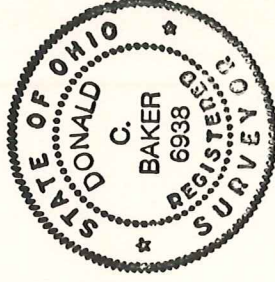
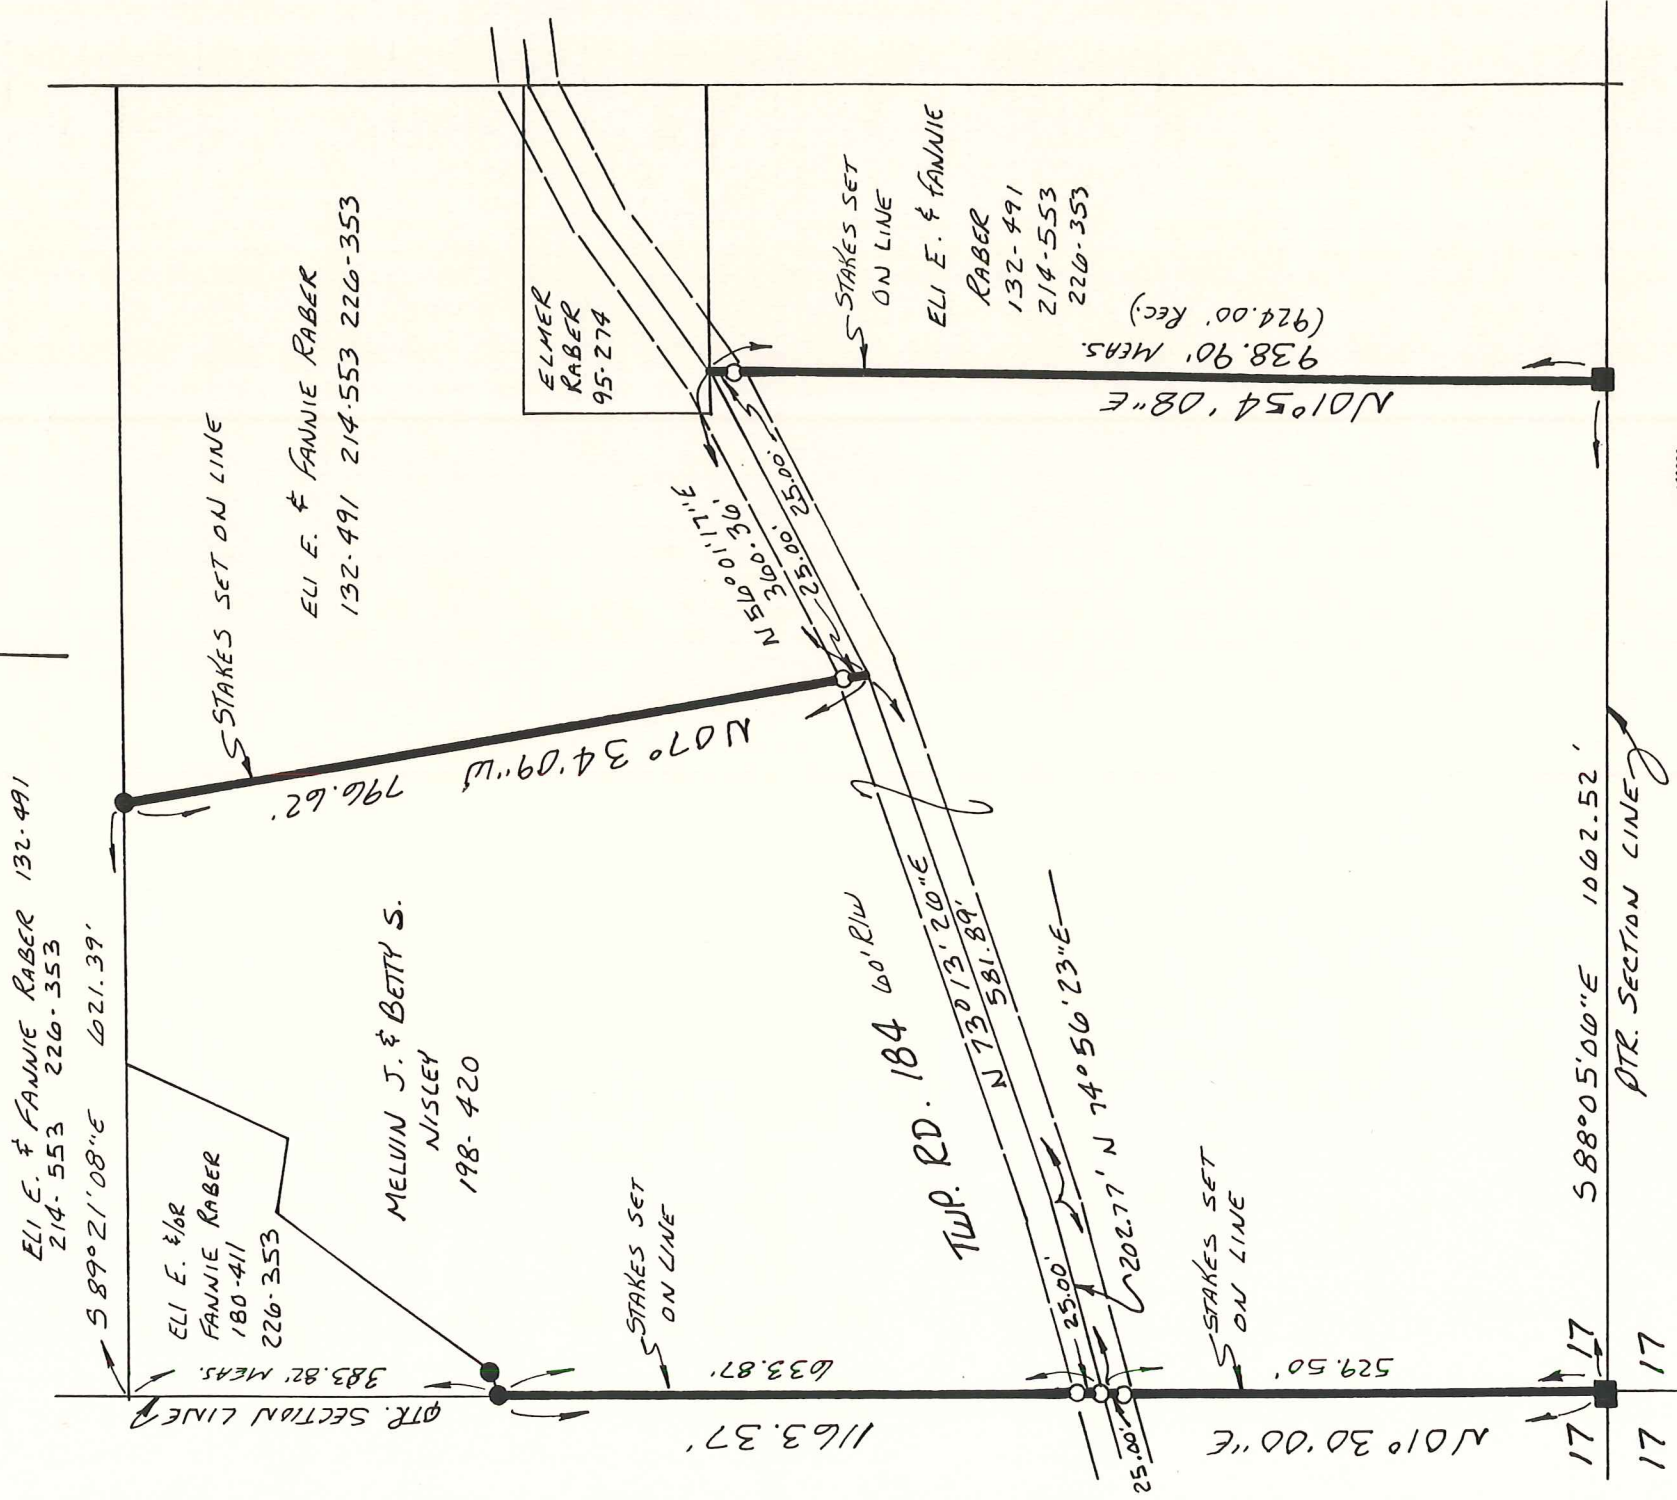


CLARK TOWNSHIP
 N.E. QTR. SECTION 17
 T. 8 N ; R. 5 W
 HOLMES COUNTY, OHIO

PROPERTY LINE SURVEY

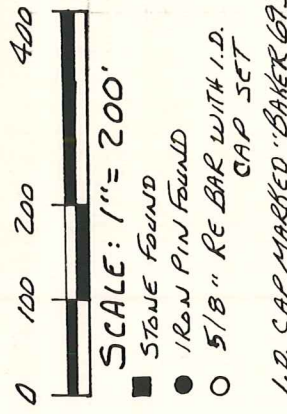

I CERTIFY THIS SURVEY TO BE CORRECT TO THE BEST OF MY KNOWLEDGE.

Donald C. Baker
 DONALD C. BAKER P.S. 6938
 5958 T.R. 322
 MILLERSBURG, OHIO 44654
 PH. (216) 674-4788

JUNE 17, 1992

25192-MLS