


CLARK TOWNSHIP
 N.E. QTR. SECTION 17
 T-8N-J-R-5W
 HOLMES COUNTY, OHIO



0 100 200 400
 SCALE: 1" = 100'
 ■ STONE FOUND
 ● IRON PIN FOUND
 ○ 5/8" RE BAR WITH I.D. CAP SET
 I.D. CAP MARKED "BAKER 6938"

33.61 AC. PARCEL

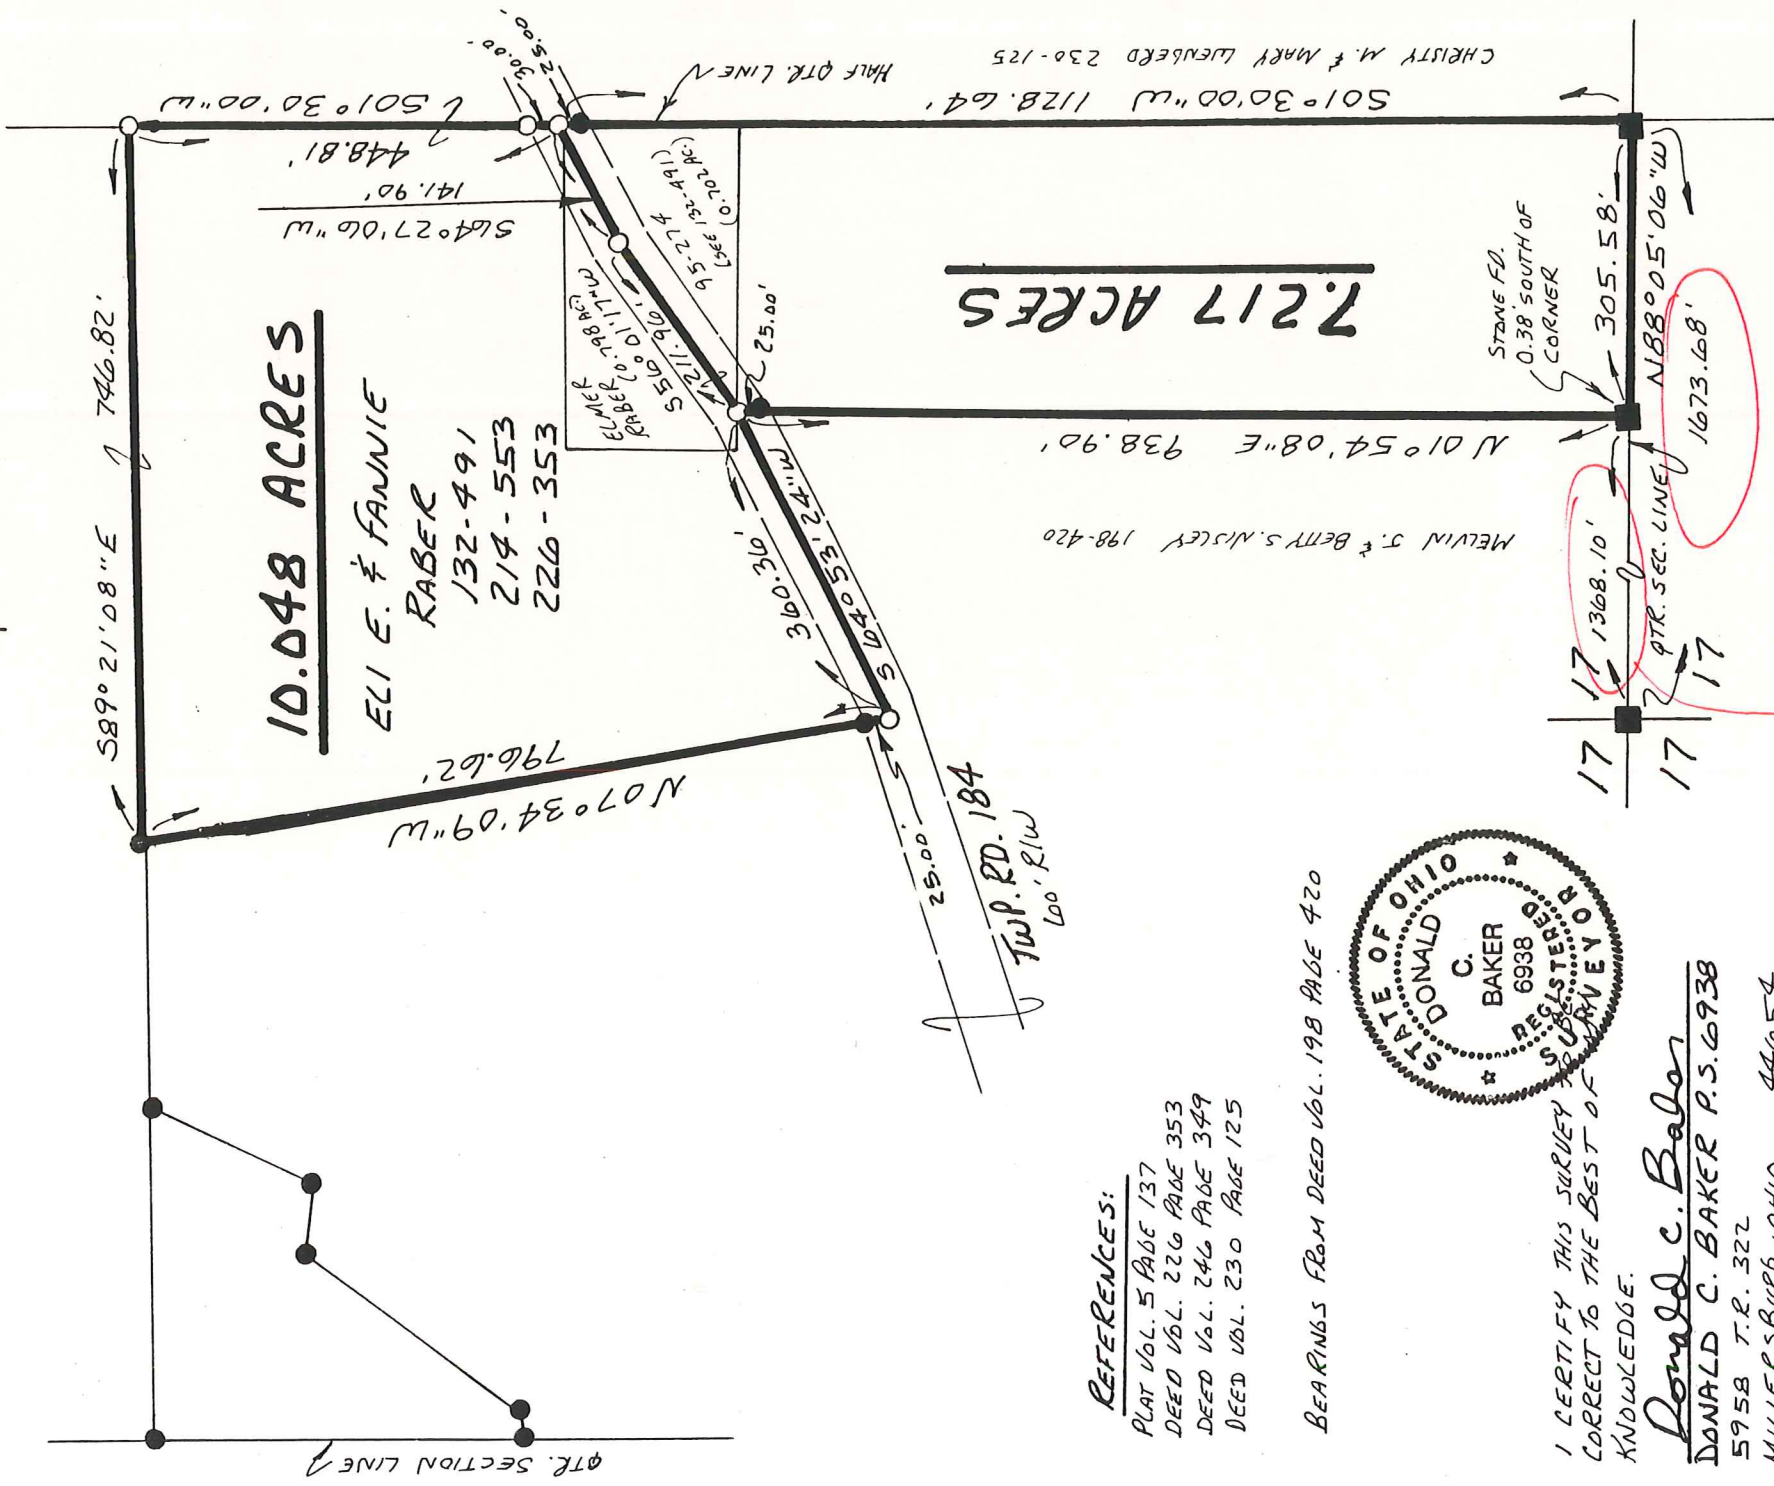

total dist is 1673.68'

REFERENCES:
 PLAT VOL. 5 PAGE 137
 DEED VOL. 226 PAGE 353
 DEED VOL. 246 PAGE 349
 DEED VOL. 230 PAGE 125

BEARINGS FROM DEED VOL. 198 PAGE 420



I CERTIFY THIS SURVEY TO BE CORRECT TO THE BEST OF MY KNOWLEDGE.

Donald C. Baker
 DONALD C. BAKER P.S. 6938
 5958 T.R. 322
 MILLERSBURG, OHIO 44654
 PH. (216) 674-4788

SEPTEMBER 18, 1992