


HEARTLAND Surveying


Jim Shamp
 5210 Twp. Rd. 257 Millersburg, OH 44654
 Phone: 216-674-4698

SURVEY		DATE	
ATLEE BYLER		APRIL 8, 1993	
STATE	COUNTY	TOWNSHIP	RANGE
OHIO	HOLMES		
TOWNSHIP	VILLAGE OF MILLERSBURG		GLASS PLANT ADDITION BLOCK 14 - LOT 1


I CERTIFY THIS TO BE A TRUE PLAT OF A FIELD SURVEY COMPLETED ON APRIL 5, 1993:

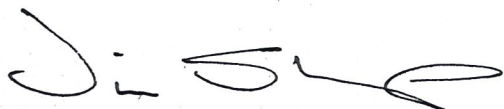

JIM SHAMP, REG. SUR. NO. S-6088

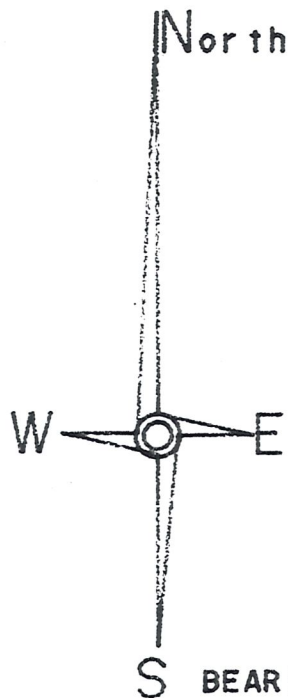

NOTE: THIS IS A RETRACEMENT SURVEY AND IS FOR INFORMATION ONLY.

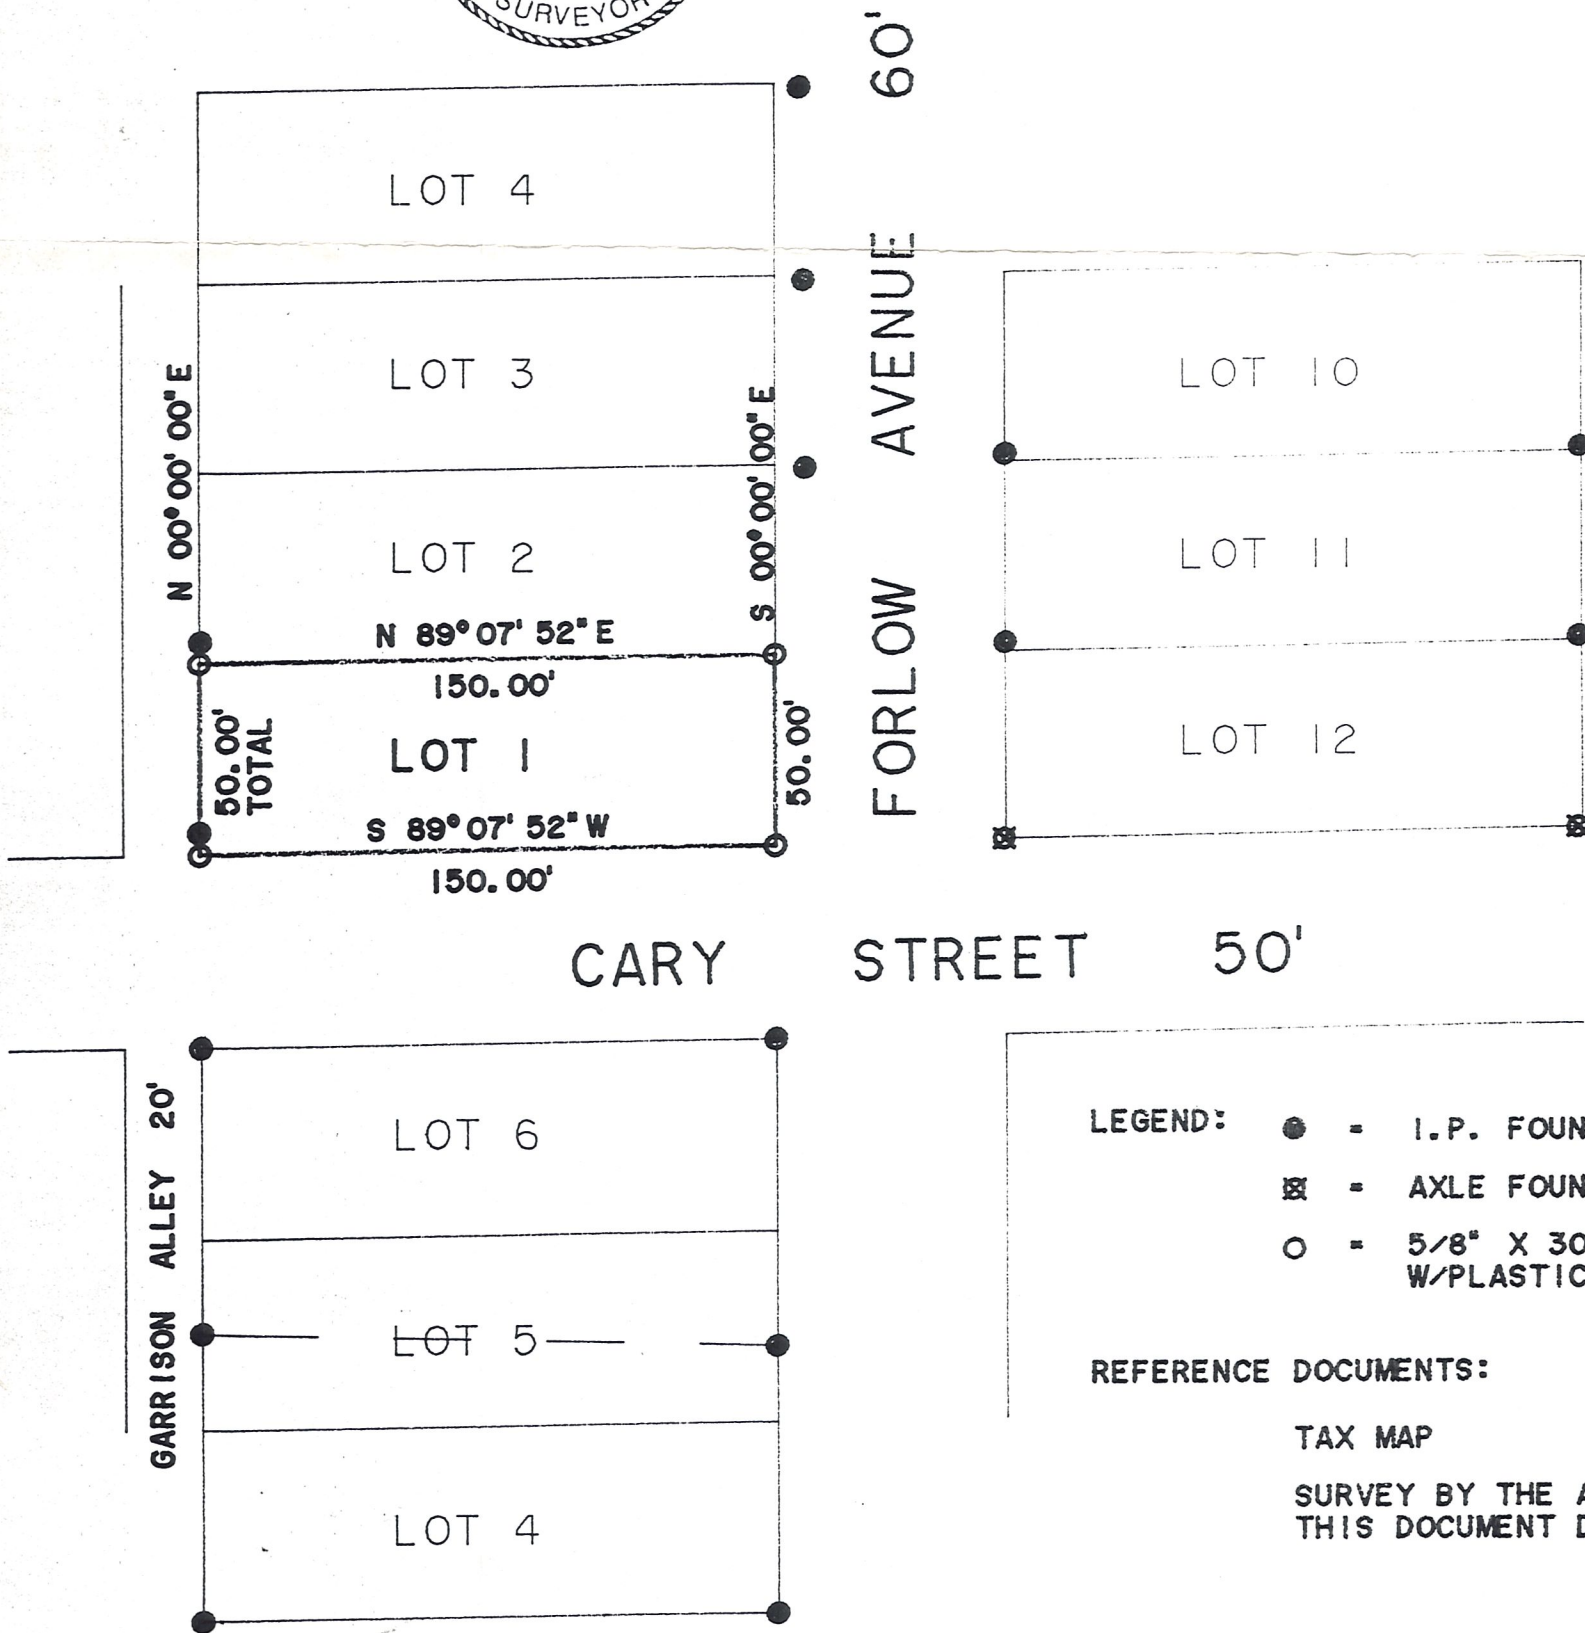

- LEGEND:
- - I.P. FOUND
 - ⊠ - AXLE FOUND
 - - 5/8" X 30" RE-BAR W/PLASTIC I.D. CAP SET

REFERENCE DOCUMENTS:
 TAX MAP
 SURVEY BY THE AUTHOR OF THIS DOCUMENT DATED 2/26/92