


VILLAGE OF MILLERSBURG
 LOTS 578, 579 & 580
 HOLMES COUNTY, OHIO
 (HARDY TOWNSHIP)

SURVEYED FOR: STEVE McCROSSIN

REFERENCES

- O.R. VOL. 167 PAGE 403
- O.R. VOL. 185 PAGE 722
- O.R. VOL. 195 PAGE 752
- PLAT VOL. 19 PAGE 498
- BEARINGS FROM PLAT VOL. 19 PAGE 498

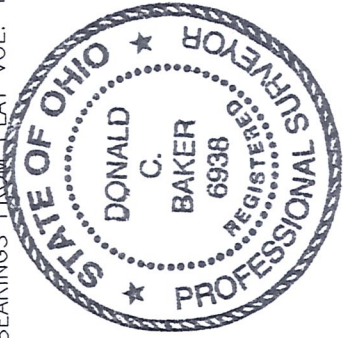

I CERTIFY THIS SURVEY TO BE CORRECT
 TO THE BEST OF MY KNOWLEDGE.


Donald C. Baker
 DONALD C. BAKER

P.S. 6938

DATE: JUNE 28, 2007

JDD/AEG

FILE NAME: WORK3\S-331-07\ERZ

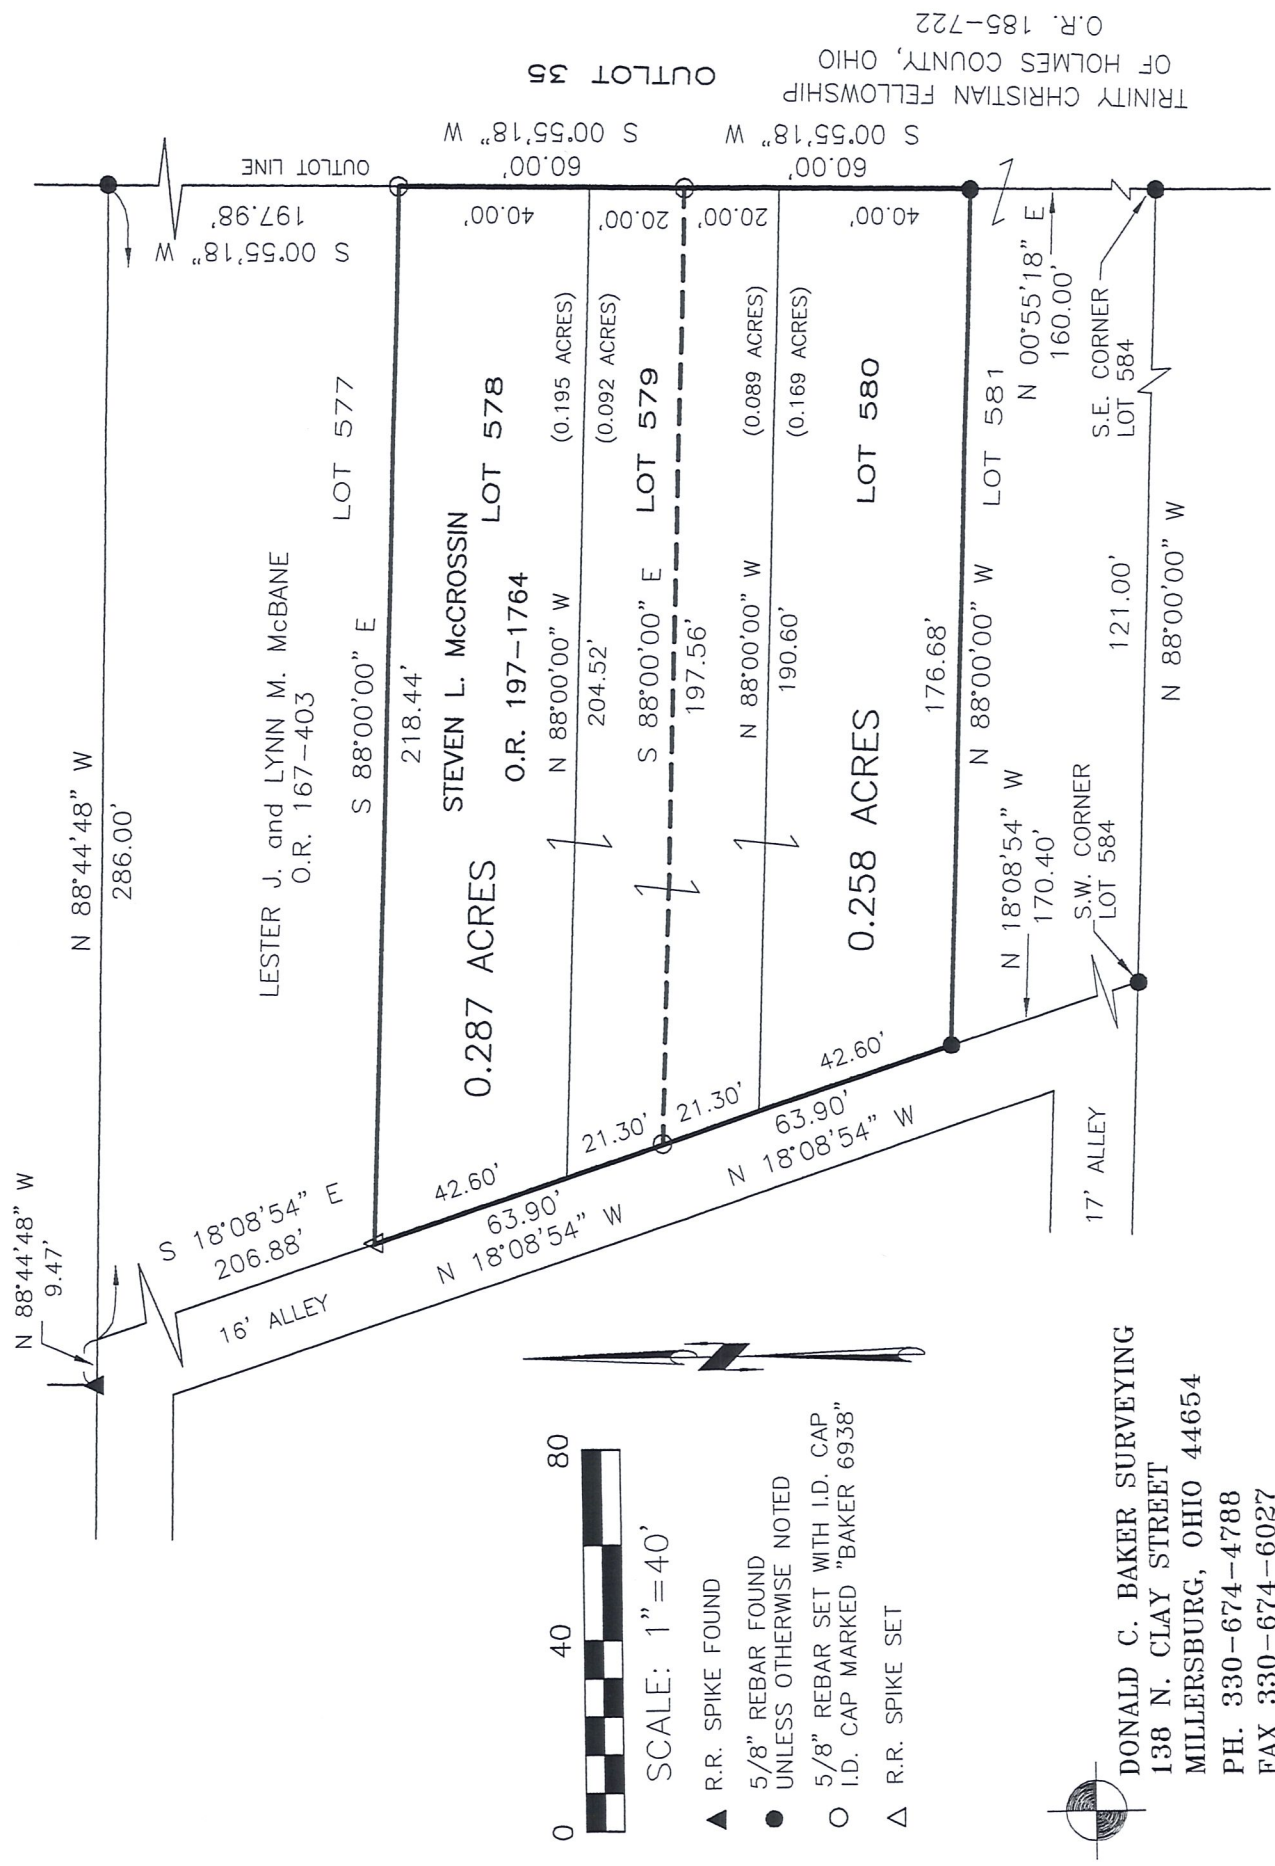

OUTLOT 35
 TRINITY CHRISTIAN FELLOWSHIP
 OF HOLMES COUNTY, OHIO
 O.R. 185-722



SCALE: 1"=40'

- ▲ R.R. SPIKE FOUND
- 5/8" REBAR FOUND
- UNLESS OTHERWISE NOTED
- 5/8" REBAR SET WITH I.D. CAP
- I.D. CAP MARKED "BAKER 6938"
- △ R.R. SPIKE SET



DONALD C. BAKER SURVEYING
 138 N. CLAY STREET
 MILLERSBURG, OHIO 44654
 PH. 330-674-4788
 FAX 330-674-6027