


Village of Millersburg
Part of
Pleasant View Glass Plant Add. Block 11
(Plat Vol. 1 Pages 357-362)
Hardy Township
1st Qtr. Lot 47
T-9 N; R-7 W
Holmes County, Ohio

SURVEYED FOR: Barb Snyder

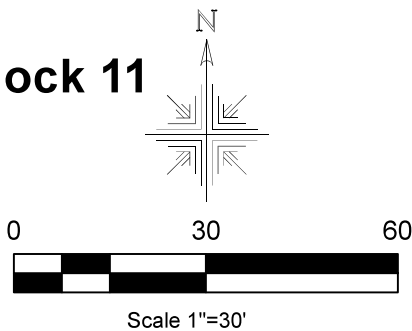


REFERENCES:

Deeds as shown

Plat Vol. 1 Page 357
Plat Vol. 16 Page 468
Plat Vol. 19 Page 1740
Plat Vol. 19 Page 2287
Plat Vol. 19 Page 1413

Basis of Bearing from Ohio State Plane
Coordinate System, North Zone, NAD 83 (2011).
Distances shown hereon are ground distances.
To obtain grid distances multiply by a scale factor
of 0.99994029

- ⊙ Pipe Found
- 5/8" Rebar Found
- ⊘ 5/8" Rebar Found Capped "Baker"
- ◆ 3/8" Rebar Found
- 5/8 inch Rebar Set Capped "Galbraith-8703"
- Point

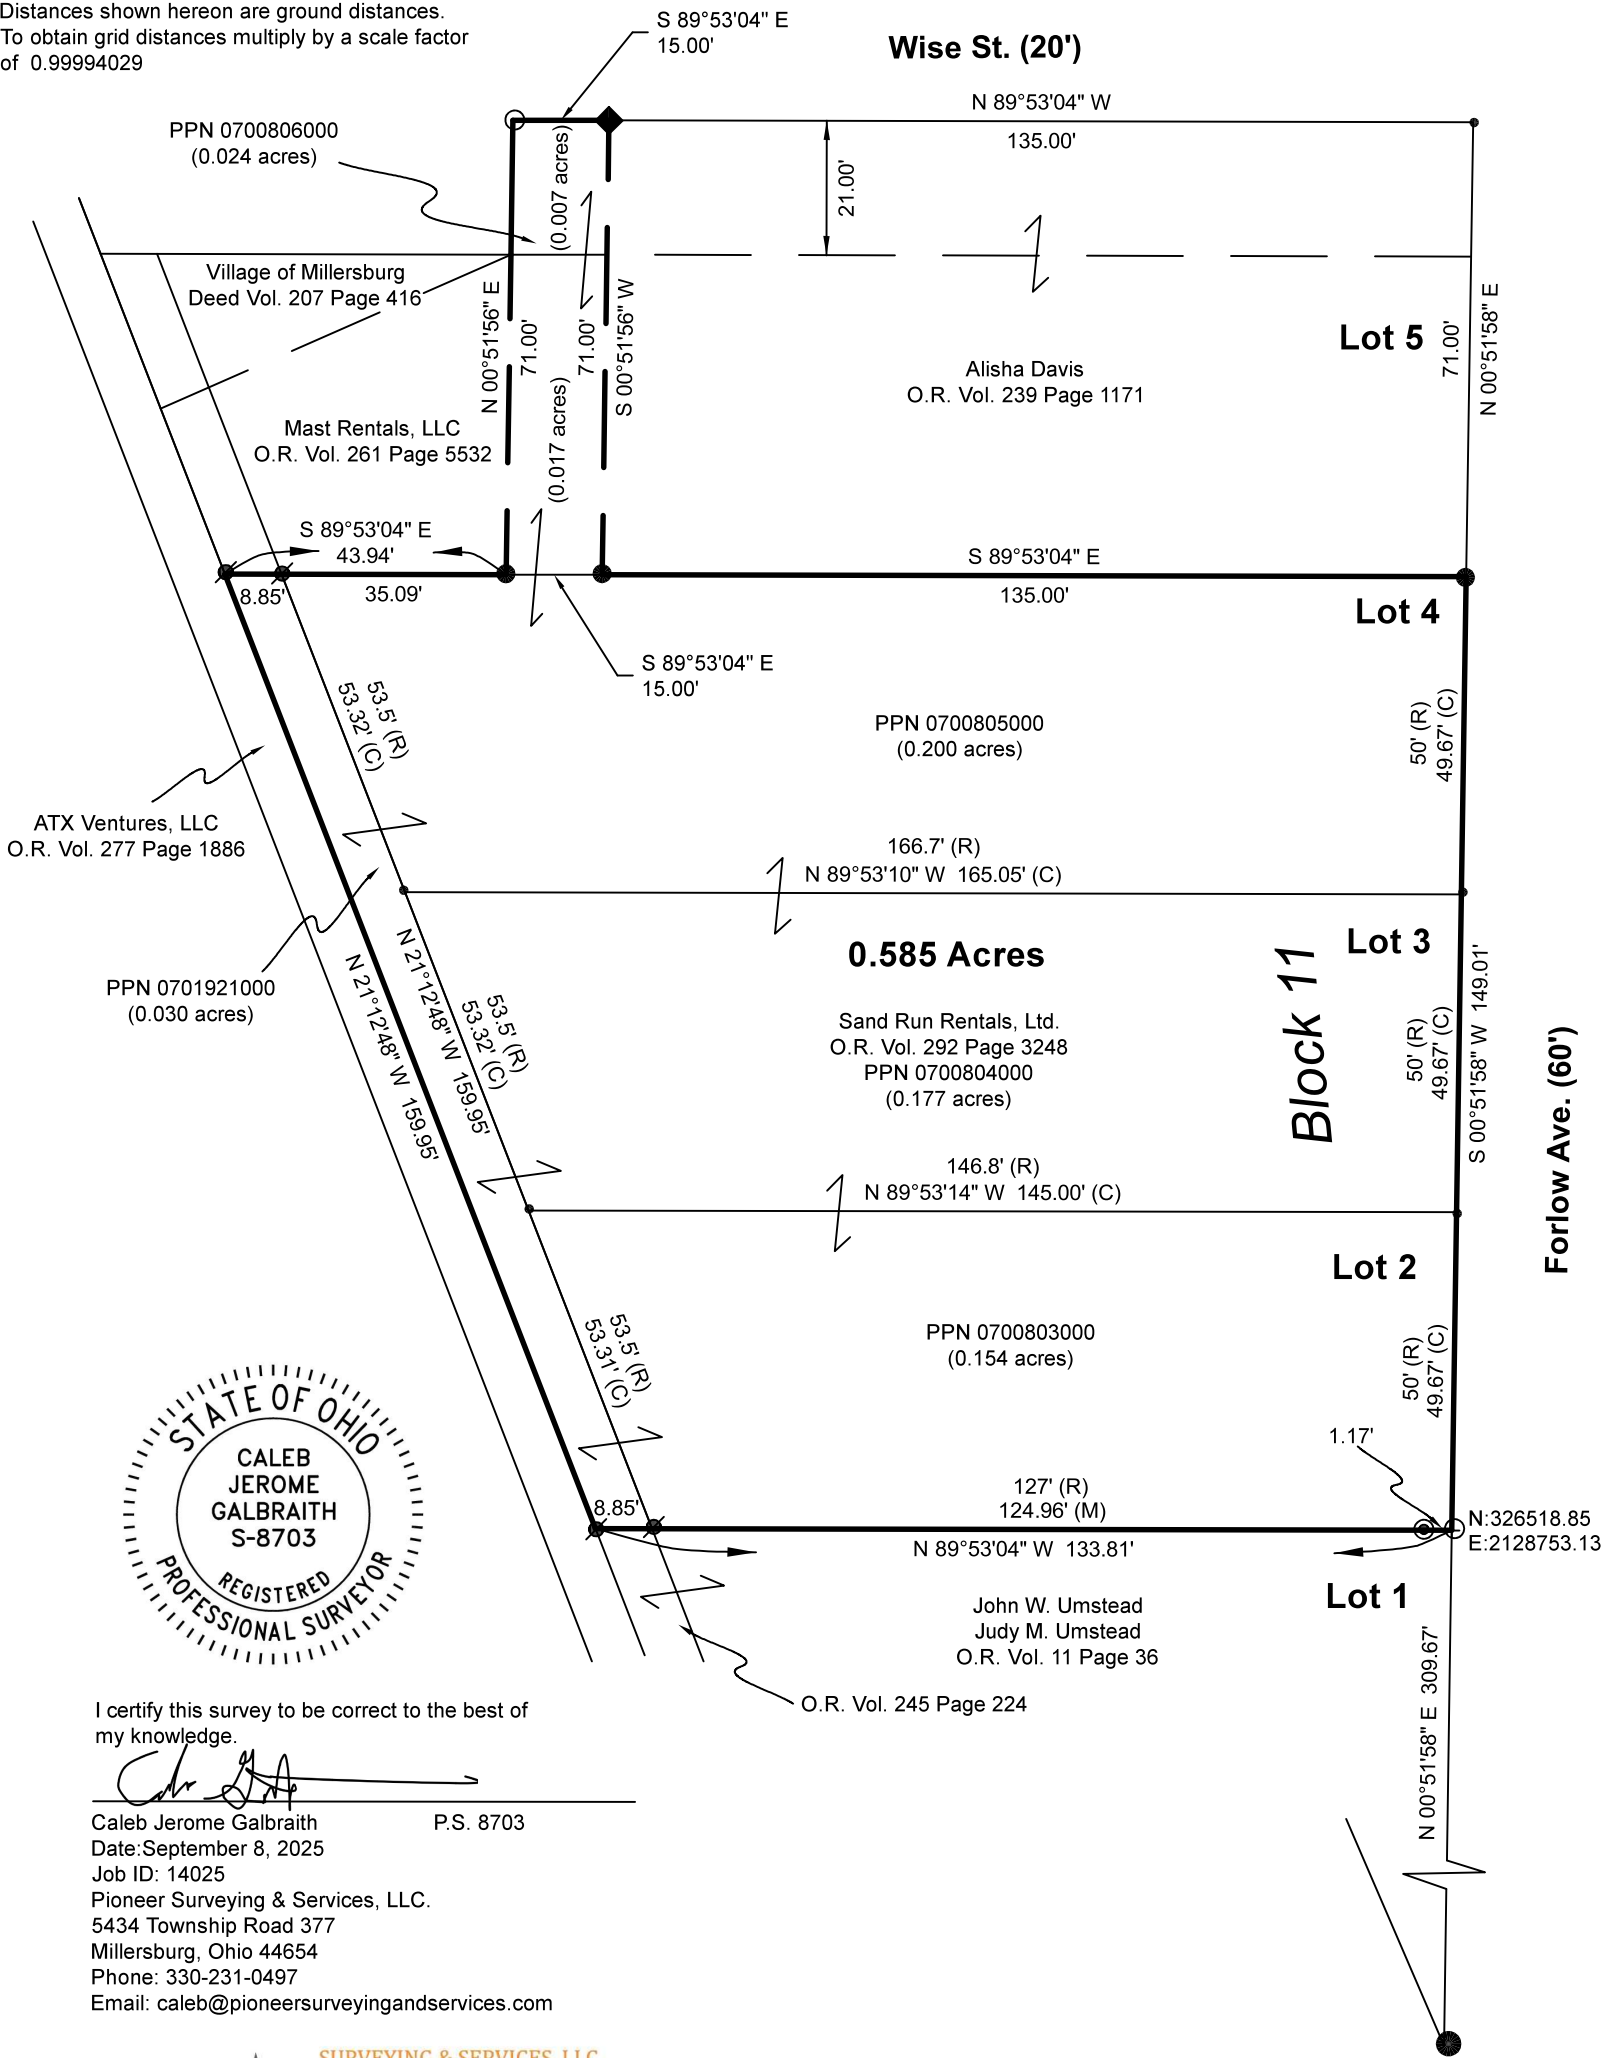

I certify this survey to be correct to the best of
my knowledge.

Caleb Jerome Galbraith
Date: September 8, 2025
Job ID: 14025
Pioneer Surveying & Services, LLC.
5434 Township Road 377
Millersburg, Ohio 44654
Phone: 330-231-0497
Email: caleb@pioneersurveyingandservices.com

