


VILLAGE OF MILLERSBURG
 HARDY TOWNSHIP
 HOLMES COUNTY OHIO

Lots 1 & 2, Block 1, Glass Plant Addition

Surveyed For Paul W. Miller

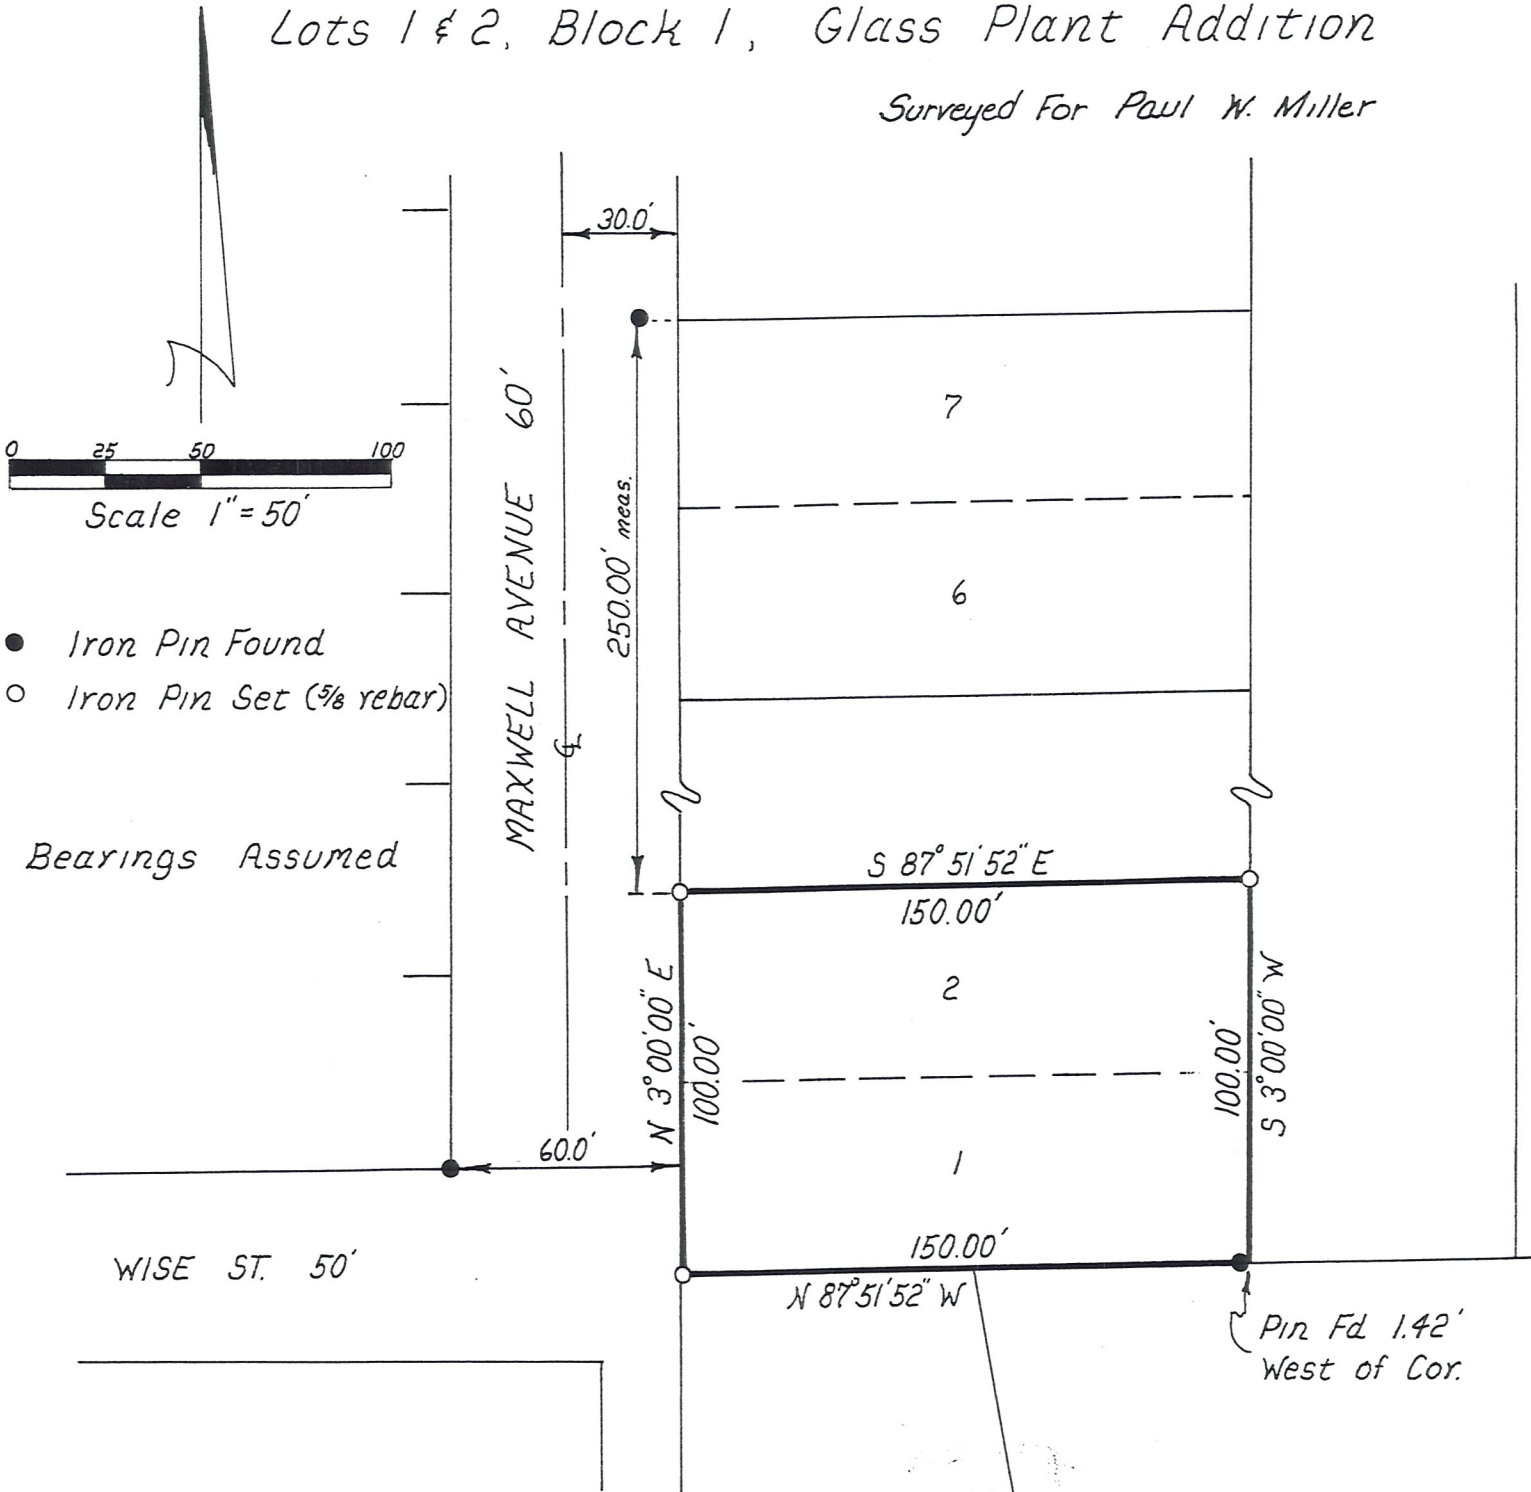

I Certify This Plat To Be Correct
 To The Best of My Knowledge.

William H. Long
 William H. Long

R.S. 6505

